


Survey No. 23

Made for J. H. Layley & Hodge Bros

April 10 11-1901
T. 30 S. R. 5 W.

Begin at Sec^{cor} 14. 15, 22 & 23. T^p 30 S R. 5 W. - Over 20° E.
 Thence East 10.00 ch set post - from which Fir 10 in dia bears N 37 1/2° W 26
 Thence North 6.50 ch set post - from which Ash 10 in dia bears N 73° W 9
 Thence West 2.00 ch set post - from which B Oak 10 in dia bears N 81 1/2° W 10
 Thence North 13.50 ch set post from which W Oak 10 in dia bears S 20° W 48
 Thence West 32.50 ch set post from which B Oak 4 in dia bears S 31 1/2° E 14
 Thence South 20.00 ch set post - from which B Oak 12 in dia bears N 63° W 61
 Thence East 22.50 ch to Sec cor and place of begin Cont 62.30 acres
 Thence I set off 26.40 acres to Charles Hodge, of the West
 end of the tract herein described. to wit
 Starting at the N. W. cor of said 62.30 acres measured East
 14.32 ch set post - from which B Oak 10 in dia bears S 85° W 24
 Thence South 2.00 ch set post - from which Laurel 5 in dia bears N 20 1/2° E 8
 Thence West 14.32 ch to S. W. cor.

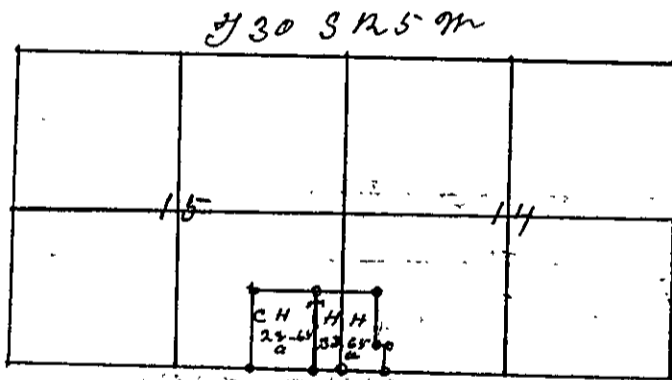

Survey No 24
April 17 1901
T. 29 S. R. 4 W.

Wm Mulkey

Begin at 1/4 Sec. Cor. between Sec 5 and 8 T^p 29 S. R. 4 W. var. 20° E.
 Thence north 20 ch, set post no. 1 marked C.S. This is same as the
 the S.E. corner of school lot formerly sold to school Dist. no 53
 Thence west 2 ch, set post marked C.S. Thence N 2.00 ch, set
 post C.S. Thence East 2.00 ch, set post C.S. Thence South 2.00 ch
 to the place of beginning, Cont, 40/100 Acre
 Thence from post No. 1. North 10 ch, set post No. 2
 marked C.S. Thence East at 3.25 ch North Myrtle Creek 50 ft
 wide Course, S. M. 9 ch set post No. 3 - From which:
 a Fir 14 in. dia. bears N 32° E. 16 ch
 Thence South 23° E. 4.00 ch, set post No. 4.
 Thence from post No. 2 also mentioned North 10.00 ch, set post No. 5 C.S.
 From which (a) same as dia. bears N 82° E. 31 ch.