


County Surveyor's Record, Douglas County, Oregon

Survey No. 34

Made for

19.45 set past C.S. - from which - a Fir 18 in dia bears N 8° 15' 37" E
 a Fir 20 in dia bears S 24° W 88 links
 thence from N.W. cor. Sec. 26, N 89° 25' E, 21.30 set past C.S. from which -
 a Fir 10 in dia bears N 53° 15' E 41 links, a Fir 10 in dia bears S 130° E 20 links
 thence S 4° 30' E, random through center of N.W. 1/4 Sec. 26, 39.58 intersect
 E-W line through center of Sec. 26, 36 links E of 1/4 mile past
 thence N 3° 59' W on true line through center of N.W. 1/4 Sec 26
 19.79 set past C.S. in center of N.W. 1/4 Sec 26 from which
 a pine 8 in dia bears N 51° 30' E 16 links, a Fir 12 in dia bears S 5° 45' E 13 links

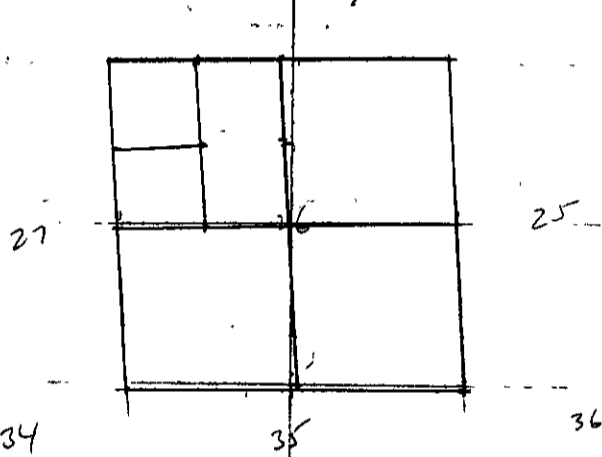

Survey No 35

Made For U.S Flourmox

July 27-1902

T.275. R.7 W.

Pg 285

FOR CORRS.

cor

cor

Set past cor Secs 16, 17, 20 and 21, T.275, R.7 W. as per original field notes
 thence East - var - 20° E - 1.79 set past marked C.S. from which -
 a W. Oak 6 in dia bears N 70° 15' W, 54 links, a W. Oak 8 in dia bears N 31° 45' E 40 links
 thence N, 14.19 set past C.S. from which - a Fir 36 in dia bears N 78° 30' W 5 links
 a Black Oak 10 in dia bears S 18° 45' W 53 links. thence East, 40.51 set past
 marked C.S. from which - a W. Oak 8 in dia bears N 2° 45' W 42 links, a W. Oak
 8 in dia bears South 53° 15' W 17 links
 thence N, 8.70 set past marked C.S. - from which - a W. Oak 8 in dia bears
 S, 47 links a B. Oak 8 in dia bears N 36° 15' E, 30 links
 thence West, 30.20 set past marked C.S. from which - a B. Oak 36 in dia
 bears West 58 links, a white Oak 16 in dia bears N 11° W 28 links
 thence North 25.00 set past C.S. from which - a B. Oak 36 in dia bears S 57° E 147 links
 a W. Oak 10 in dia bears N 57° E 210 links
 thence East 7.95 set past C.S. from which a Fir 16 in dia bears N 10° E 40 links
 a Fir 14 in dia bears N 68° 30' W 53 links
 thence East 19.91 set past C.S. from which a B. Oak 36 in dia bears S 49° W 27 links
 a B. Oak 14 in dia bears S 49° E 27 links