


Survey No. 35

Made for

Thence East 20.00 Set post C.S. from which - a B. Oak 24 in dia bears S 73° 30' W 227 links
 a Black Oak 24 in dia S 30° N, 284 links,
 D.M. Franklin, and Alex McPherson - Chainmen - Sworn

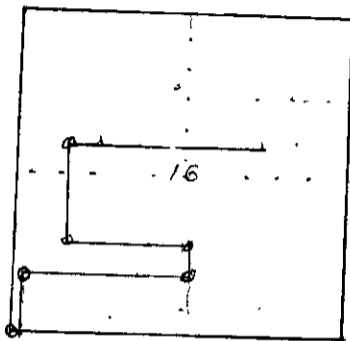


Survey No 36

Made for Sanford Caldwell

Jan 29 1902

T. 27 S. R. 6 W.

John Preschern, and Wancel Preschern Chainmen Sworn -
 Beginning at 1/4 sec cor. between Secs 18 & 19 Tp 27 S. R. 6 W.
 thence West - (var 19° 36' E) - 12.81 ch Set post marked C.S.
 from which, a B. Oak 16 in dia bears N 55° 15' W 114 links. a B. Oak
 18 in dia bears N 47° E 1.14 links
 Thence North 40.00 Set post marked C.S. from which a Black Oak
 18 in dia bears S 48° 15' E. 85 links. a W. Oak 8 in dia bears S 37 1/2° W 79 links
 Thence East 12.81 Set post C.S. from which a B. Oak 18 in dia bears S 32 1/4° W 92 links
 a Black Oak 18 in dia bears East 43 links
 Thence S. 40.00 ch to place of beginning. Cont 51 25/100 acres

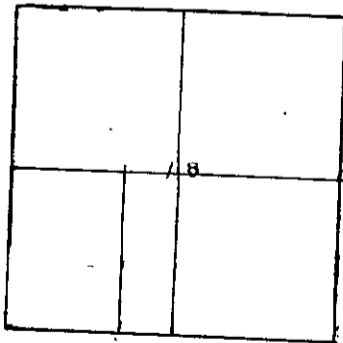

Survey No 37

Made for John R. Daniels

T. 27 S. R. 6 W.

Geo Petriquin and Ralph Petriquin - Chainmen - Sworn -
 Beginning at 1/4 sec 7 and 18 Tp 27 S. R. 6 W. - var 19° 36' E -
 Thence North 20.00 Set post C.S. from which -
 a B. Oak 18 in dia bears N 85° E 41 links. a B. Oak 24 in dia bears S 1° E 58 links