


County Surveyor's Record, Douglas County, Oregon

Survey No. 38

Made for C. E. Boyue

July 3 1902  
T. 29 S. R. 4 W.

A. M. Akers and C. D. Gallin. Chainmen - Sworn  
Set post C.S. cor. Secs 13, 14, 23 and 24 as per original field notes 54.29 S. R. 4 W.  
Thence South 40.00. (var 19°30'E) could find no sign of any other  
Survey. Old residents claim no 1/4 sec cor. has been established, same by  
Government Survey. 3 set post marked C.S. from which  
a Fir 20 in dia N 44°30'E. 50 lks. a Fir 16 in dia bears S. 10°30'W 23 lks.  
Set S.E. cor. Sec 24 Tp 29 S. R. 4 W. as per field notes -  
Thence N (var 19°30'E) 19.71 set post marked C.S. from which -  
a cedar 16 in dia bears N 24°45'E. 307 lks. a cedar 14 in dia bears N 13°15'W 316 lks.  
39.43 to 1/4 sec cor. on East boundary Sec 24, set same as per government  
field notes  
Thence S 68°30'W on random through center Sec 24, 68.25 intersect 11 links  
South of 1/4 sec post on west boundary Sec 24. Thence N 68°36'E on true line  
through center Sec 24, 30.00 set post C.S. from which  
a cedar 8 in dia bears N 32°E 19 lks. a cedar 12 in dia bears S 71°30'W 16 links  
40.00 set post from which a cedar 6 in dia bears N 20°E 5 links  
a cedar 10 in dia bears N 64°30'W 11 lks. a Fir 8 in dia S 53°W 46 "  
a Fir 8 in dia bears S 66°45'E 26 lks.

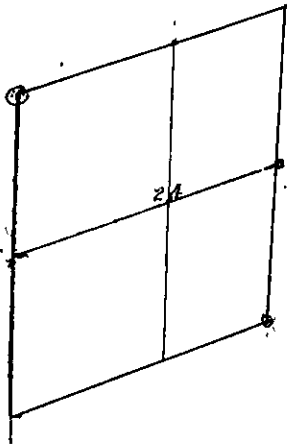

Survey No 39

Made for J. F. Stephens

July 11 1902  
T. 29 S. R. 4 W.

B. S. Nyer and J. H. Redifer Chainmen - Sworn (var 19°30'E)  
Set post N.E. cor. S.R. Stephens S.R.C. No 38 in Tp 29 S. R. 4 W - per original field notes -  
Thence West 29.99 set post C.S. from which - a Fir 24 in dia bears S 40°W 323 lks  
a cedar 14 in dia bears S 64°E 210 lks  
Thence South 20.09 set post C.S. from which a W. Fir 20 in dia bears S 49°W 7 lks  
a Red Fir, 36 in dia. bears S 83°15'E 20 lks.  
26.67 set post C.S. from which, a cedar 12 in dia bears N. 29°E 138 links  
a cedar 20 in dia bears N 18°50'W 190 links  
J. A. McDonald hence bears S 28°E 4 W. H. Briggs