


County Surveyor's Record, Douglas County, Oregon

Survey No.

Made for C. H. Allen

Sec 30 T. 27 S. R. 7 W. N. M.

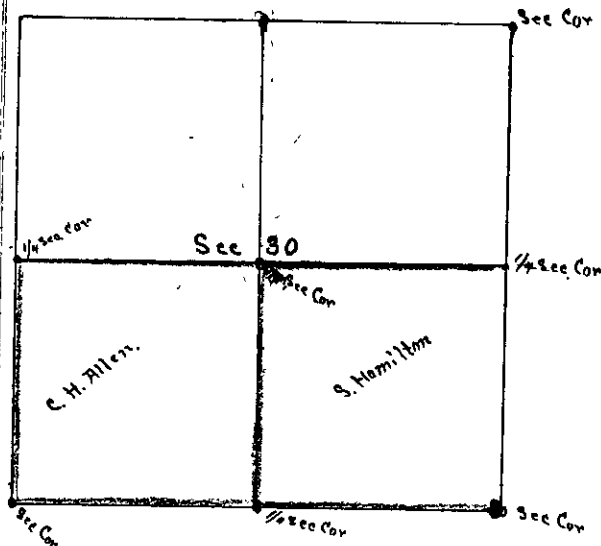

C. L. Goodman and L. R. Williams Chasmen
sworn.

The line between Sec 30 & Sec 19 not having been
previously run and 1/4 sec corner established, I
went to N. E. Cor of Sec 30, Th west on Random line
and failed to find N. W. Sec Cor, or any evidence
of a blazed line. Found a spring supposed to
be the one mentioned in Field Notes (as it is the
only one in neighborhood). Then went to Cor of

Secs 29 & 30, 31 & 32 found all witness trees and as stake was destroyed set new stake, th on Random
bet 30 & 31 to SW. Cor of 30. Found stake rotted off, witness trees, and set new stake, Th ^{East} on True line
bet 30 & 31 and at 41.20 chs found unmarked stake, an Oak tree (which had already been blocked out) and
an Alder corresponding in course & distance to the Oak & Laurel mentioned in Field Notes as witness
trees Set 1/4 Sec Post. Th North 40 00 chs. & set temporary center post. I then went to the
1/4 Sec post bet Sec 29 & 30, found rotted stake, both witness trees and set new 1/4 Sec post
th west 81.20 ch and intersected Township line 40 links N. of 1/4 Sec corner, Th. East on
true line and set center Section post at 41.20 chs which was also point of intersection
of line run from 1/4 Sec corner between Sec 30 & 31 marked four witness trees as follows.

a Fir 12 ⁱⁿ in Dia	bears North 25° E	distant 29 links	} For center stake drove into the ground an Iron Stake 1/2 ⁱⁿ in Dia. and 2 1/2 ft in length. All stakes were set and
a " 12 " "	" South 74° W	" 20 "	
a " 16 " "	" South 46° W	" 30 "	
a " 16 " "	" North 15° W	" 40 "	

trees marked in presence of C. L. Goodman, L. R. Williams, Thomas Kirkade and C. H. Allen.
This survey was made to divide the S E 1/4 & S W 1/4 of Sec 30 T. 27 S. R. 7 W. N. M. at the
request of C. H. Allen. Notice was served on S. Hamilton and written acceptance
of same obtained. Survey begun on Sept 17th 1906 & completed Sept 22nd 1906.

H. C. Brown
Dep. Co. Sur.