


Survey No.

Made for C. Durling

T25S 1. 11

T25S, R. 6 W. W. M.

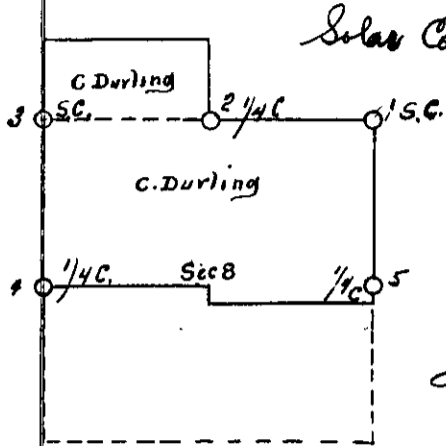

Solar Compass

Correct Variation 21° 00'

Mar 17 '09

Began survey at the N.E. corner of sec. 8
I set stone corner 6" x 10" x 20" for sec. 4, 5, 8 & 9
and note old Gov. B.T.'s is standing.

Thence west from this corner on old Gov. monument line, at

39.75 I fell 46 lbs North of $\frac{1}{4}$ corner. I correct back on true line and set stakes at every 20 rod point.

From the $\frac{1}{4}$ corner bet. sec 5 & 8 I run random line North 44° W
2000 and set temporary stake. From this temporary stake I run random line West at

40.00 Intersect R. O. Lehmann fence.

Mar 18 '09

Began at the $\frac{1}{4}$ corner on the west side of sec 8 and run random line East, at

70.00 set temporary stake for center of section 8. Thence I run South
5.35 to a ~~blaze~~ line on the N. body of the Van Piper D.P.C. Thence East on the North body of the Van Piper Claim at

40.14 I fell 6.17 chs. South of the $\frac{1}{4}$ corner on the E side of sec. 8

Began at the $\frac{1}{4}$ corner on the E side sec 8 and run North on random line at

40.04 I fell 4 lbs E of corner previously set. I correct back on true line and set stakes at every 20 rod points

Reestablishments

Cor 1 Set stone of sand 6" x 10" x 20" and note old B.T.'s standing

Cor 2 Found stand stone set and one B.T. still standing on the S.W.

.. 3 Set W. oak post 4" x 4" x 3' from which

R. Fir 8" dia. hrs N 49° 40' E 31 lbs
W. oak 6" " " N 23° 45' W 45 "
R. Fir 5" " " S 53° 40' E 4 "
R " 5" " " S 28° 30' W 25 "

One old B.T. found standing

Cor 4 Set W. oak post 4" x 4" x 3' from which

R. fir 8" dia. hrs. N 52° 00' E 16 lbs
R " 50" " " N 60° 00' W 27 "

One old B.T. found standing

Cor 5 Found stone 2" x 8" x 16

Old bearing tree on S.E. still standing

Remarked for other tree a white oak 40" dia hrs S 26° 30' W 53 lbs

Surveyed and recorded by
H. B. Lehmann
Dep. Co. Sur.