


Survey No.

Made for

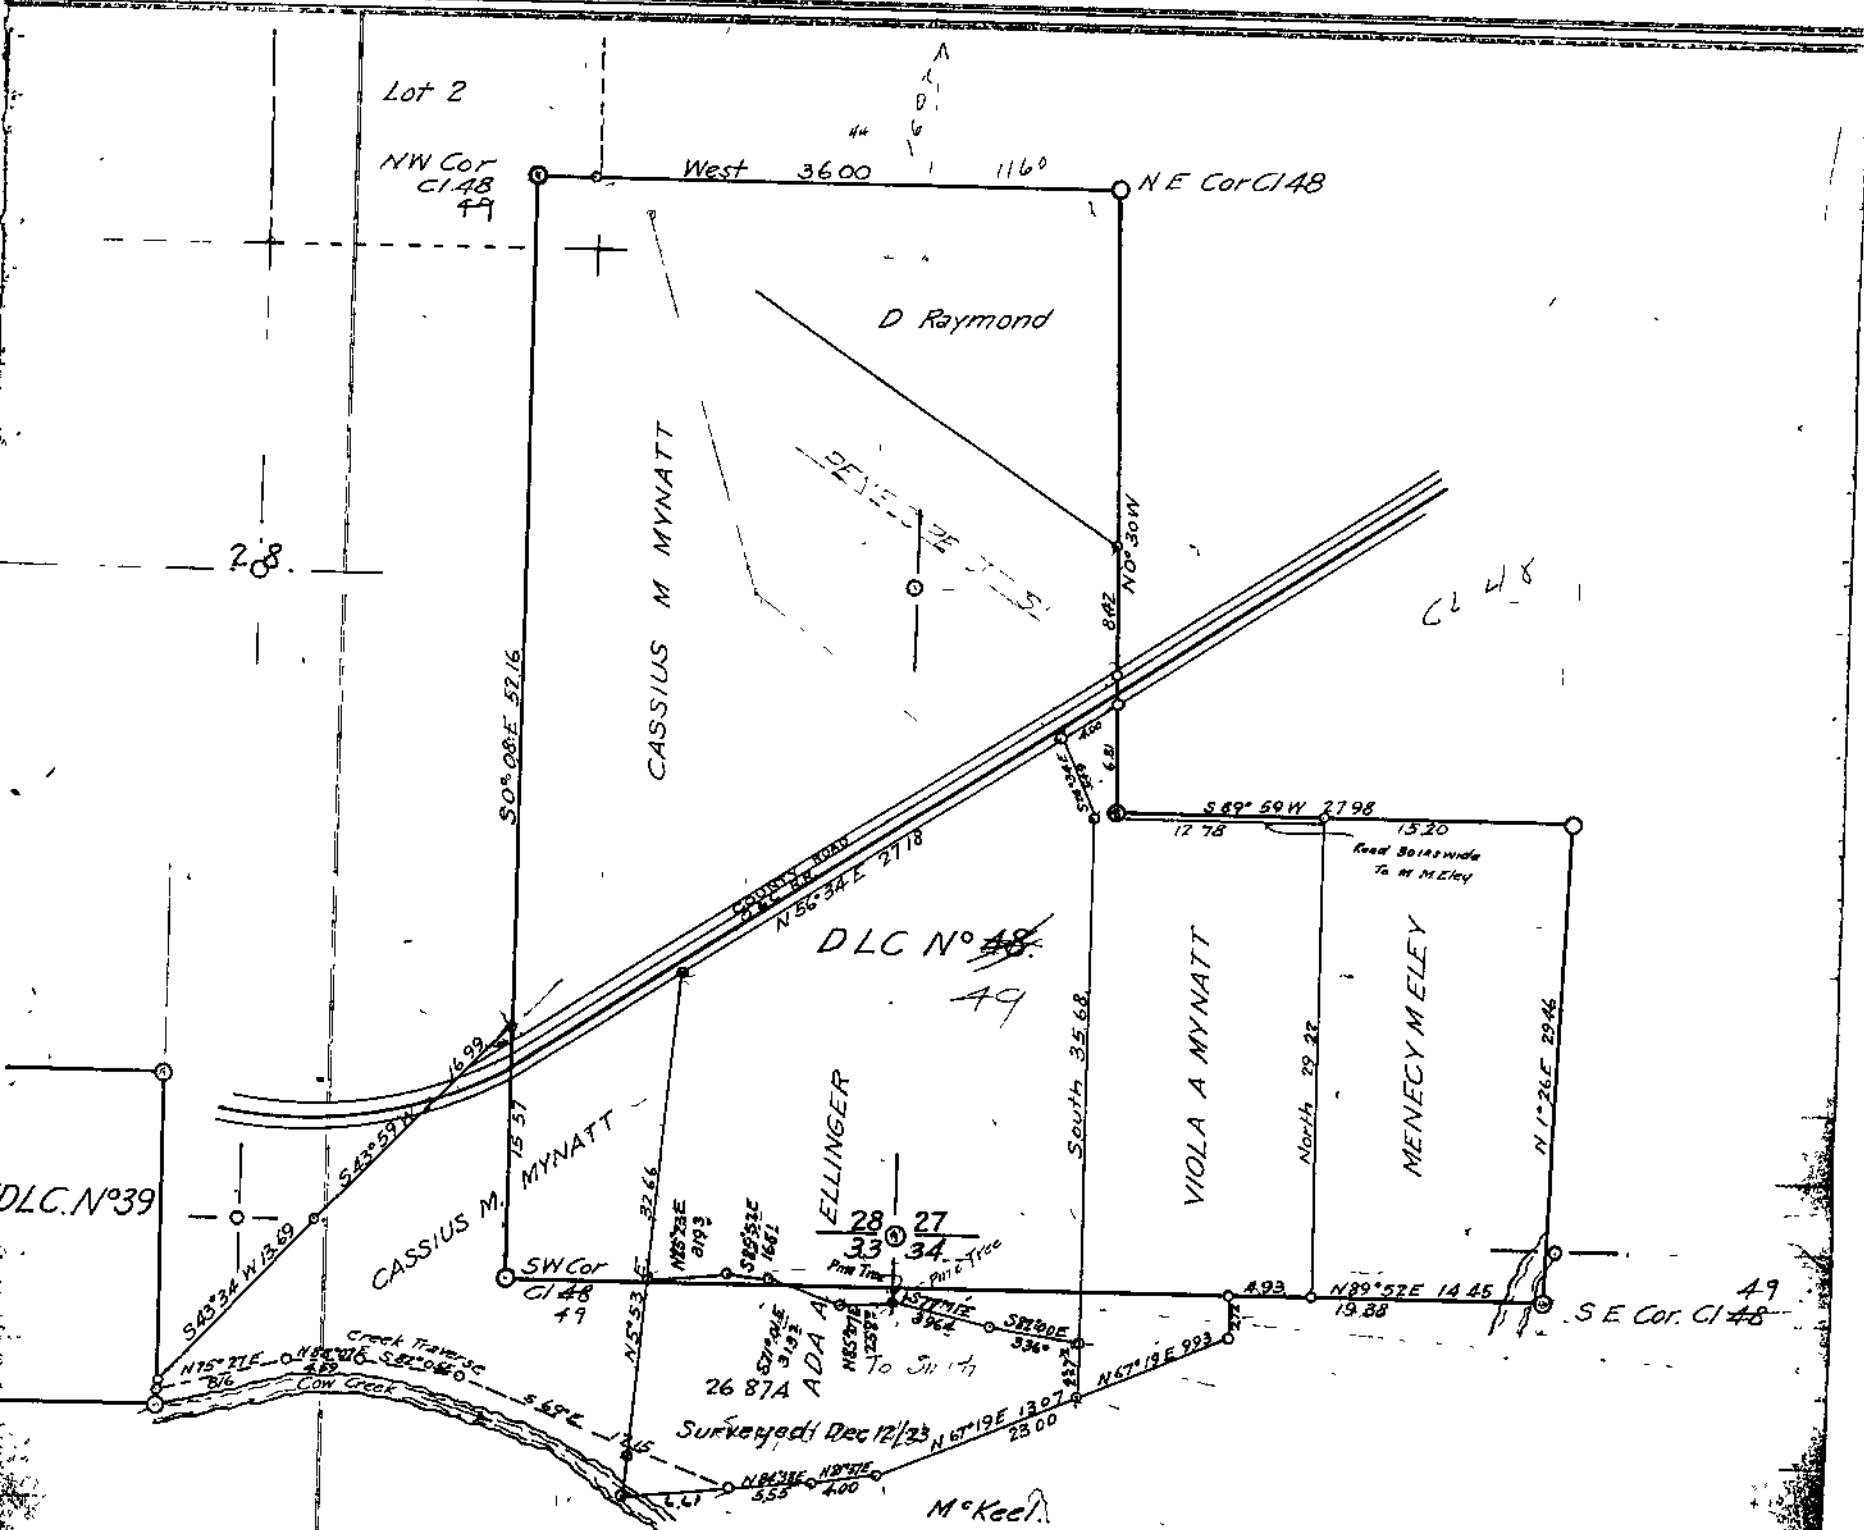

Corners Recorded.