

County Surveyor's Record, Douglas County, Oregon

Survey No.

Made for *T. B. Burnett & S. Strickler.*

*Sec. 25
T. 28-6*

Feb 24 1921

Survey to establish line between lands of T. B. Burnett and S. Strickler, who agree to the line established as follows; Beginning at the $\frac{1}{4}$ sec cor between secs, 25 & 26 T. 28 S. R 6 W., C. F. Mathews, A. A. Frost and Frank Cain, Chainmen. From the above mentioned $\frac{1}{4}$ Cor I run; --Var. assumed, 21°E.-- North,,, 80.22 chains, Intersect 9 links West of the $\frac{1}{4}$ sec.cor. between secs 24 & 25, from this $\frac{1}{4}$ post I run;

S.0°04'W, 40.11 chains, and set a stone 6"X 12"X 16" marked X


8" in the ground, From which;

A, W, Oak 24" in dia, marked C+S, bears, S.80°W. 62 links
 A, B, " 32" " " " " " " N.76°35'W, 120 "
 --Var. at this point, 21°25'E-----

From the above point I run a true line;

West,,, 40.14 chains, to the $\frac{1}{4}$ Sec post between Secs, 25 & 26.

All lines run with transit, measurements with standard Chicago steel tape,,, Chainmen sworn.,-----

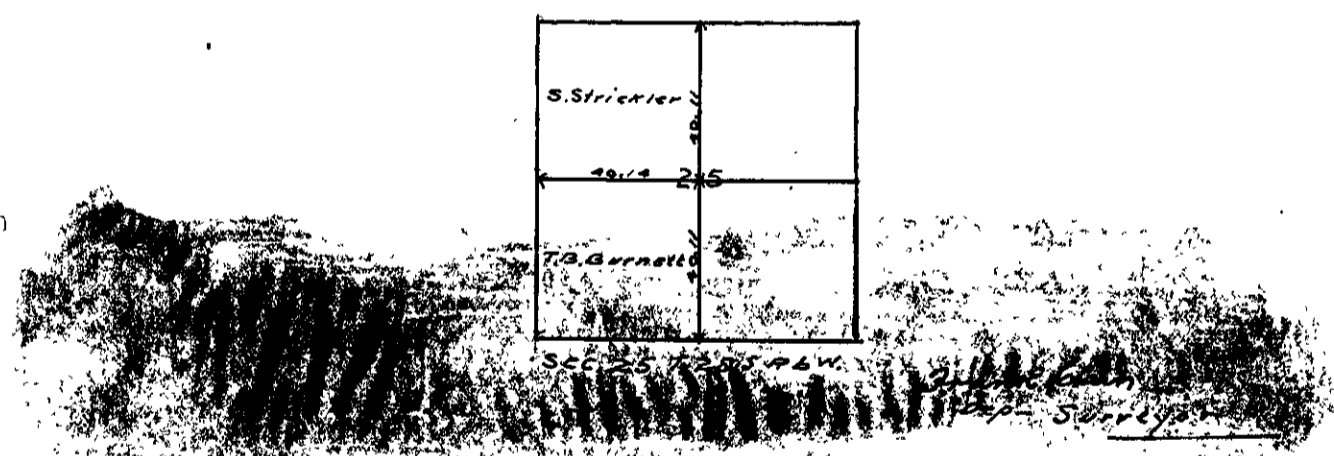

Recorded by F. C. Frear, County Surveyor