

Survey No. 3-41 Made on Mar 2-1926

In Town 29 Range 8-9 Sec. 25-30-31 36

Made for M.W. Chapman


Purpose of Water filing and deed description

Survey No. Made on

In Town. Range Sec.

Made for

Purpose of

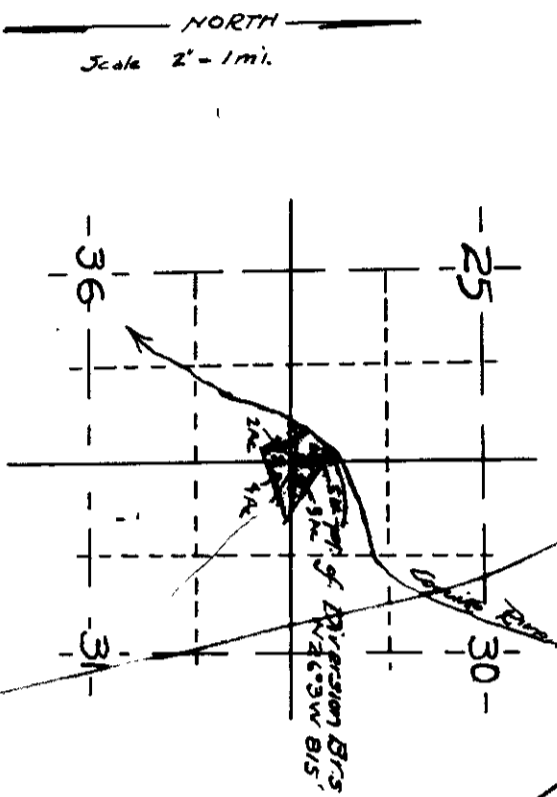

MAP OF CHAPMAN IRRIGATION SYSTEM

SEC 30-31 T 29 S R 8 W W.M.
SEC. 25-30 T 29 S R 9 W W.M.
Douglas County Oregon


H.L. Epstein County Surveyor

CERTIFICATE OF SURVEYOR

I H.L. Epstein of Roseburg Oregon do hereby certify that this map was made from notes taken during an actual survey made under my immediate supervision on March 2-1926 and that it correctly represents the works described in the accompanying application together with the streams and other ditches in the immediate vicinity.

H.L. Epstein
Registered Professional Engr.

Oregon No 1011
Date of Repts. No. 8-1920

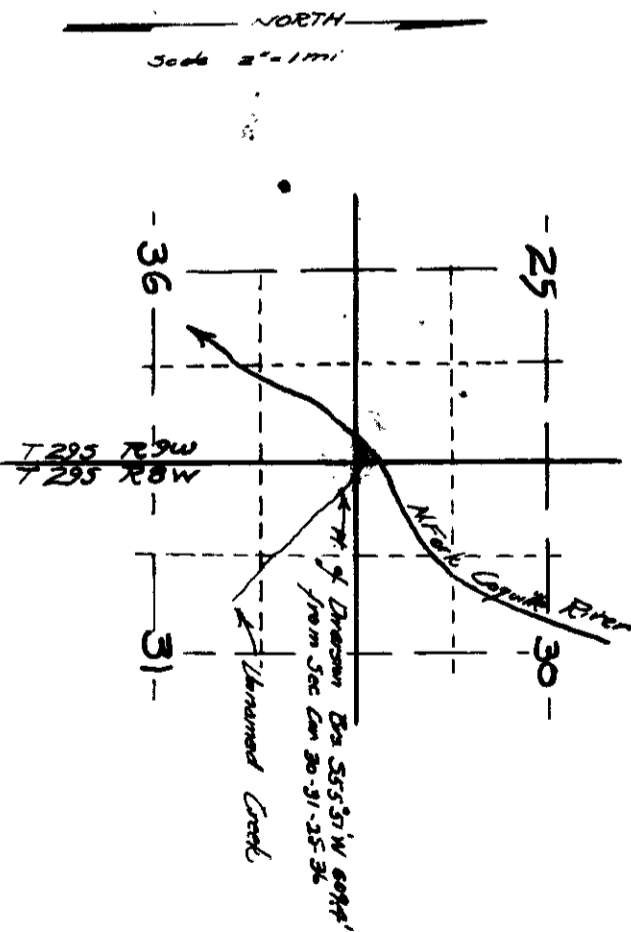

MAP OF CHAPMAN WATER SYSTEM

SEC 30-31 T 29 S R 8 W W.M.
SEC. 25-30 T 29 S R 9 W W.M.
Douglas County Oregon

H.L. Epstein County Surveyor

CERTIFICATE OF SURVEYOR

I H.L. Epstein of Roseburg Oregon do hereby certify that this map was made from notes taken during an actual survey made under my immediate supervision on March 2-1926 and that it correctly represents the works described in the accompanying application together with the streams and other ditches in the immediate vicinity.

H.L. Epstein
Registered Professional Engr.

Oregon No 1011
Date of Repts. No. 8-1920