


# COUNTY SURVEYOR'S RECORD, DOUGLAS COUNTY, OREGON

BUSHONG & CO. PORTLAND, ORE. 87545

Survey No.	Made on	Survey No.	Made on
In Town.	Range	In Town.	Range
Made for	Sec.	Made for	Sec.
Purpose of		Purpose of	

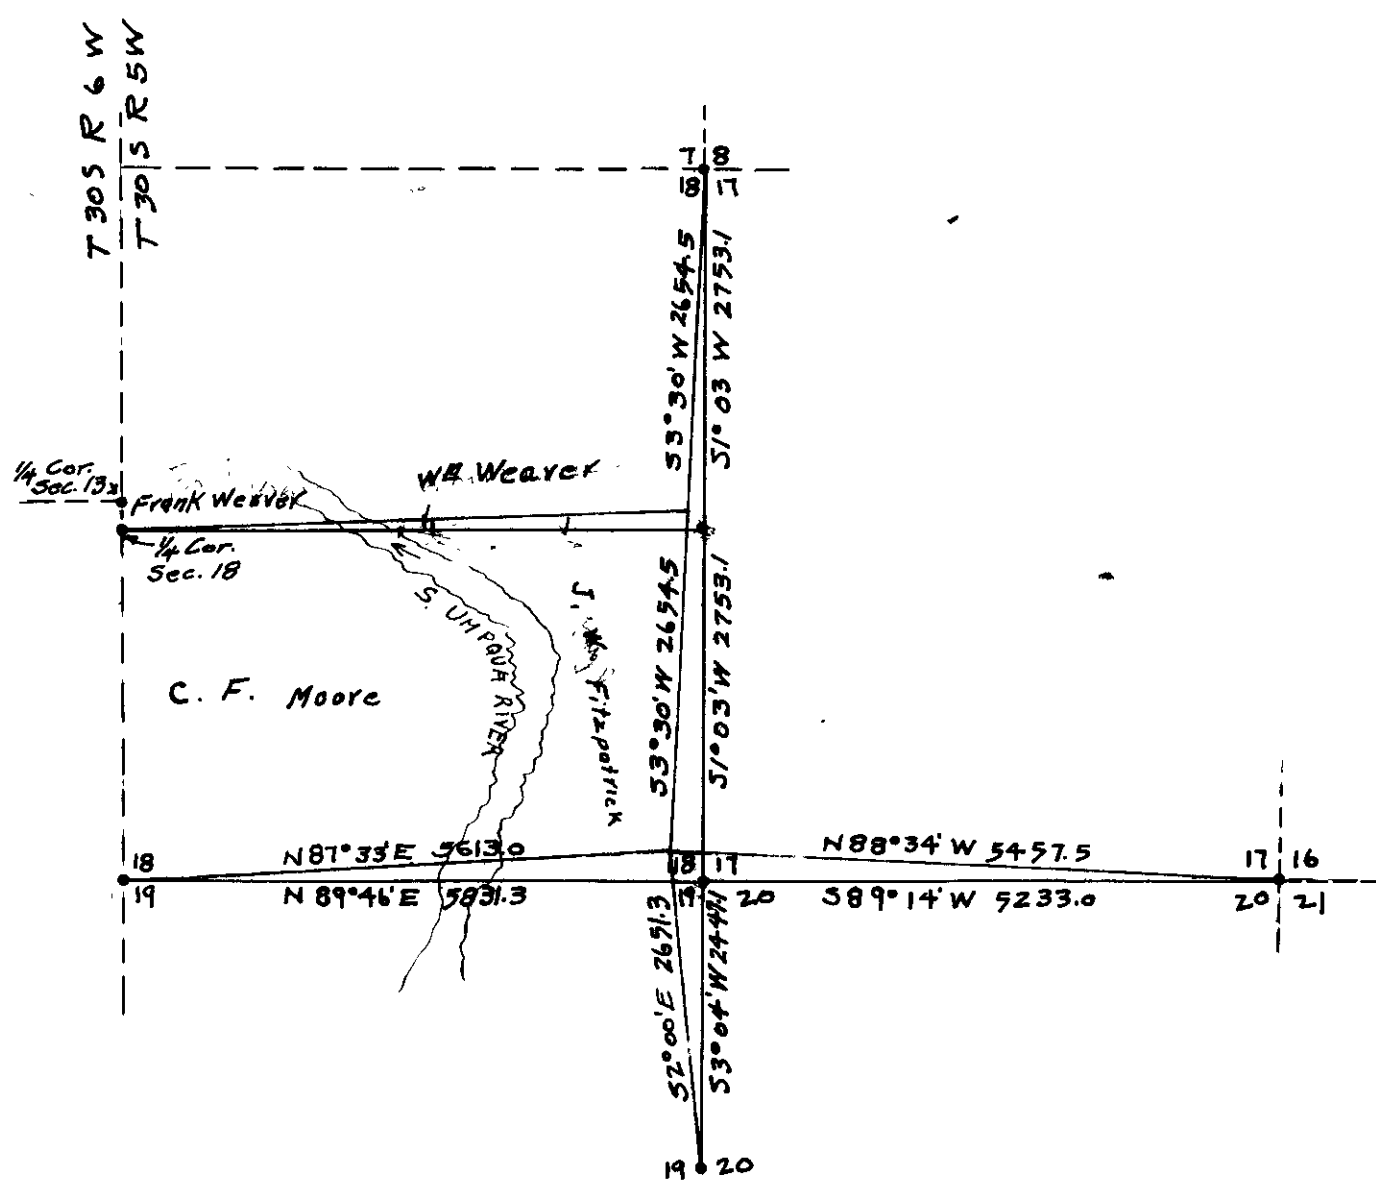

Solid Black show lines run.  
 Orange line shows position of lines if Cor.  $\frac{18}{17}$ / $\frac{19}{20}$  should be reset by proportional Distances.