


COUNTY SURVEYOR'S RECORD, DOUGLAS COUNTY, OREGON

Survey No. Made on Sept. 25, 26 1940
 In Town 32 S Range 4W Sec 1
 Made for Claire Lumber Co.
 Purpose of Lines
 Arthur Boyer
 Ted Shellaharper
 V34 E22

Survey No. Made on Jan. 17th. 1941.
 In Town 28 S. Range 6 W. Sec 29
 Made for Bert Lawrence.
 Purpose of To cut off 2.23 acres from Lot 10
 Miller's Dillard Sub-division.
 Arthur Boyer.
 Exx V. 34 E. 36.

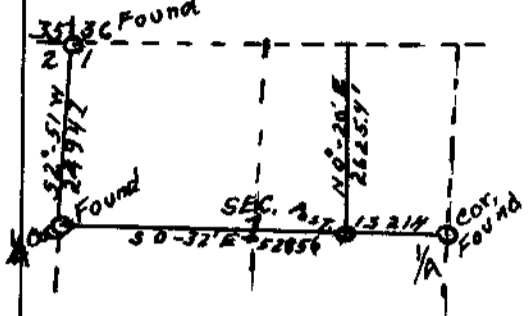


BEGINNING survey at the corner to sections 35-36 2-1 on the Township line between Township 31 & 32, which corner was found in good shape, I ran south on an angle line with transit and chain and found the $\frac{1}{4}$ section corner between section 1 & 2. The beginning of the true line is $92^{\circ} 51' W$. with a distance of 2494.7 feet.

From the $\frac{1}{4}$ Corner on the West side of Section 1, I ran East on transit line and at 5285.4 feet my line fell 48.5 feet North of the $\frac{1}{4}$ Corner on the East side of Section 1, The true bearing & distance of this line is $90^{\circ} 32' E$ 5285.6 feet.

I then go back on the true East & West $\frac{1}{4}$ Section line 1321.4 feet or $\frac{1}{4}$ of the way from the East $\frac{1}{4}$ Corner on Section one and set a post from which a 40" Fir bears $N 11^{\circ} E 24.5'$, and then from this post, I ran a transit line $N 0^{\circ} 20' E$ 2625.4 feet to point.

.....
 Deputy County Surveyor.

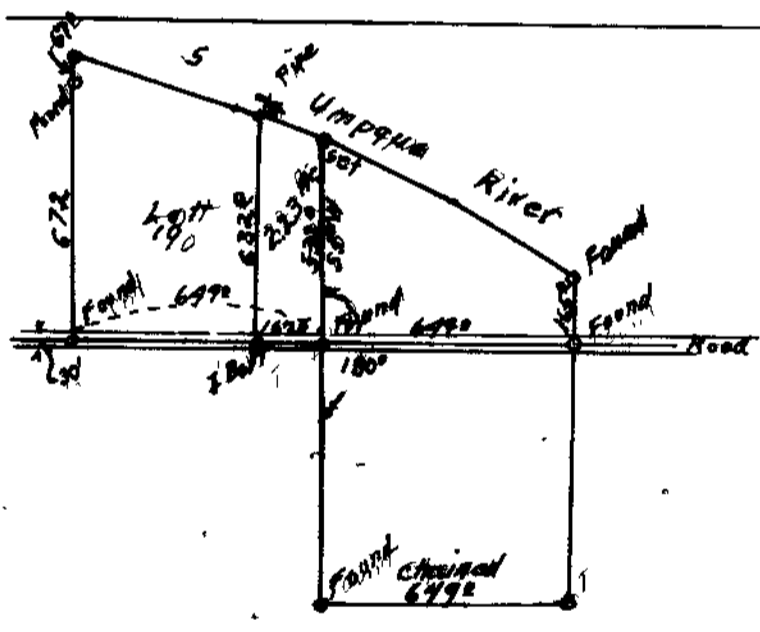

This survey was made to cut 2.23 acres off from Lot 10 of Miller's Dillard Sub-division. The points marked found are the old corners of the original survey of Summers of this sub-division and they were used in laying out Lot 10, and then the 2.23 acres was layed off the East side of the Lot, making 167.5 feet along the road, and then extending 532.0 feet along the East side of lot 10 to the South Umpqua River and extending 632.0 feet on the West side of Lot 10 to the said River. Marking on the West line are as shown on the above plat.

.....
 Deputy County Surveyor.