



NO FEE

00216492200800089060020026 05/05/2008 09:31:23 AM

PLAT-PAR Cnt=1 Stn=1 RECEIPTCOUNTER
This is a no fee document

APPROVALS:

Sheryl C. Goodhue for K.C. 4/30/08
DOUGLAS COUNTY PLANNING DIRECTOR DATE

Ronny Wynn 5-1-08
DOUGLAS COUNTY SURVEYOR DATE

I HEREBY CERTIFY THAT ALL TAXES AND SPECIAL ASSESSMENTS OR OTHER CHARGES
REQUIRED BY LAW HAVE BEEN PAID

Sandra K. Cooree 5/5/08
DOUGLAS COUNTY TAX COLLECTOR DATE

FILED THIS 5th DAY OF MAY, 2008, 9:31 O'CLOCK (AM/PM)

BARBARA E. NIELSEN 5/5/08, by *Sharon Tapp, Deputy*
DOUGLAS COUNTY CLERK DATE



DECLARATION:

KNOW ALL PEOPLE BY THESE PRESENTS THAT **EVELYN STOFFEL REVOCABLE LIVING TRUST**, IS THE
OWNER OF THE LAND REPRESENTED HEREON AND MORE PARTICULARLY DESCRIBED HEREIN AND HAS
CAUSED THE SAME TO BE PLATTED INTO PARCELS TOGETHER WITH EASEMENTS AS SHOWN.



SEE CONSENT AFFIDAVIT

MARY A. SKOUBO, TRUSTEE DATE

SEE CONSENT AFFIDAVIT

WILLIAM J. STOFFEL, TRUSTEE DATE

CONSENT AFFIDAVIT FILED AS INSTRUMENT NO. 2008-008904

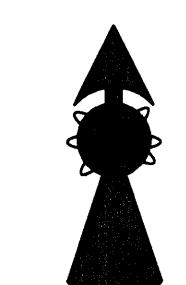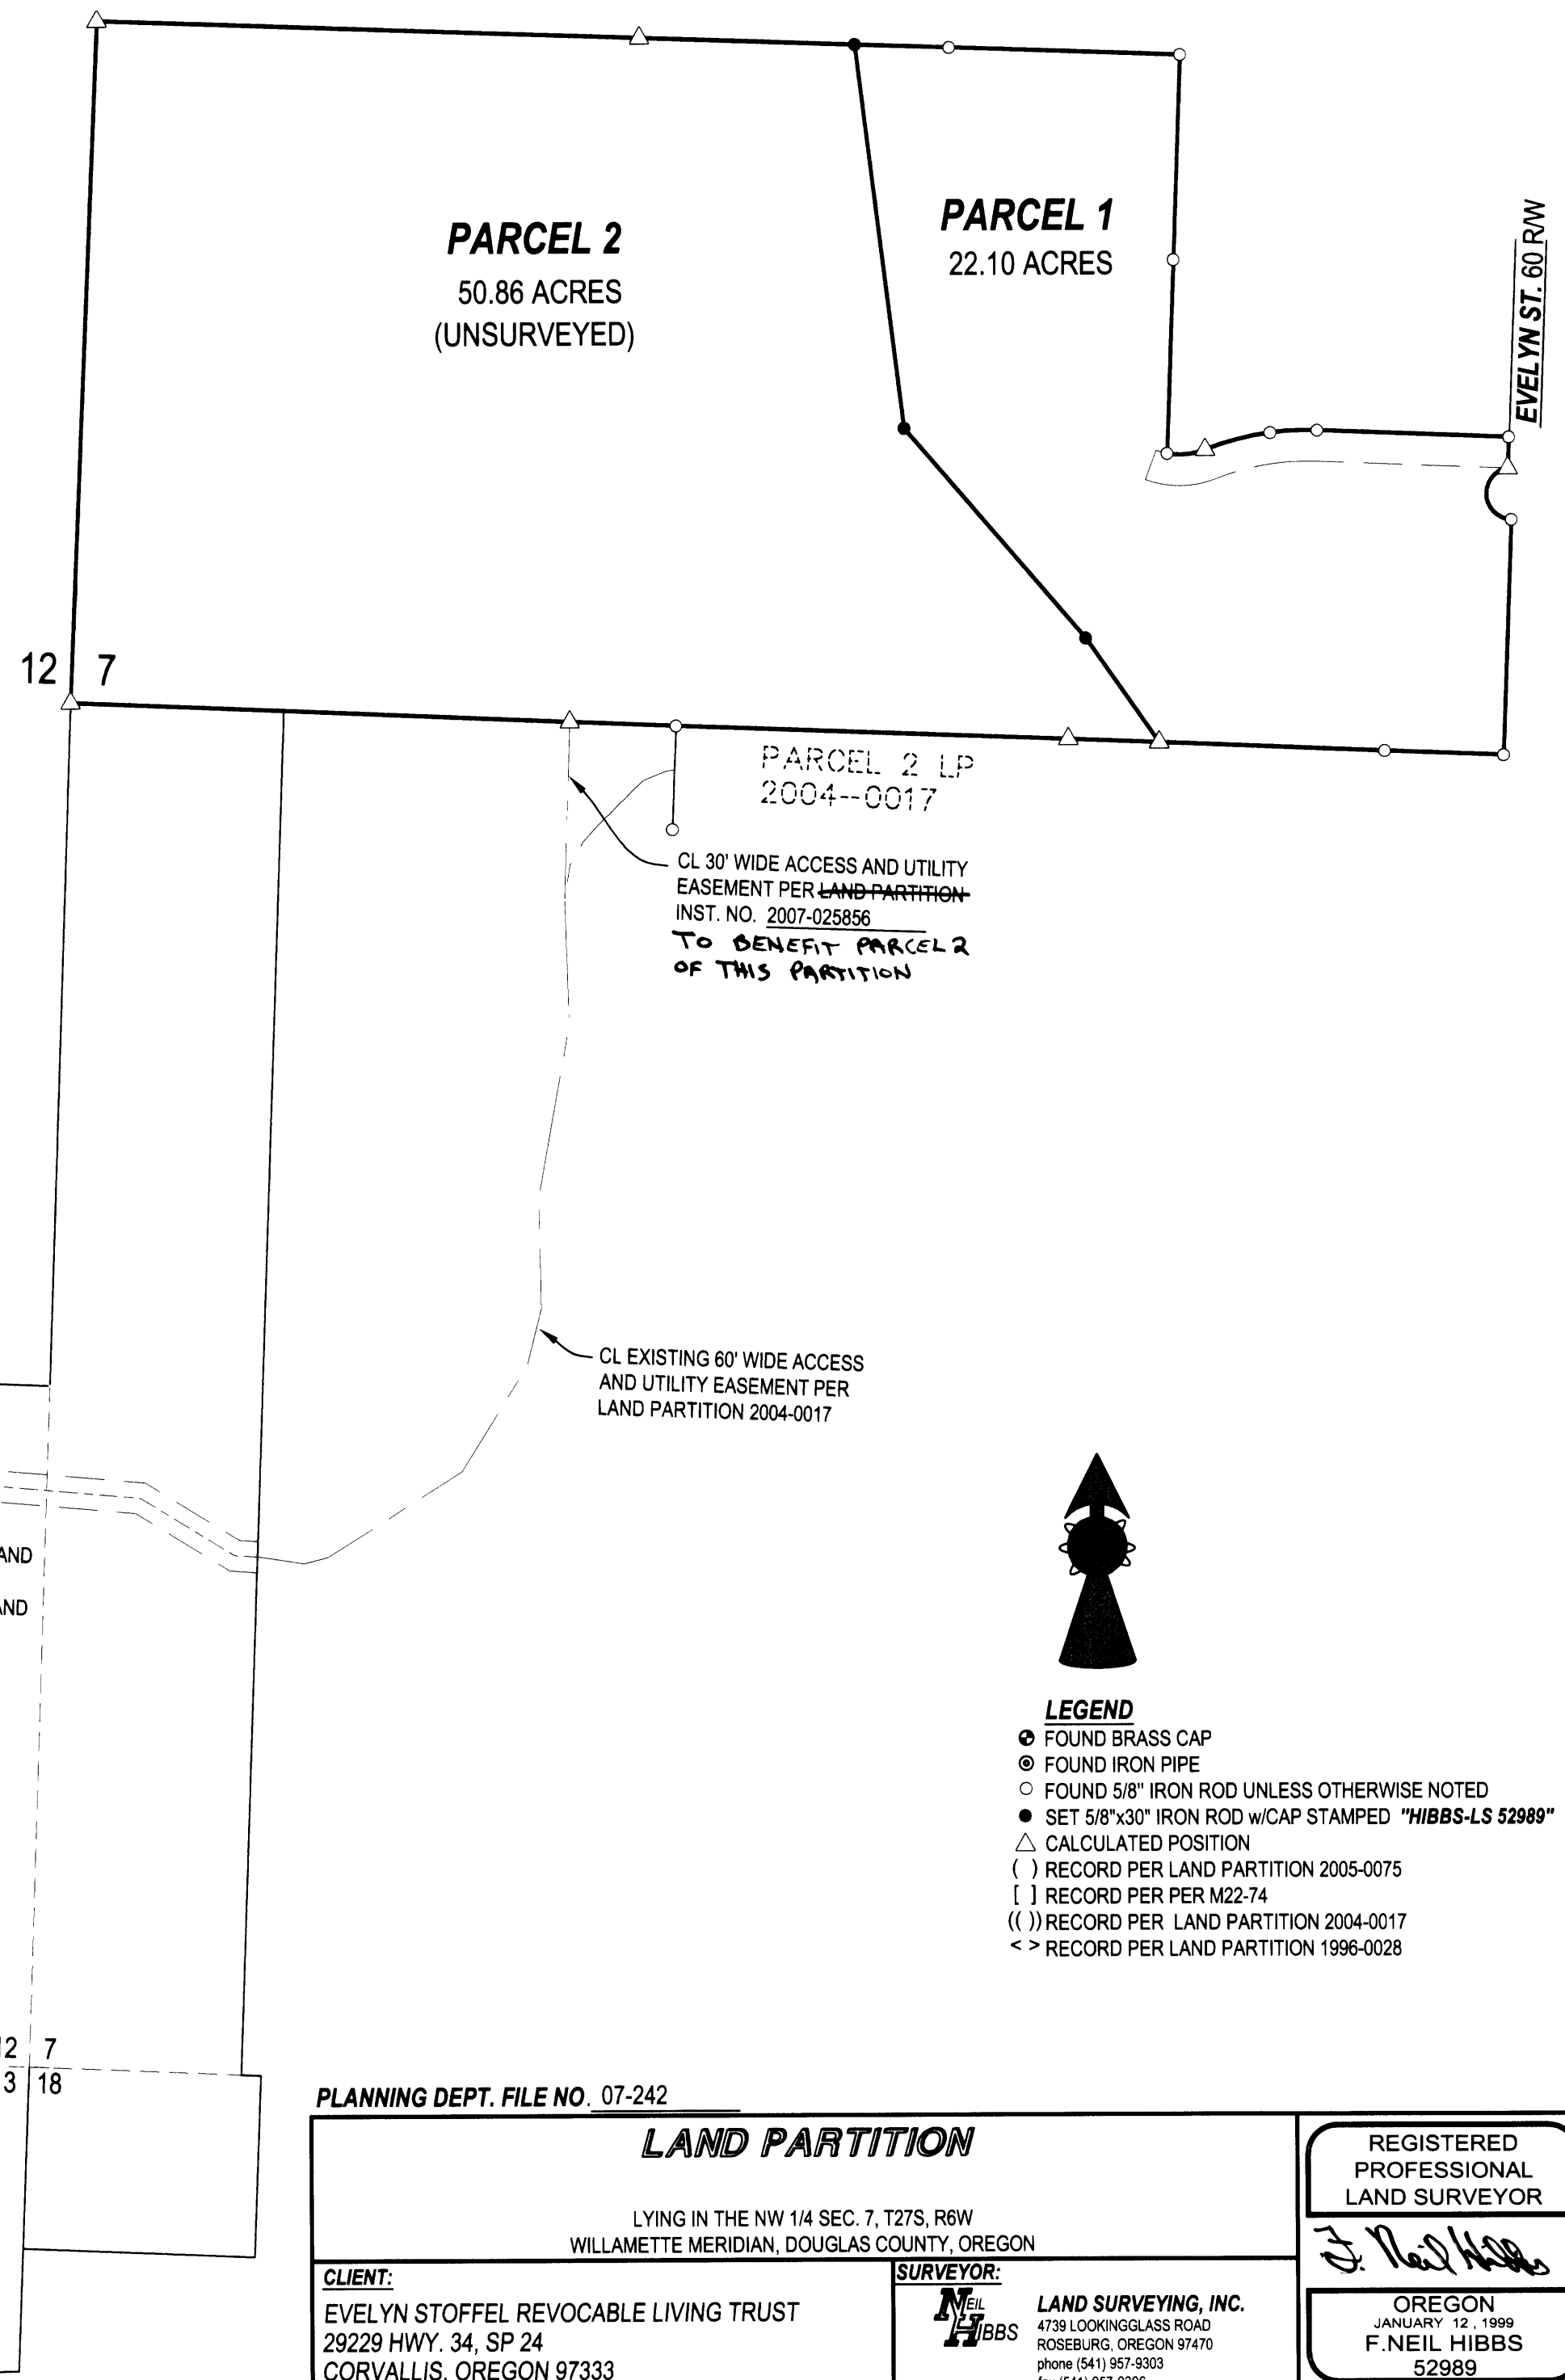

- LEGEND**
- FOUND BRASS CAP
 - ⊙ FOUND IRON PIPE
 - FOUND 5/8" IRON ROD UNLESS OTHERWISE NOTED
 - SET 5/8"x30" IRON ROD w/CAP STAMPED "HIBBS-LS 52989"
 - △ CALCULATED POSITION
 - () RECORD PER LAND PARTITION 2005-0075
 - [] RECORD PER PER M22-74
 - (()) RECORD PER LAND PARTITION 2004-0017
 - <> RECORD PER LAND PARTITION 1996-0028

PLANNING DEPT. FILE NO. 07-242

LAND PARTITION

LYING IN THE NW 1/4 SEC. 7, T27S, R6W
WILLAMETTE MERIDIAN, DOUGLAS COUNTY, OREGON

CLIENT:
EVELYN STOFFEL REVOCABLE LIVING TRUST
29229 HWY. 34, SP 24
CORVALLIS, OREGON 97333

SURVEYOR:
NEIL HIBBS
LAND SURVEYING, INC.
4739 LOOKINGGLASS ROAD
ROSEBURG, OREGON 97470
phone (541) 957-9303
fax (541) 957-9306
email: neilhibbs@wildblue.net

REGISTERED
PROFESSIONAL
LAND SURVEYOR

F. Neil Hibbs

OREGON
JANUARY 12, 1999
F. NEIL HIBBS
52989

DWG. SCALE: 1" = 300' JOB #: 0820-01 DWG. BY: FLB PAGE: 1 OF 2 DATE: MARCH 2008

6/30/2009

2008-0025 A

2008-0025 A