

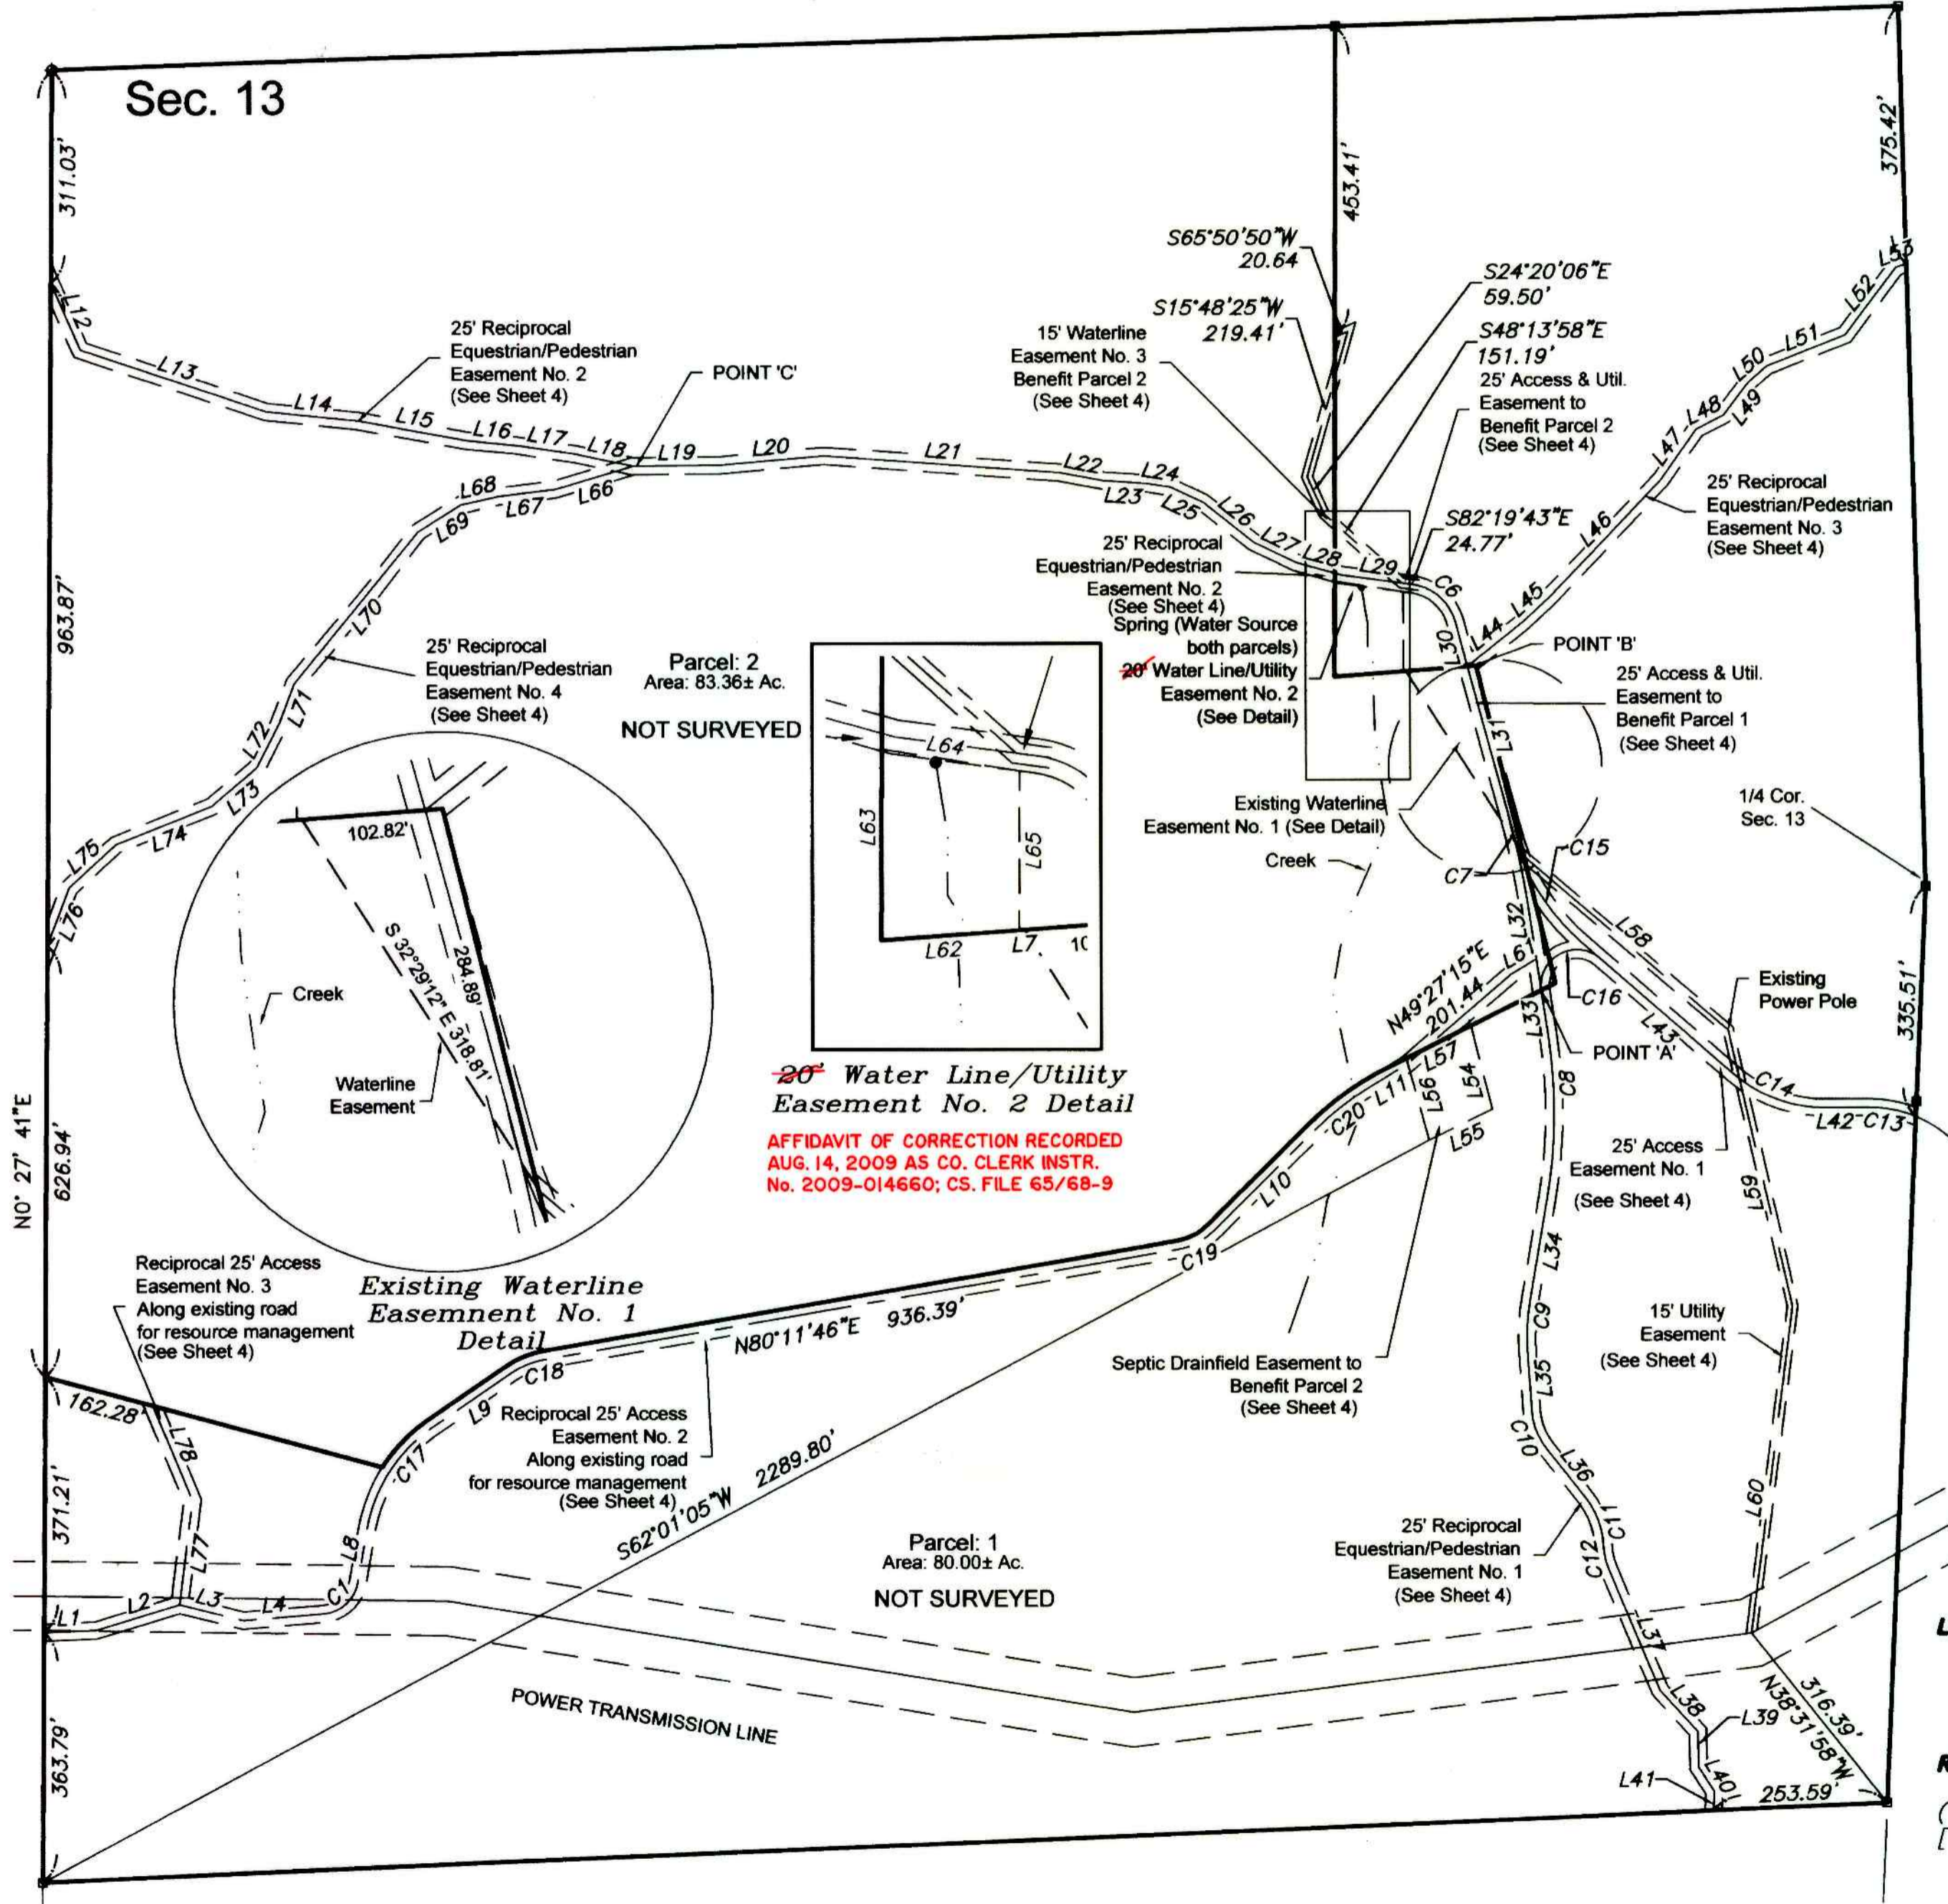


2009-0035 C

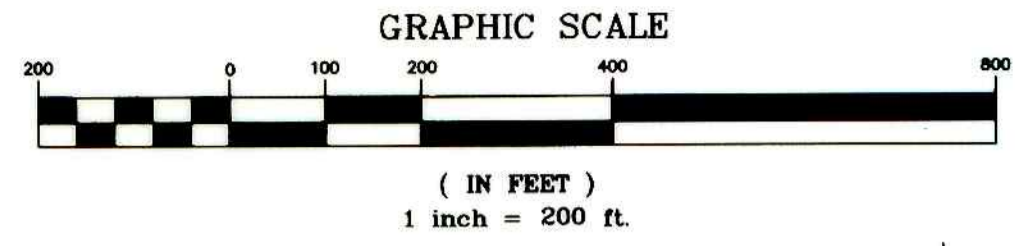

Easement Line Table			Easement Line Table			Easement Line Table		
Line #	Length	Direction	Line #	Length	Direction	Line #	Length	Direction
L1	75.73	N87° 54' 13"E	L29	104.62	S82° 19' 43"E	L54	125.34	S14° 24' 11"E
L2	127.59	N73° 14' 19"E	L30	67.54	S15° 20' 54"E	L55	102.94	N63° 53' 41"E
L3	96.01	S75° 53' 17"E	L31	220.37	S15° 20' 54"E	L56	124.20	S15° 22' 29"E
L4	117.27	N85° 27' 01"E	L32	106.75	S8° 31' 22"E	L57	105.24	S63° 30' 29"W
L8	76.51	N9° 54' 46"E	L33	68.14	S8° 41' 22"E	L58	390.78	N49° 33' 20"W
L9	140.70	N55° 39' 10"E	L34	151.49	S9° 46' 57"W	L59	412.35	N12° 58' 20"W
L10	209.40	N45° 23' 39"E	L35	85.48	S3° 57' 22"E	L60	478.73	N7° 22' 42"E
L11	62.23	N58° 42' 54"E	L36	92.16	S38° 14' 45"E	L61	42.82	N58° 48' 40"E
L12	106.31	S23° 40' 57"E	L37	190.79	S22° 54' 20"E	L62	100.30	N85° 46' 54"E
L13	285.60	S71° 24' 23"E	L38	81.28	S42° 17' 08"E	L63	138.99	S0° 13' 17"W
L14	134.71	S84° 10' 10"E	L39	51.96	S1° 21' 43"E	L64	101.21	N80° 55' 21"W
L15	162.32	S79° 35' 24"E	L40	42.14	S32° 45' 07"E	L65	115.65	N0° 13' 17"E
L16	69.93	S84° 23' 55"E	L41	27.36	S2° 51' 51"W	L66	118.48	S73° 34' 47"W
L17	88.08	S81° 24' 49"E	L42	63.98	S89° 56' 17"W	L67	84.13	S82° 57' 39"W
L18	85.92	S78° 12' 02"E	L43	291.33	N49° 00' 47"W	L68	54.99	S77° 05' 52"W
L19	127.27	N89° 23' 47"E	L44	103.52	N51° 29' 03"E	L69	73.65	S58° 13' 31"W
L20	150.45	N84° 56' 25"E	L45	53.47	N47° 04' 11"E	L70	285.04	S39° 23' 51"W
L21	342.57	S85° 52' 38"E	L46	235.39	N43° 43' 28"E	L71	63.25	S21° 07' 49"W
L22	63.48	S79° 24' 59"E	L47	89.34	N35° 09' 36"E	L72	71.13	S27° 00' 05"W
L23	64.72	S86° 14' 47"E	L48	44.77	N63° 09' 58"E	L73	86.53	S49° 35' 52"W
L24	35.05	S80° 58' 18"E	L49	59.44	N37° 28' 55"E	L74	150.60	S68° 25' 57"W
L25	52.64	S64° 58' 48"E	L50	36.38	N49° 05' 49"E	L75	92.35	S47° 47' 07"W
L26	93.53	S51° 48' 04"E	L51	122.82	N68° 37' 20"E	L76	89.72	S20° 49' 01"W
L27	68.90	S64° 05' 53"E	L52	122.30	N37° 09' 23"E	L77	152.28	S7° 13' 35"W
L28	68.09	S74° 20' 52"E	L53	16.59	N69° 12' 10"E	L78	149.54	S22° 34' 16"E

Easement Curve Table					
Curve #	Length	Radius	Delta	Chord Direction	Chord Length
C1	73.25	55.56	75° 32' 16"	N47° 40' 54"E	68.06
C6	87.62	74.95	66° 58' 49"	S48° 50' 18"E	82.72
C7	157.53	1330.07	6° 47' 09"	S11° 50' 12"E	157.44
C8	233.62	724.62	18° 28' 19"	S0° 32' 48"W	232.61
C9	76.00	316.96	13° 44' 19"	S2° 54' 48"W	75.82
C10	59.85	100.00	34° 17' 23"	S21° 06' 03"E	58.96
C11	73.82	122.03	34° 39' 40"	S20° 20' 32"E	72.70
C12	36.87	100.01	21° 07' 14"	S12° 20' 43"E	36.66
C13	70.11	177.62	22° 36' 57"	N78° 45' 15"W	69.66
C14	145.94	203.70	41° 02' 56"	N69° 32' 15"W	142.83
C15	222.42	332.95	38° 16' 30"	N29° 36' 02"W	218.30
C16	127.11	52.14	139° 40' 35"	S61° 08' 55"W	97.89
C17	181.62	227.50	45° 44' 23"	N32° 46' 58"E	176.83
C18	51.77	120.86	24° 32' 37"	N67° 55' 28"E	51.38
C19	58.31	95.99	34° 48' 07"	N62° 47' 42"E	57.42
C20	100.93	434.12	13° 19' 14"	N52° 03' 17"E	100.70

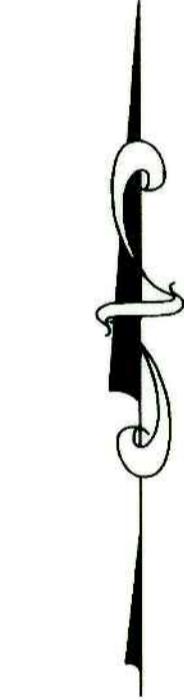

Basis of Bearing, Oregon State Plain Coordinate System, South Zone per GPS Observation.

Sheet 3 of 4

PARTITION (Easements)
In the SE 1/4 and NE 1/4, Section 13
Township 26 South, Range 2 West, W.M.
Douglas County, Oregon
June 23, 2009

REGISTERED PROFESSIONAL LAND SURVEYOR
Mark A. Heimbarger
OREGON
JULY 16, 1987
MARK A. HEIMBURGER
2287
RENEWS JUNE 30, 2011

FOR: Anne Dorsey
P.O. Box 216
Idlewild Park, Oregon 97447

LM LAND MARK SURVEYING, INC.
3329 N.E. STEPHENS ST.
ROSEBURG, OREGON 97470
TEL. (541) 677-9400
FAX (541) 677-9401

LEGEND:
 • Found Brass Cap unless noted
 □ Calculated Point
RECORD INFORMATION:
 () M153-43
 [] M47-7

2009-0035 C