


2019-0018 A

(S89°49'43" E 1848.50')  
 S89°35'08" E 1850.69'

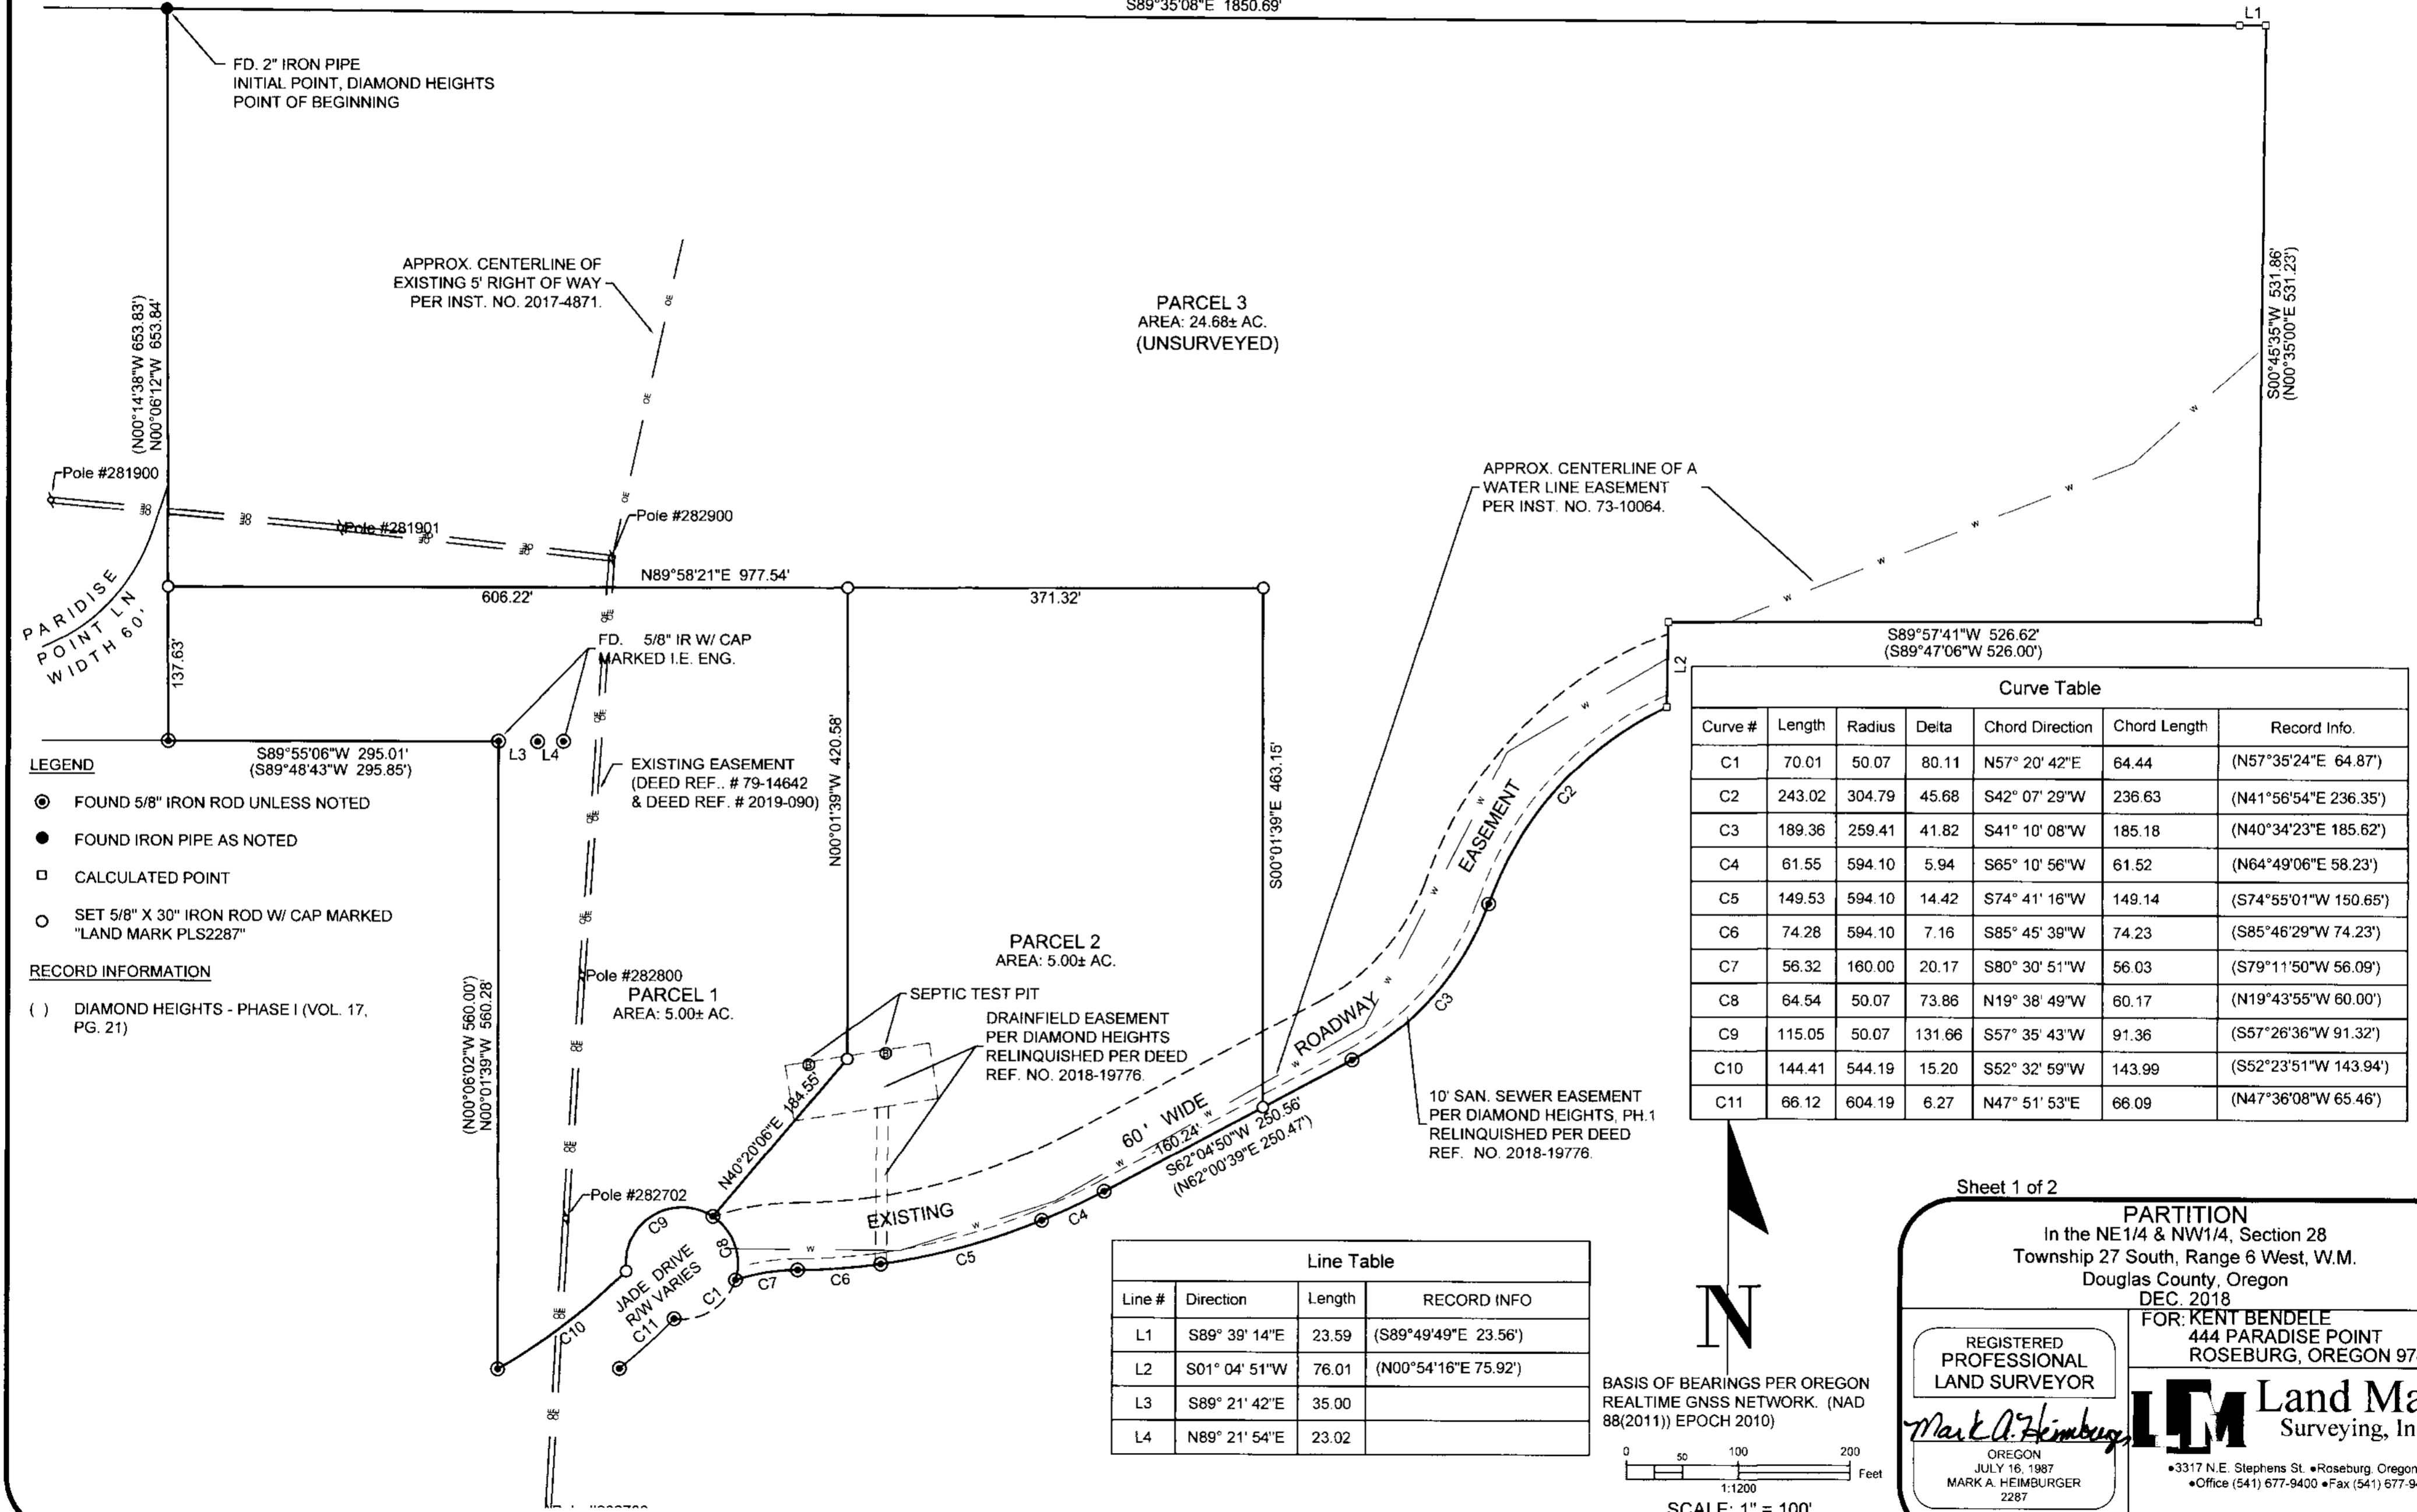

2019-0018 A.