


| PROPERTY SCHEDULE |              |         |       |              |        |      |         |      |            |
|-------------------|--------------|---------|-------|--------------|--------|------|---------|------|------------|
| No.               | Grantor      | Grantee | Inst. | Date         | Record | Page | Area    | Ac.  | Remarks    |
| 1                 | USA.         | O&CRR   | 2954  | July 25 1869 | 13     | 185  |         |      |            |
| 2                 | Edwards & W. |         | 2955  | Feb 1 1883   | 13     | 174  | 177-185 | 3908 | Mineral 1. |

SOUTHERN PACIFIC COMPANY  
STATION PLAN  
OF  
**BRANDT**  
DOUGLAS COUNTY  
PORTLAND DIVISION  
Scale 1"=100'  
Revised to Sept 1921

R516516

PORTLAND DIVISION  
Drawing No. 5162

Passing track extended and Line  
Change-1921-GMO-46405.  
See Note book 626 for Line Change.

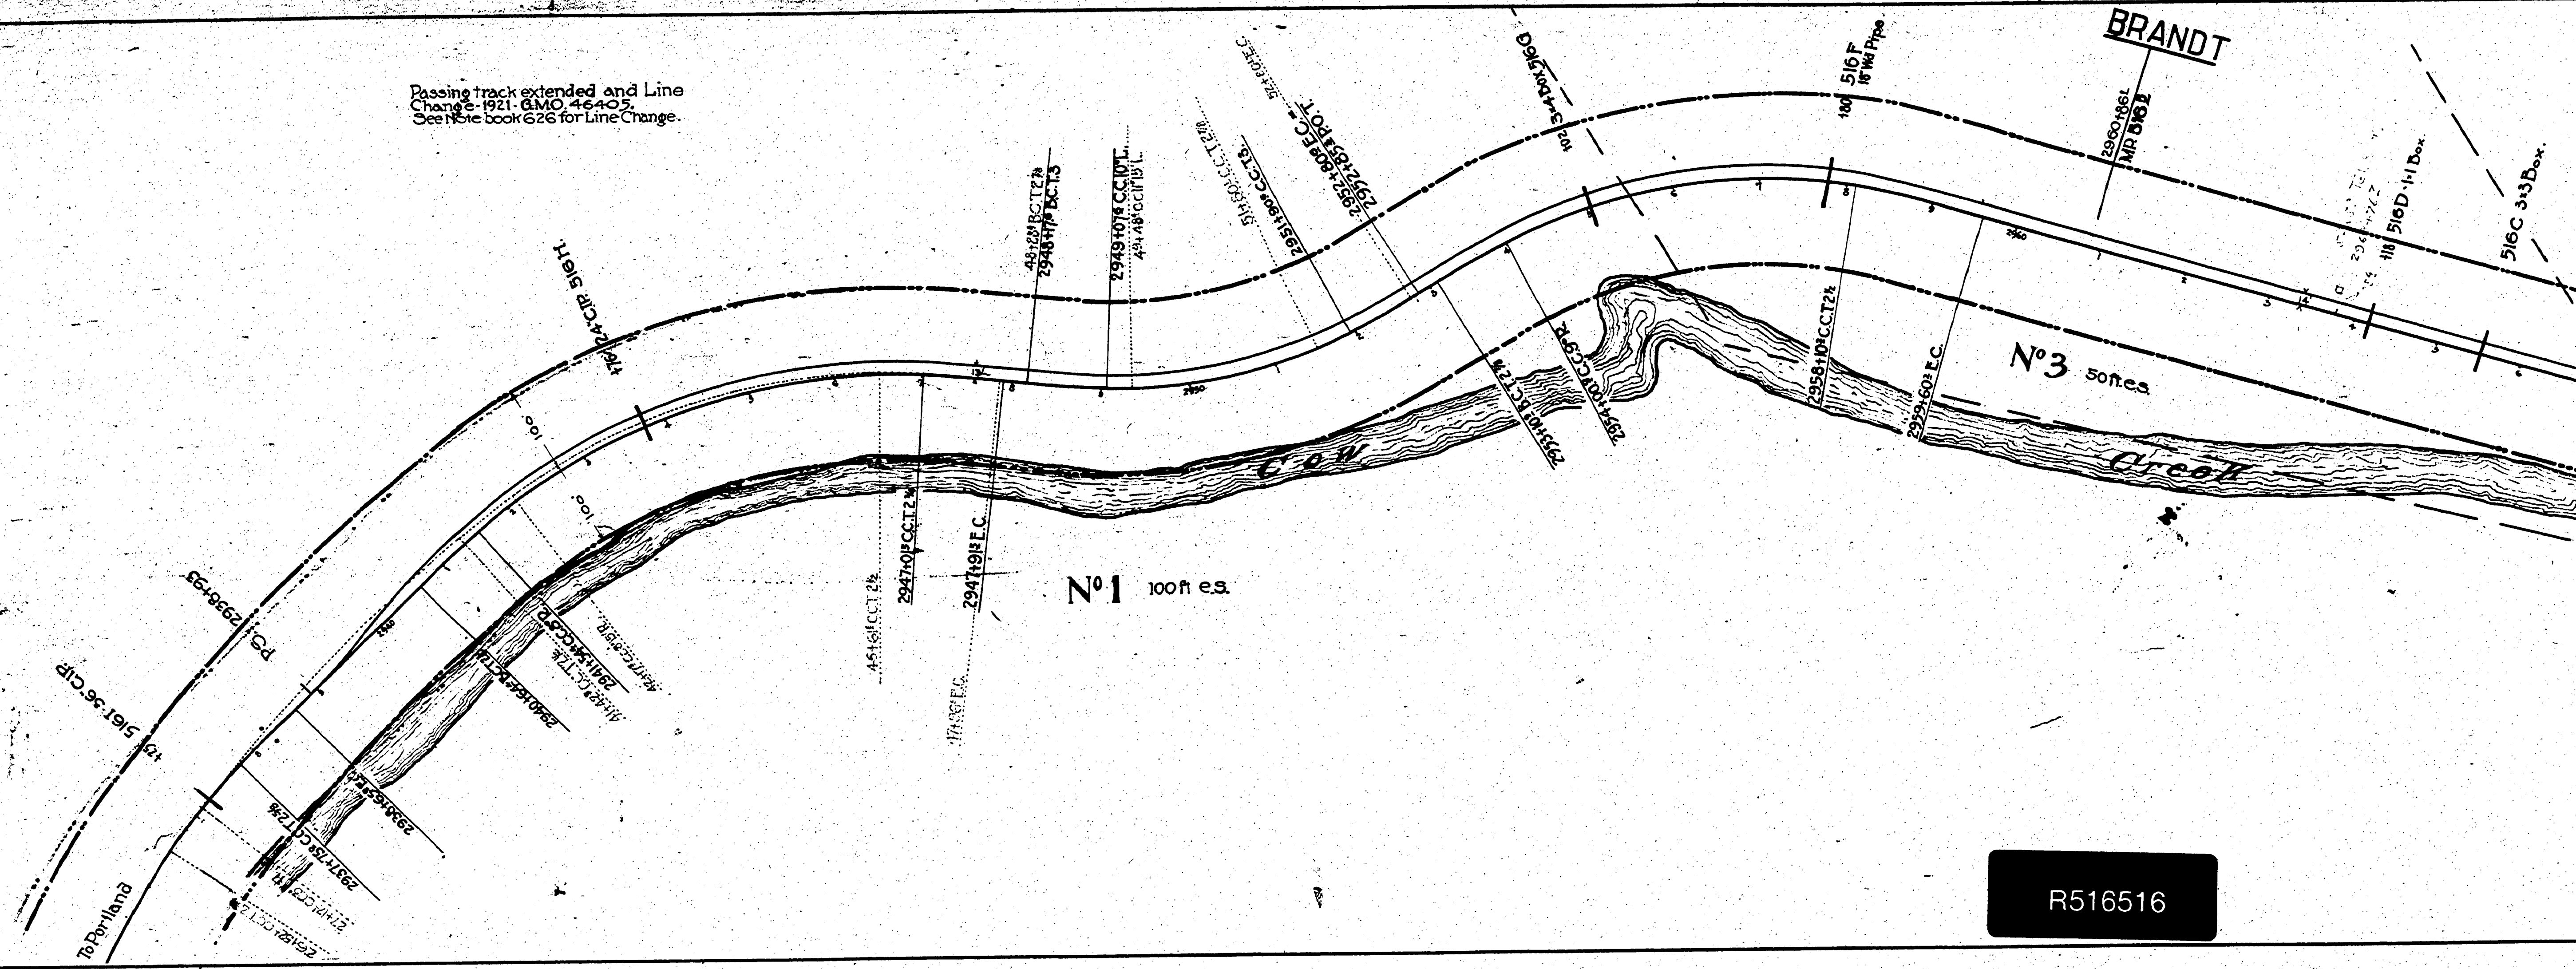

R516516