

RIVER

UMPQUA

John Kelly D.L.C. No. 41

OAKS  
MP 5706

05 Oaks station sign

20 divt. 570682: 3'x3'x30' crea. fir box

04 divt. 57074: 2-1'x26' corner pipes

1000 C.C. 3'x30'L.

7.51230 C.C. 3'x30'L.

7.51230 C.C. 3'x30'L.

7.51230 C.C. 3'x30'L.

7.51230 C.C. 3'x30'L.

050 C.C. 2'x15'L.

000 C.C. 3'x15'L.

000 C.C. 2'x45'L.

000 C.C. 3'x45'L.

T.27S., R.6 W.  
26 25  
35 36  
W.M.

00.3° L. +97.2

B.C.T.2 +372

divt. 570683: 2'x30' corner pipe

PS. +690  
divt. 5706: 447.2

Xop whistle post +06

sign "Roseburg One Mill" +97

PS. +584


mill pond

R570571

RIVER

John Kelly D.L.C. No. 41

OAKS  
MP 5706

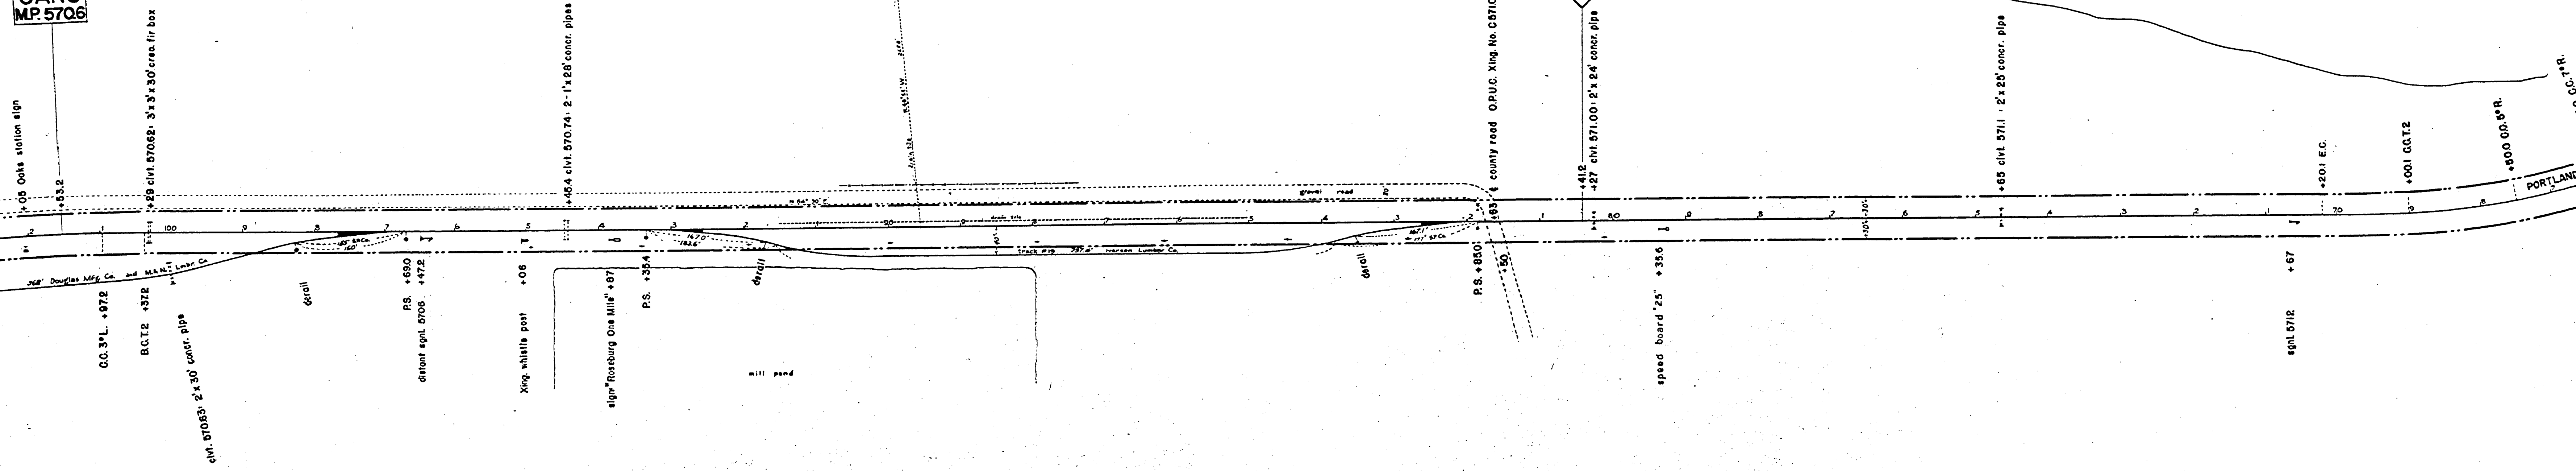

SOUTHERN PACIFIC COMPANY  
 PACIFIC LINES  
 SISKIYOU LINE  
 STATION PLAN  
**OAKS**  
 DOUGLAS COUNTY, OREGON  
 Scale: 1" = 100' W.M. January 31, 1949  
speed board added 3-23-49  
 drain tile 8-24-49

R570571