

ORTH UMPQUA RIVER

MARGARETTA


WILSON


sec. 25  
sec. 24 T. 26 S. R. 6 W.  
J. W. M.

P.L.C. 20 04

579  
STATION POINT  
AKIN

R578579

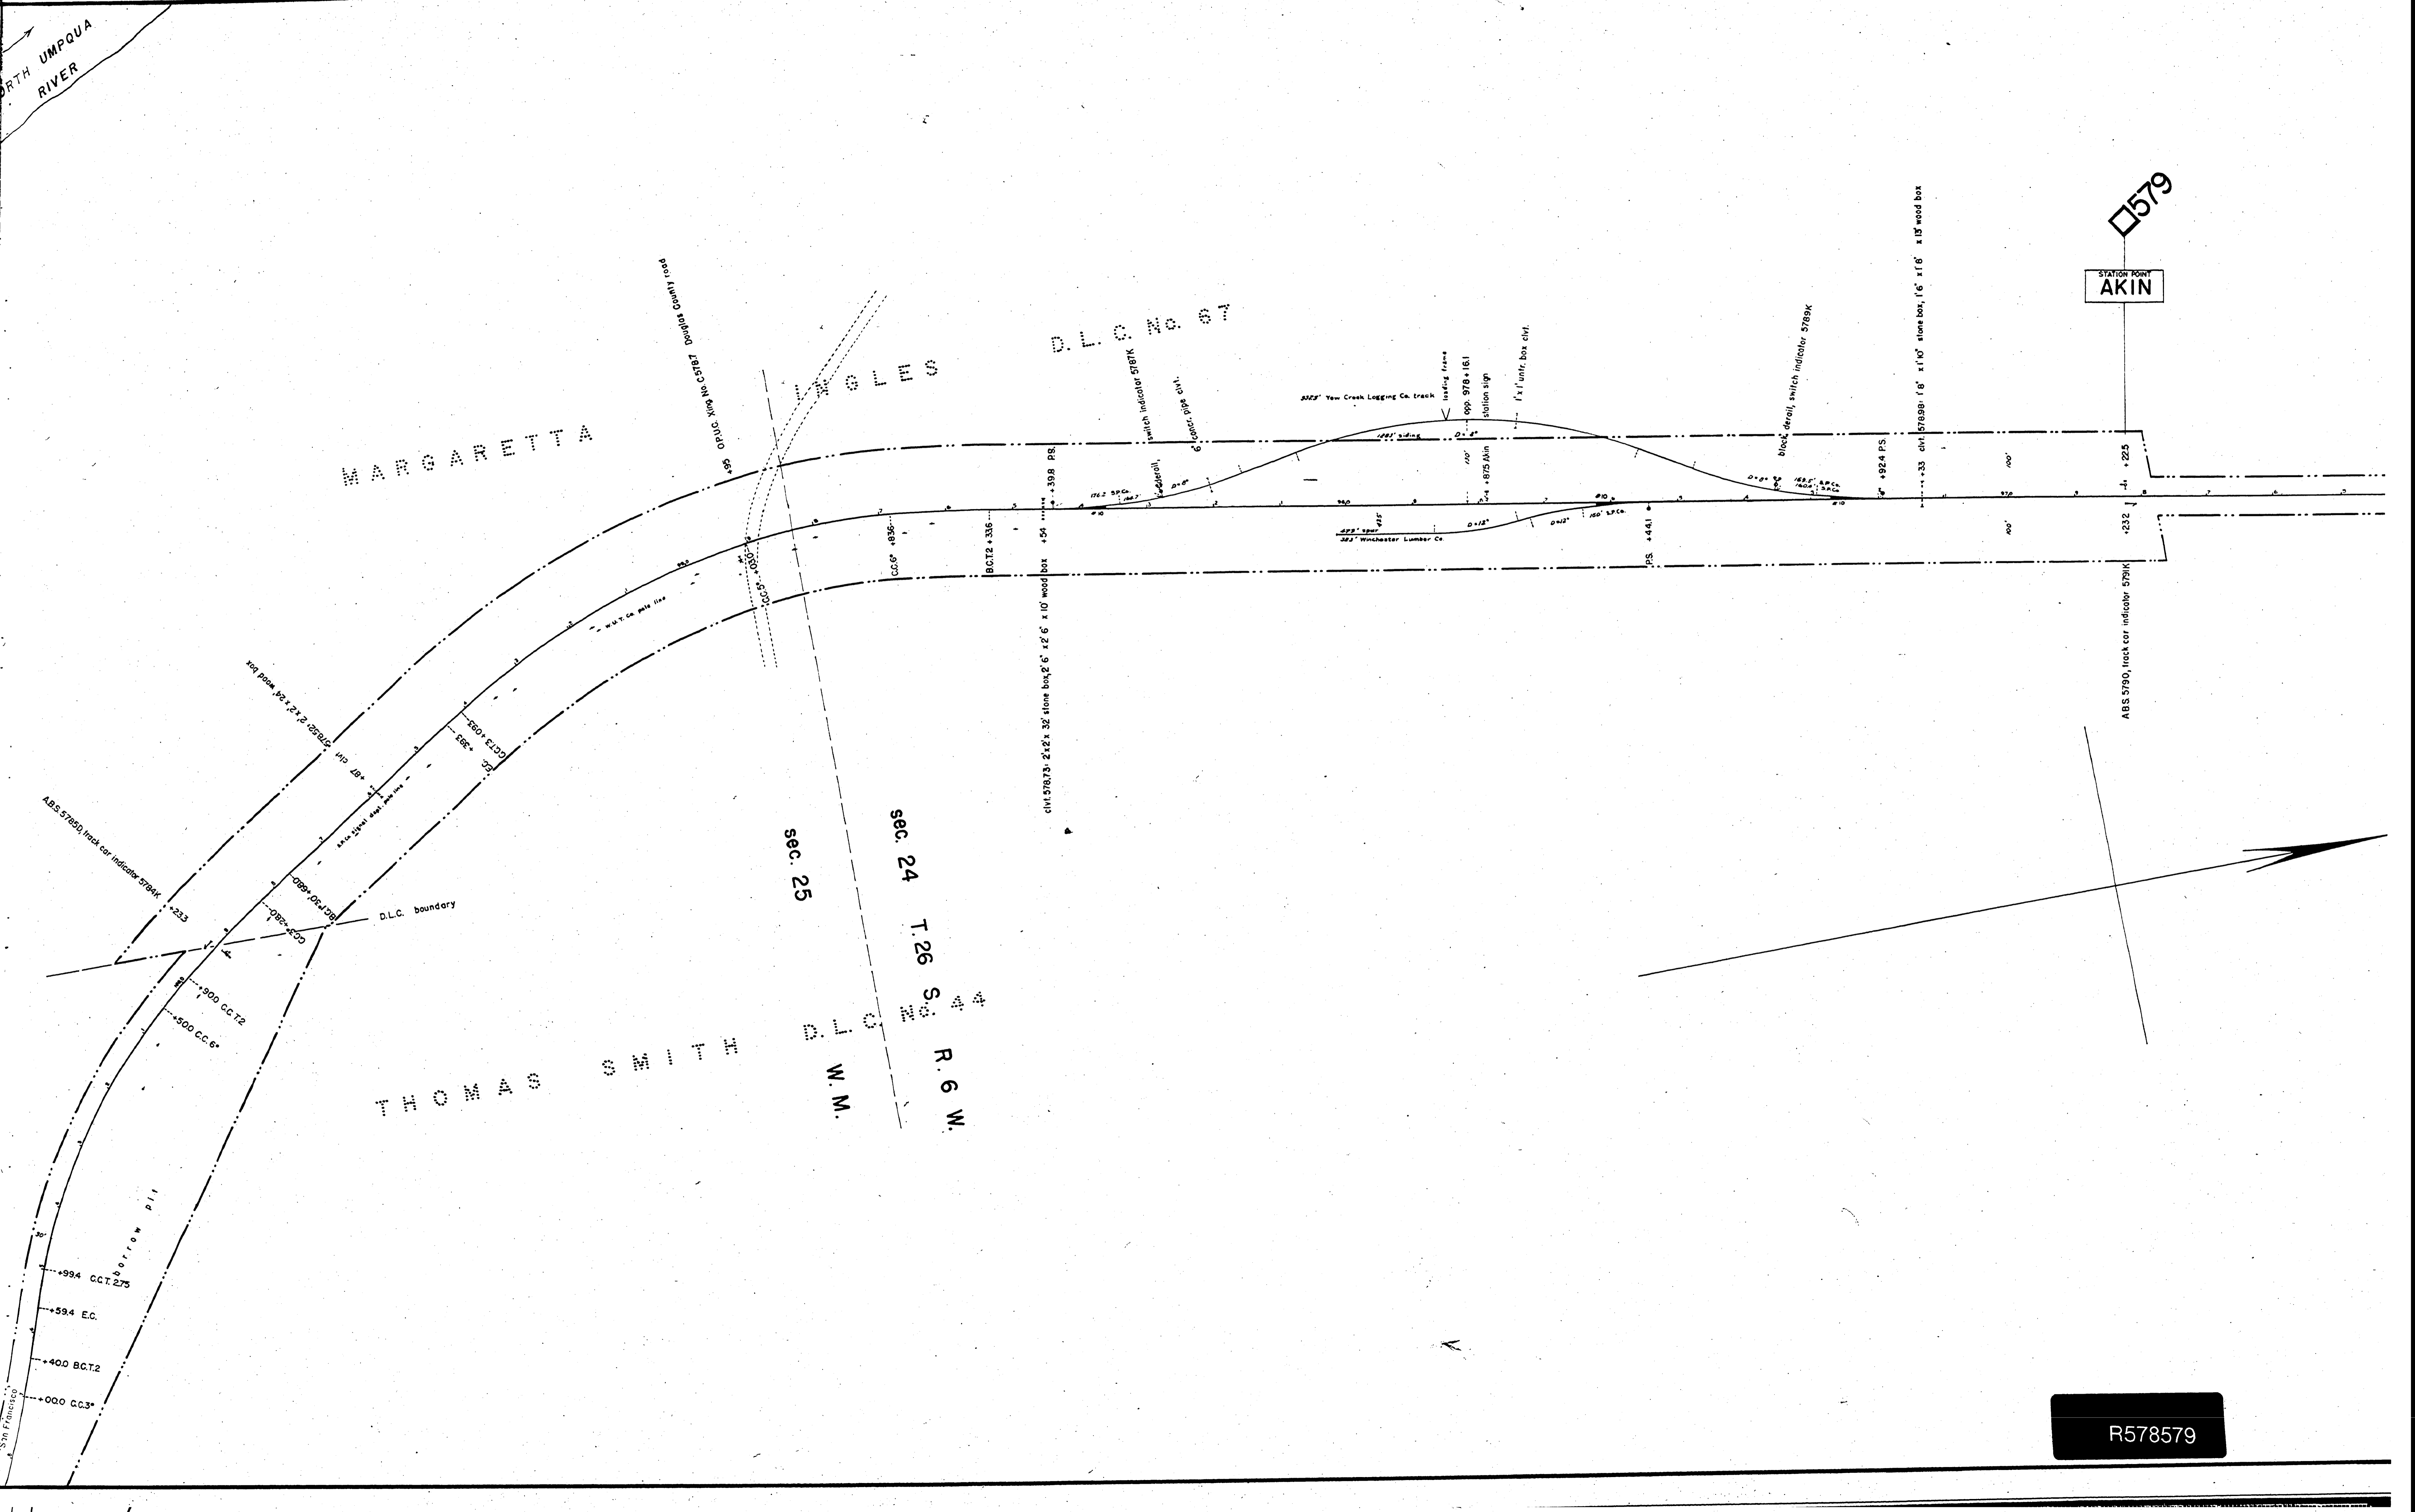

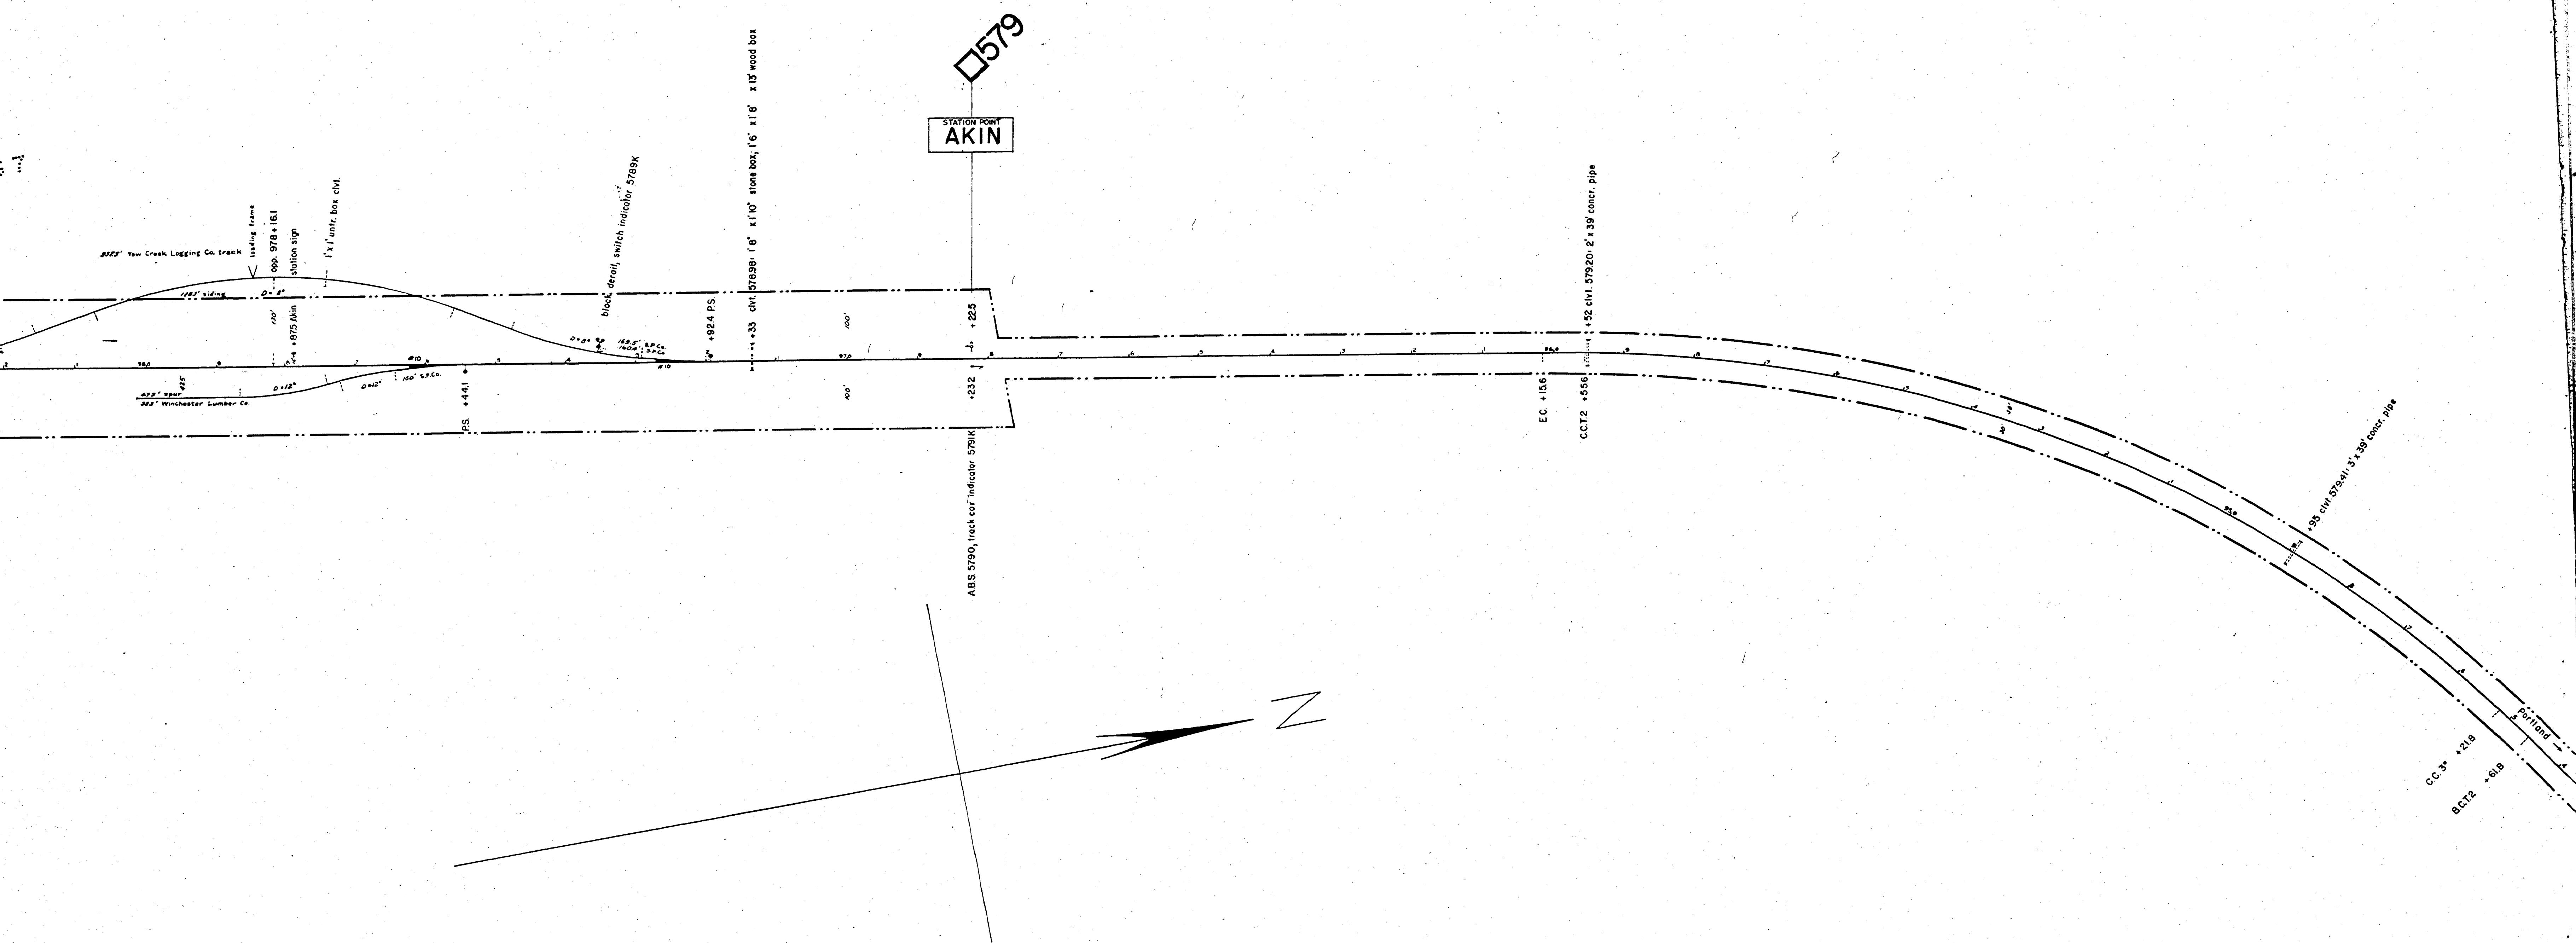

SOUTHERN PACIFIC COMPANY  
 PACIFIC LINES  
 SISKIYOU LINE  
 STATION PLAN  
**AKIN**  
 DOUGLAS COUNTY OREGON  
 Scale: 1"=100' WKM July 1, 1949

B578570