


Note 6: The 36.766 acs. previously shown in area col. have been decr. and disp. of as follows: 1.819 acs. by deed 20199, 20.3 acs.

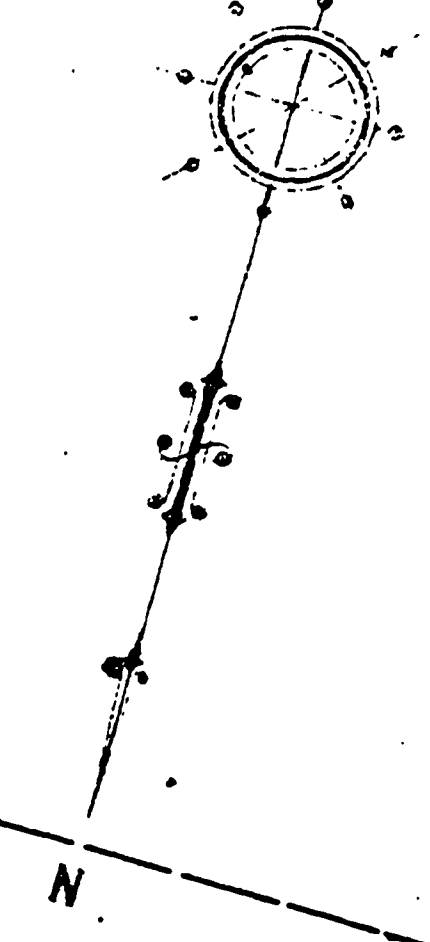


7th STANDARD PARALLEL SOUTH

T.33S. R.6W. W.M.

T.33S. R.7W. W.M.

32

15

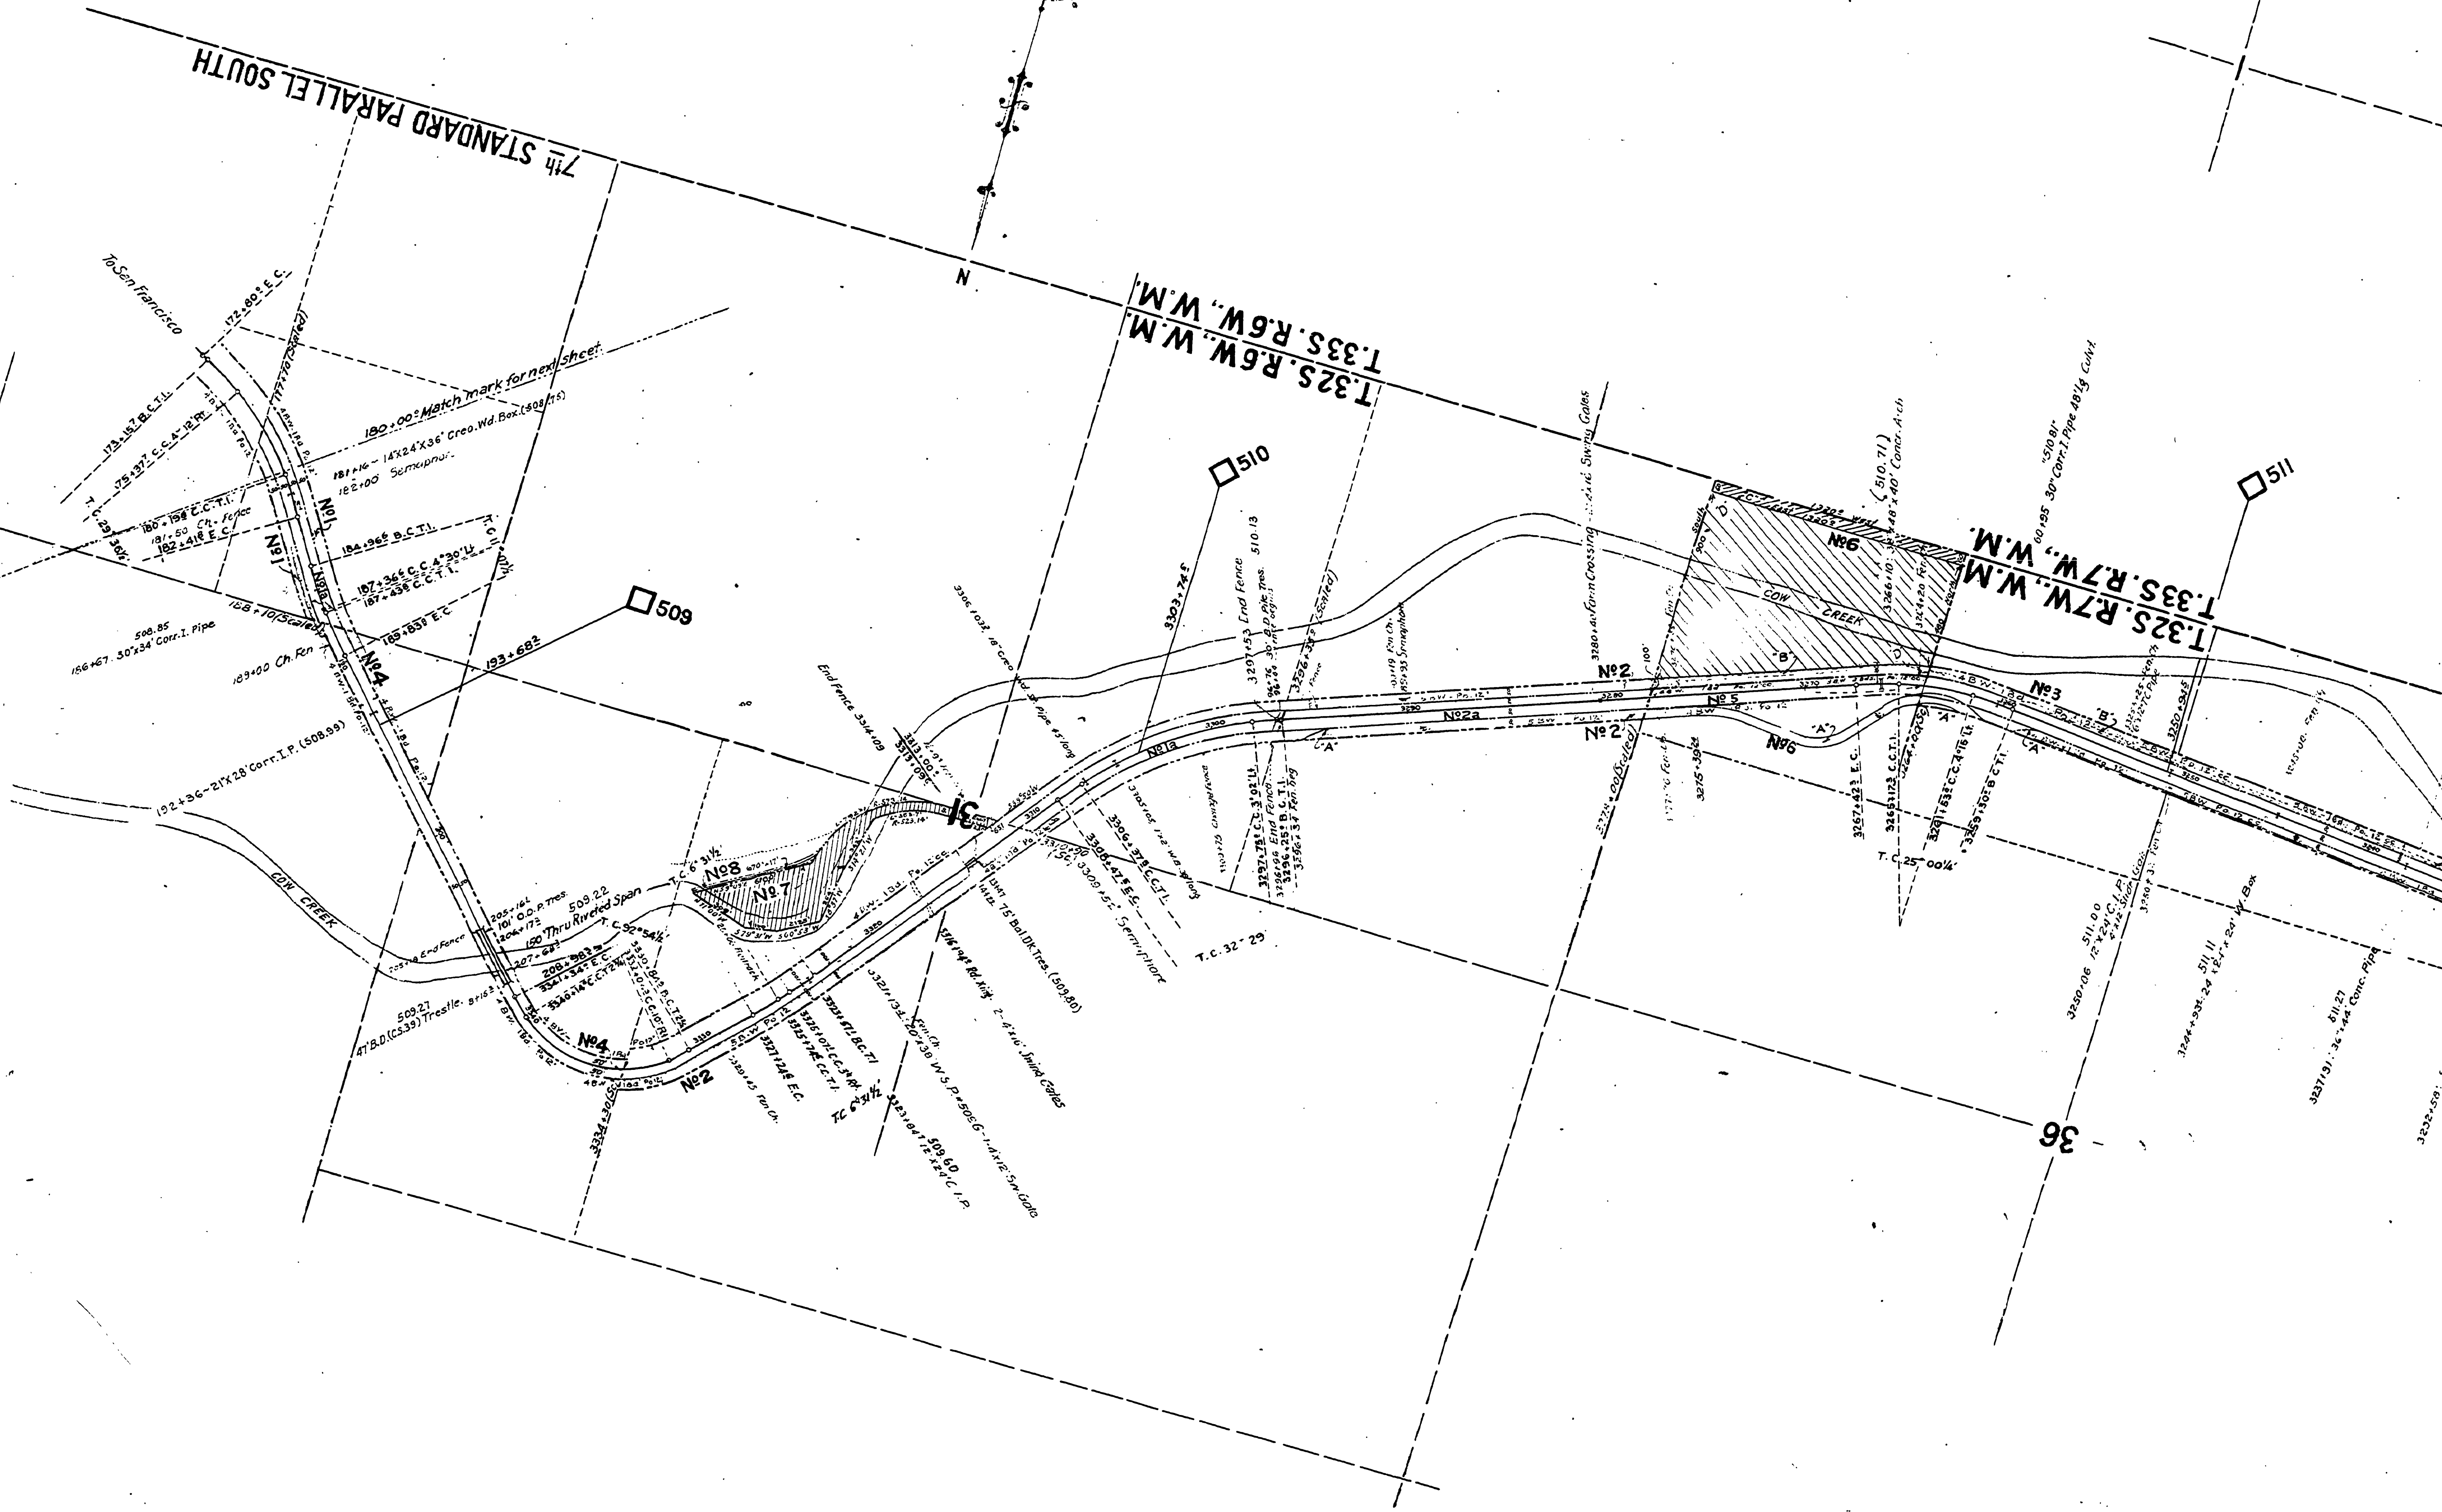

60728
21

36