


2

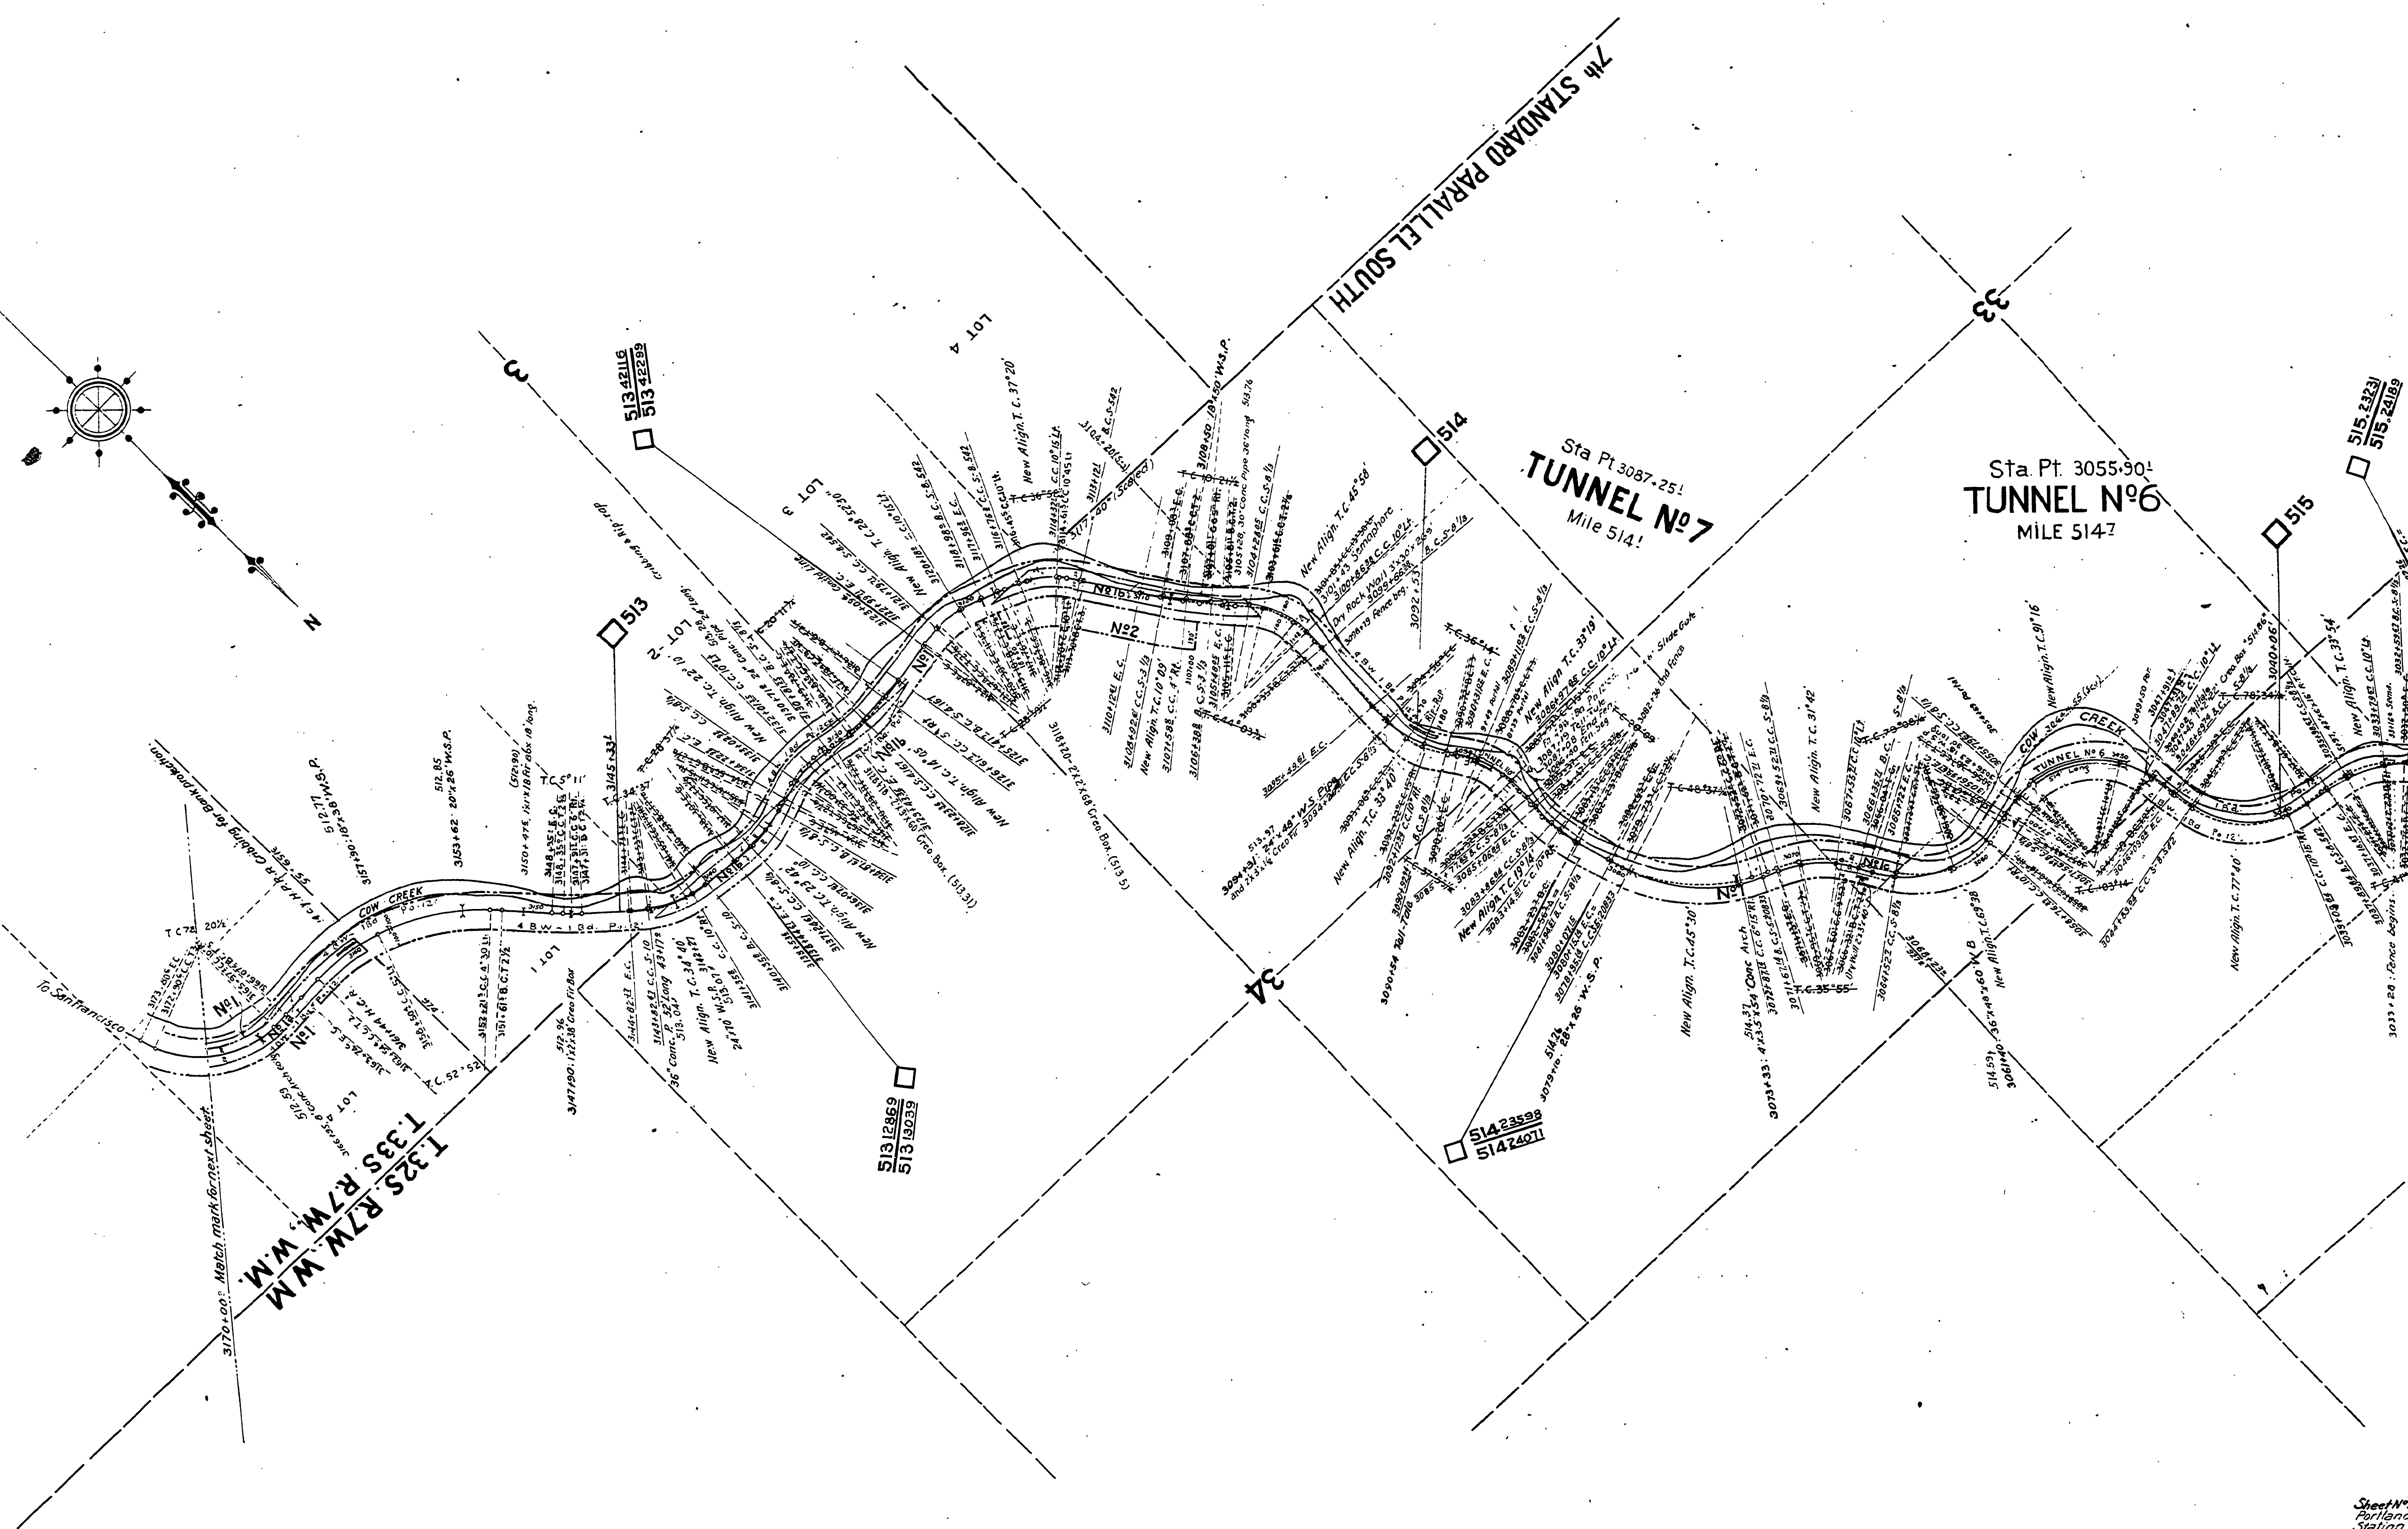

Match with next sheet
To San Francisco
T. 325 R. 7 W. W. M.
T. 335 R. 7 W. W. M.

Sta Pt 3087.25!
TUNNEL No 7
Mile 514!

Sta Pt 3055.90!
TUNNEL No 6
MILE 514.7

Sheet No 22 of
Portland Div.
Station 298.