

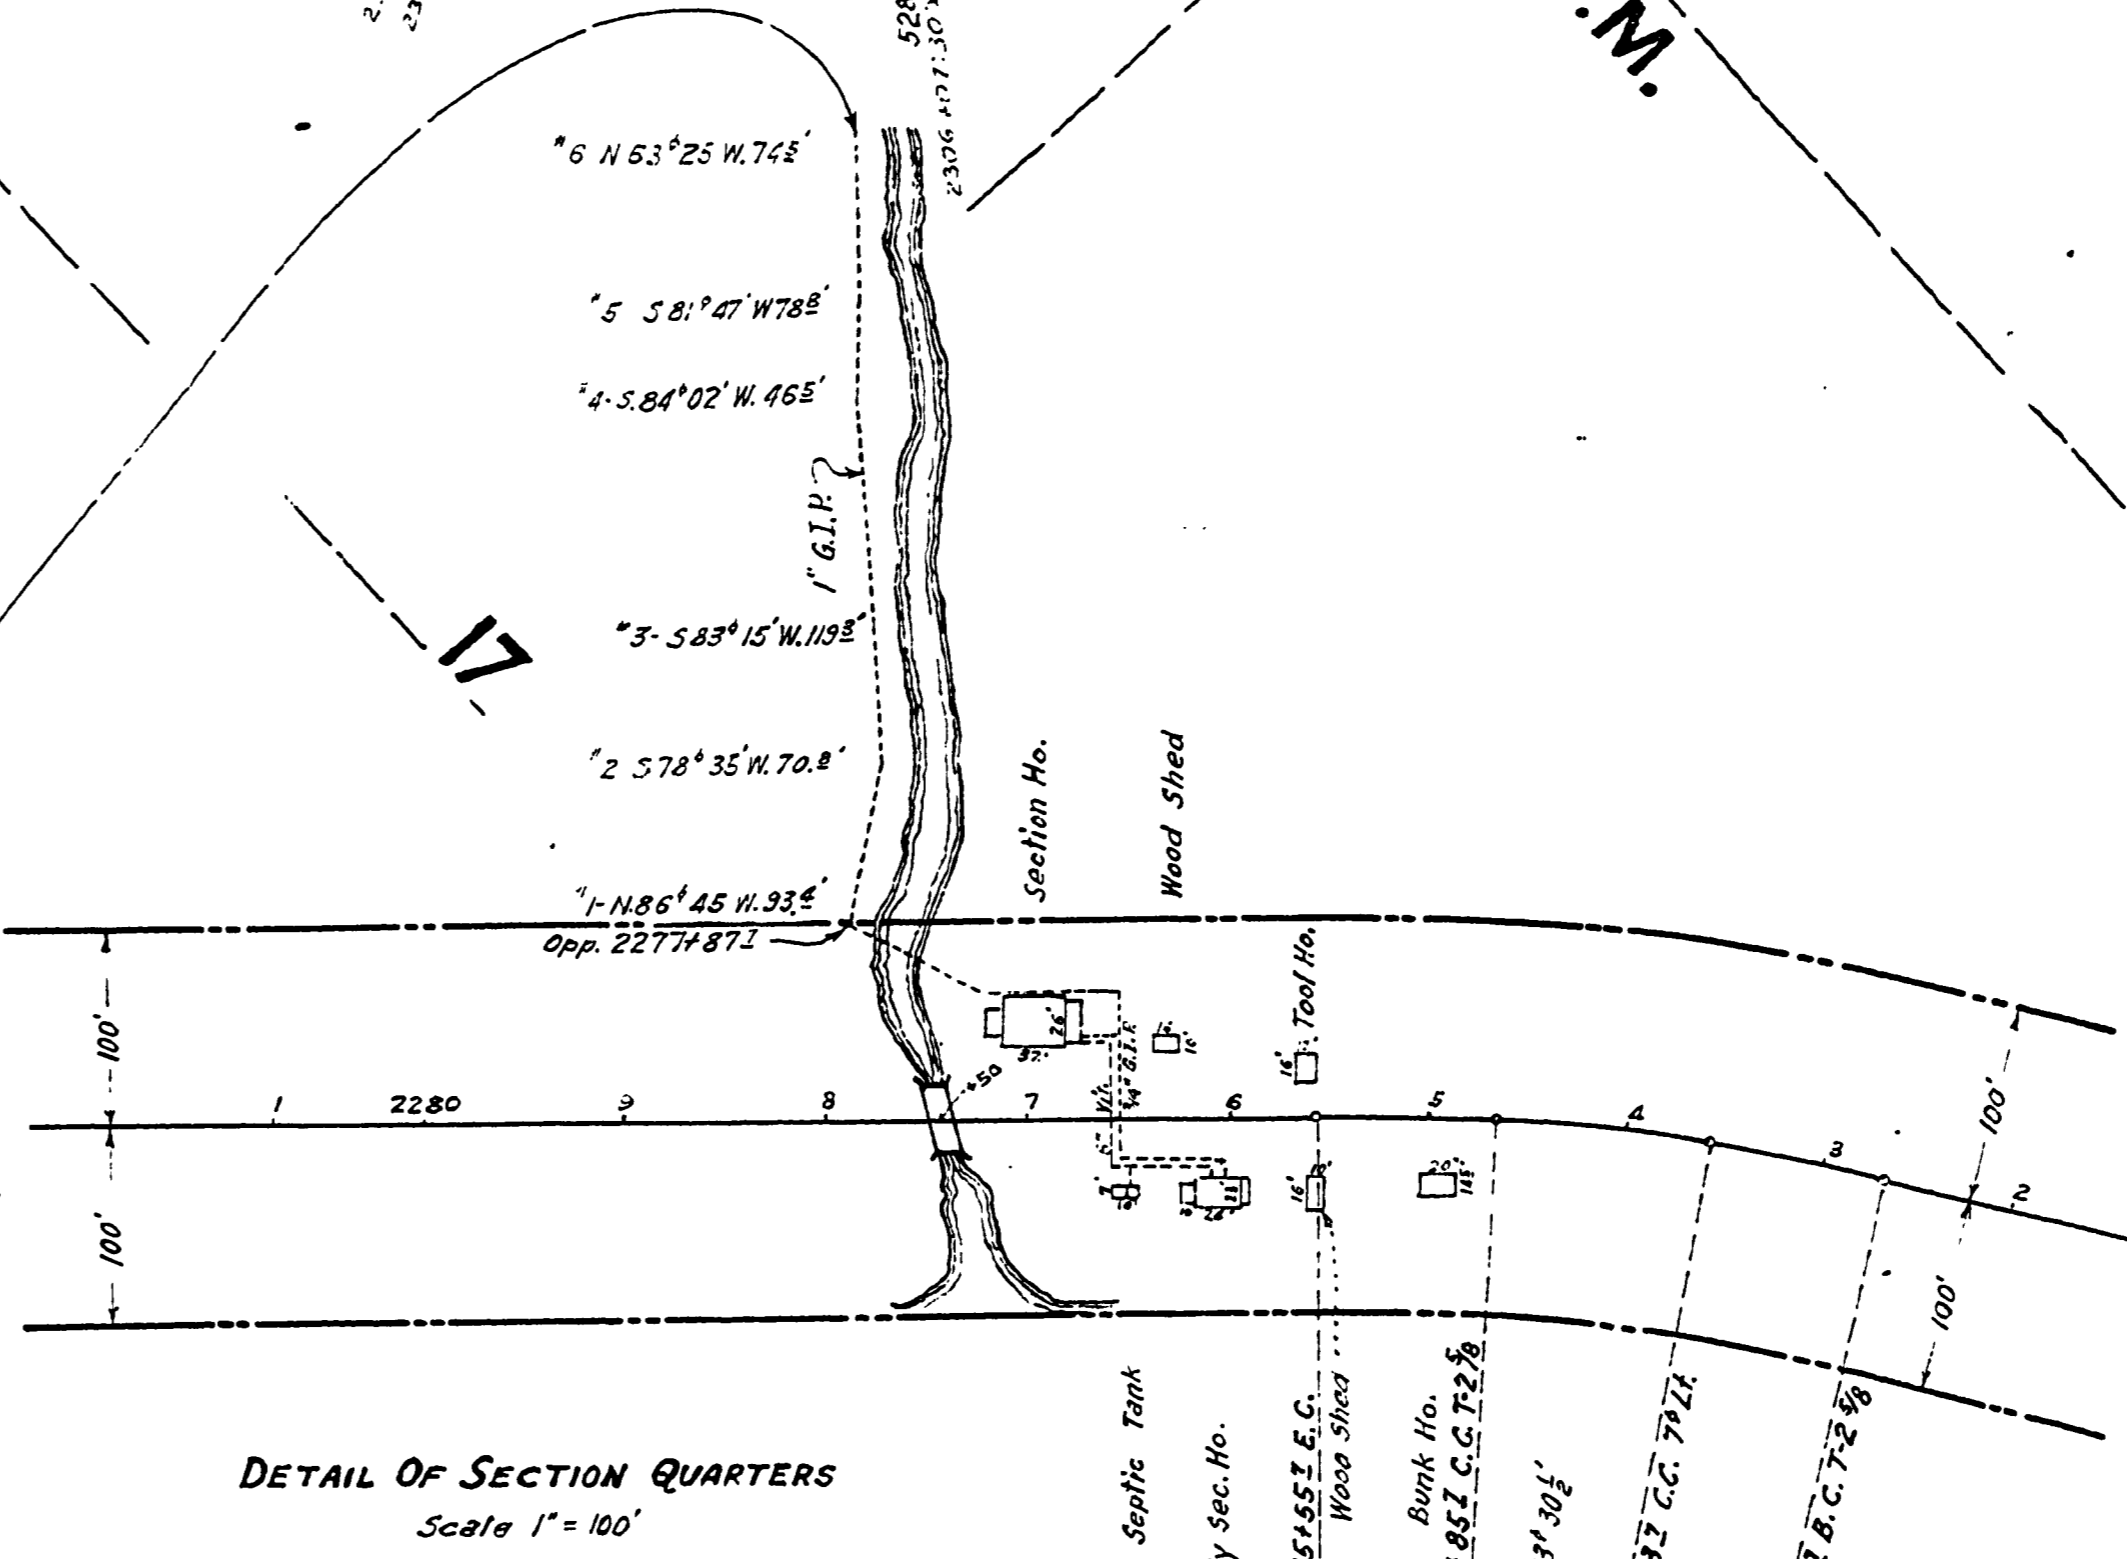


2360+00 Match mark for next sheet

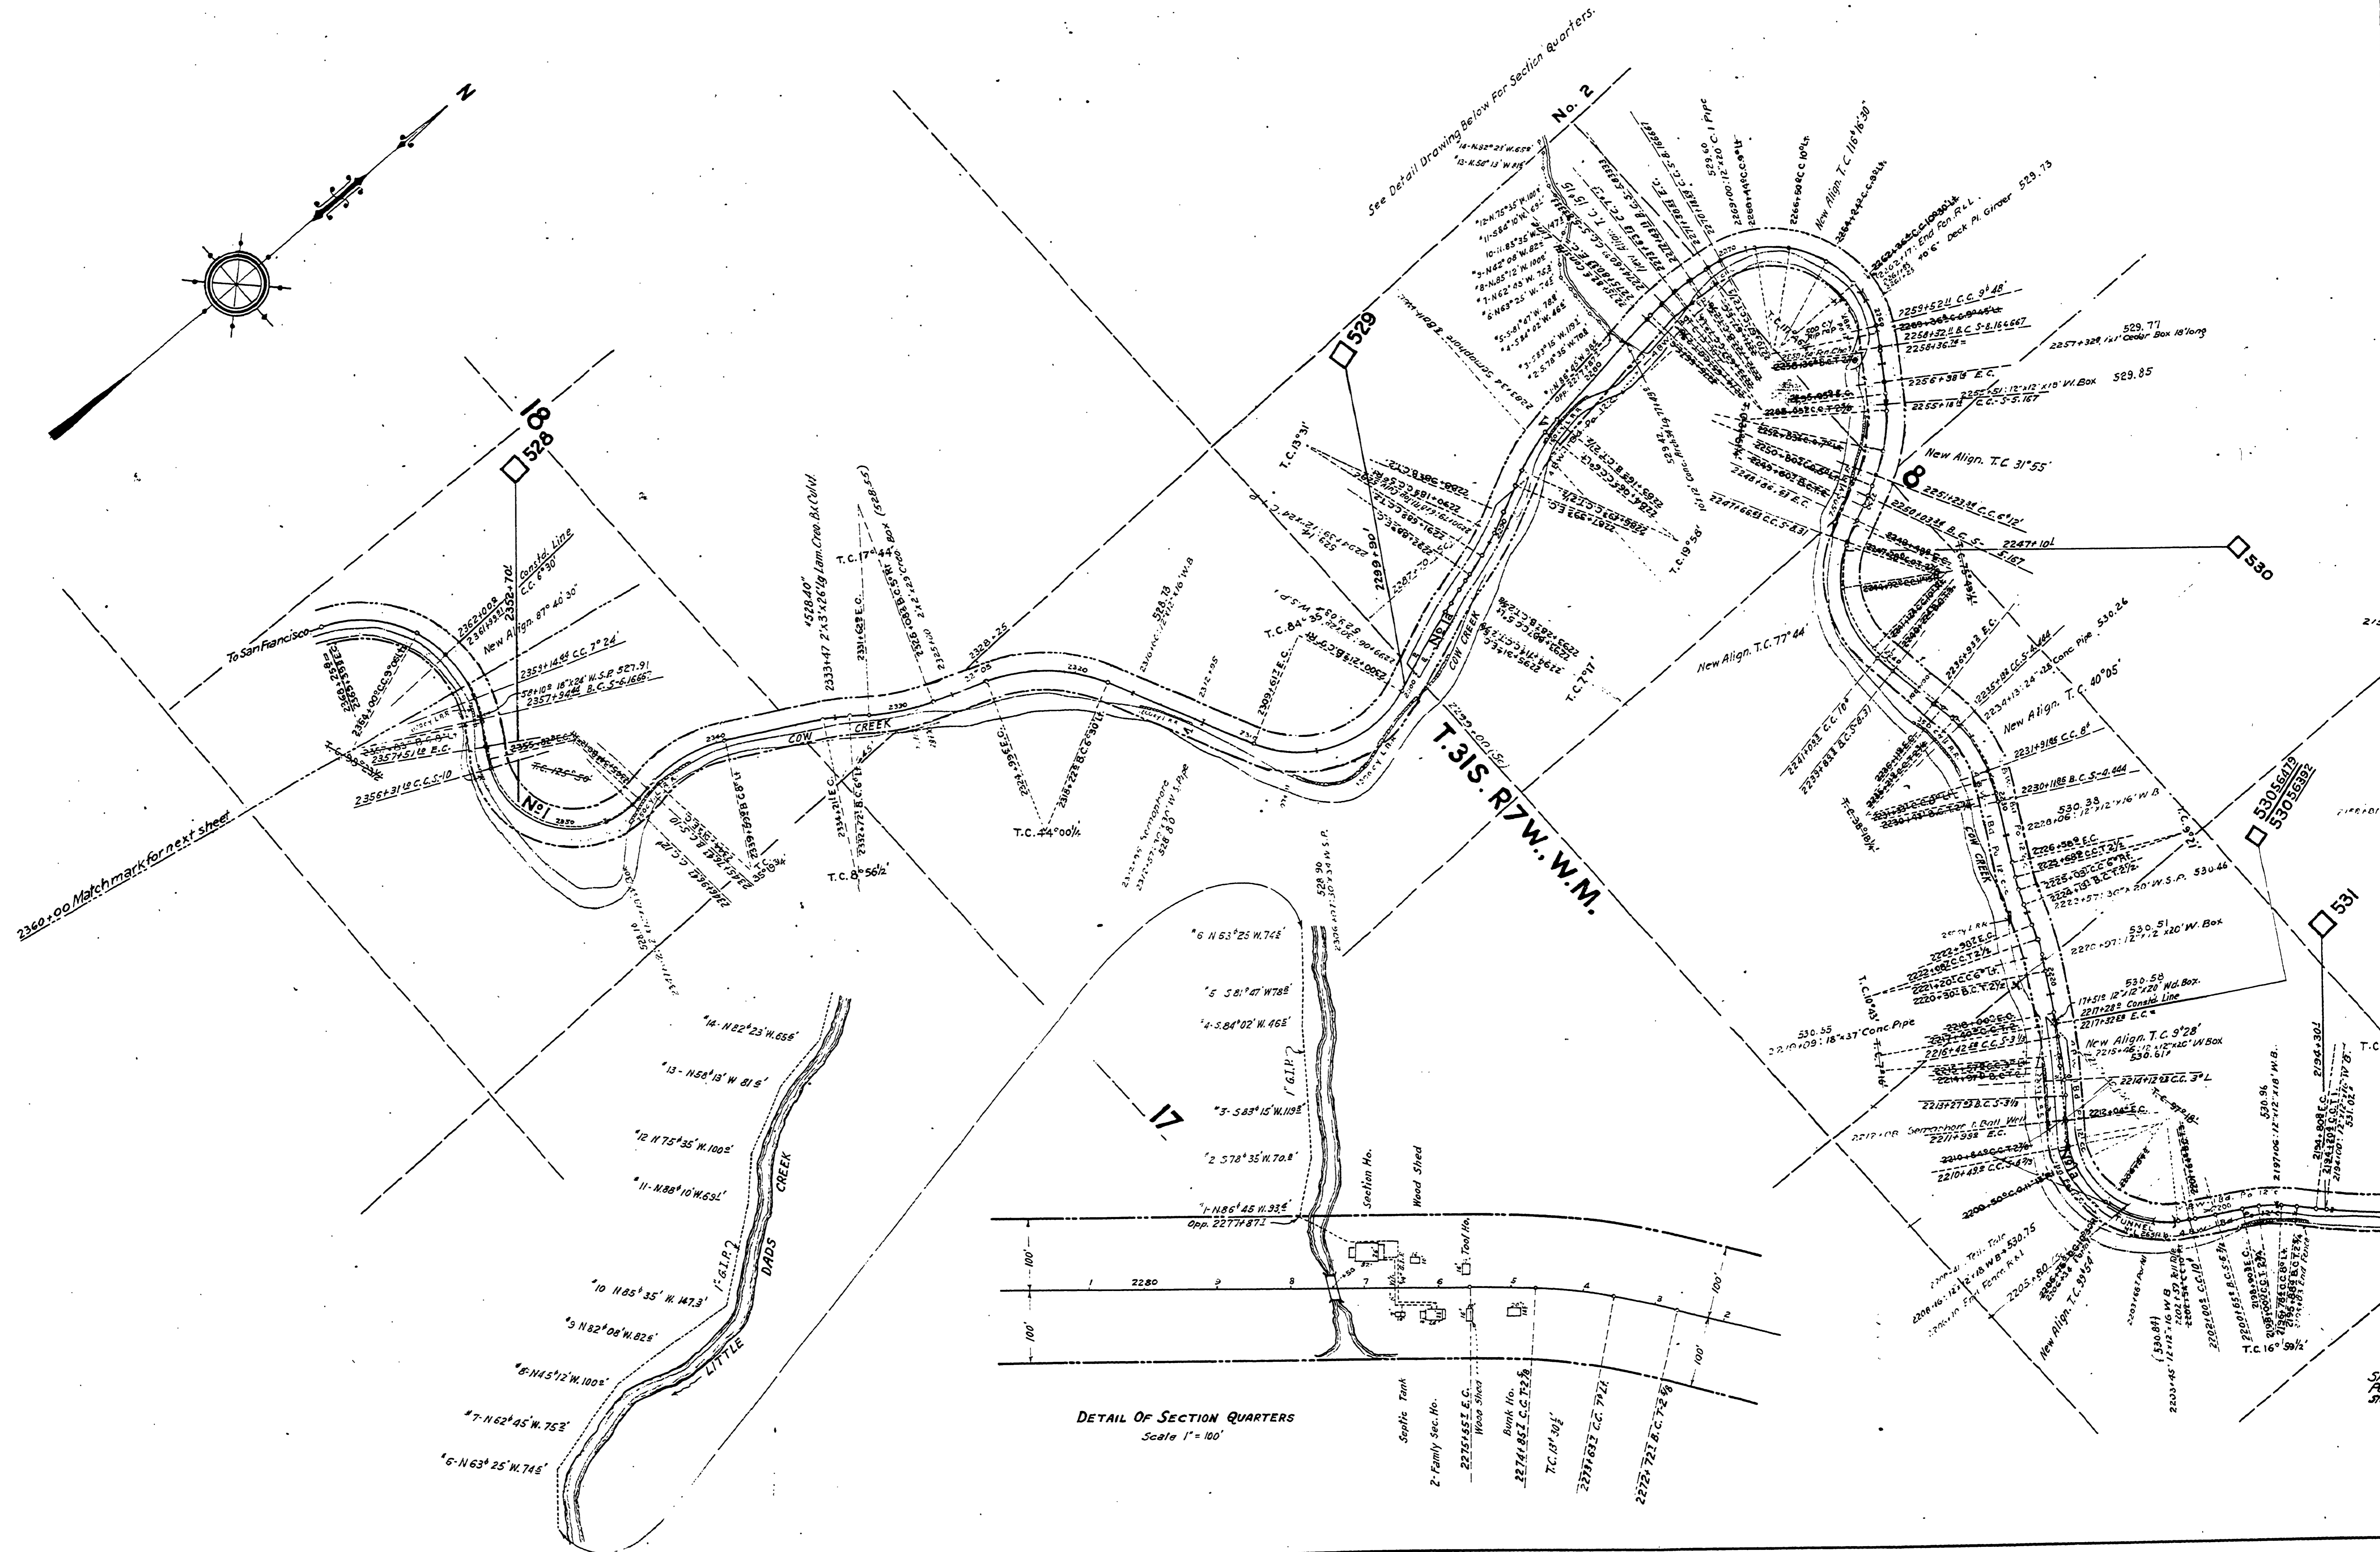

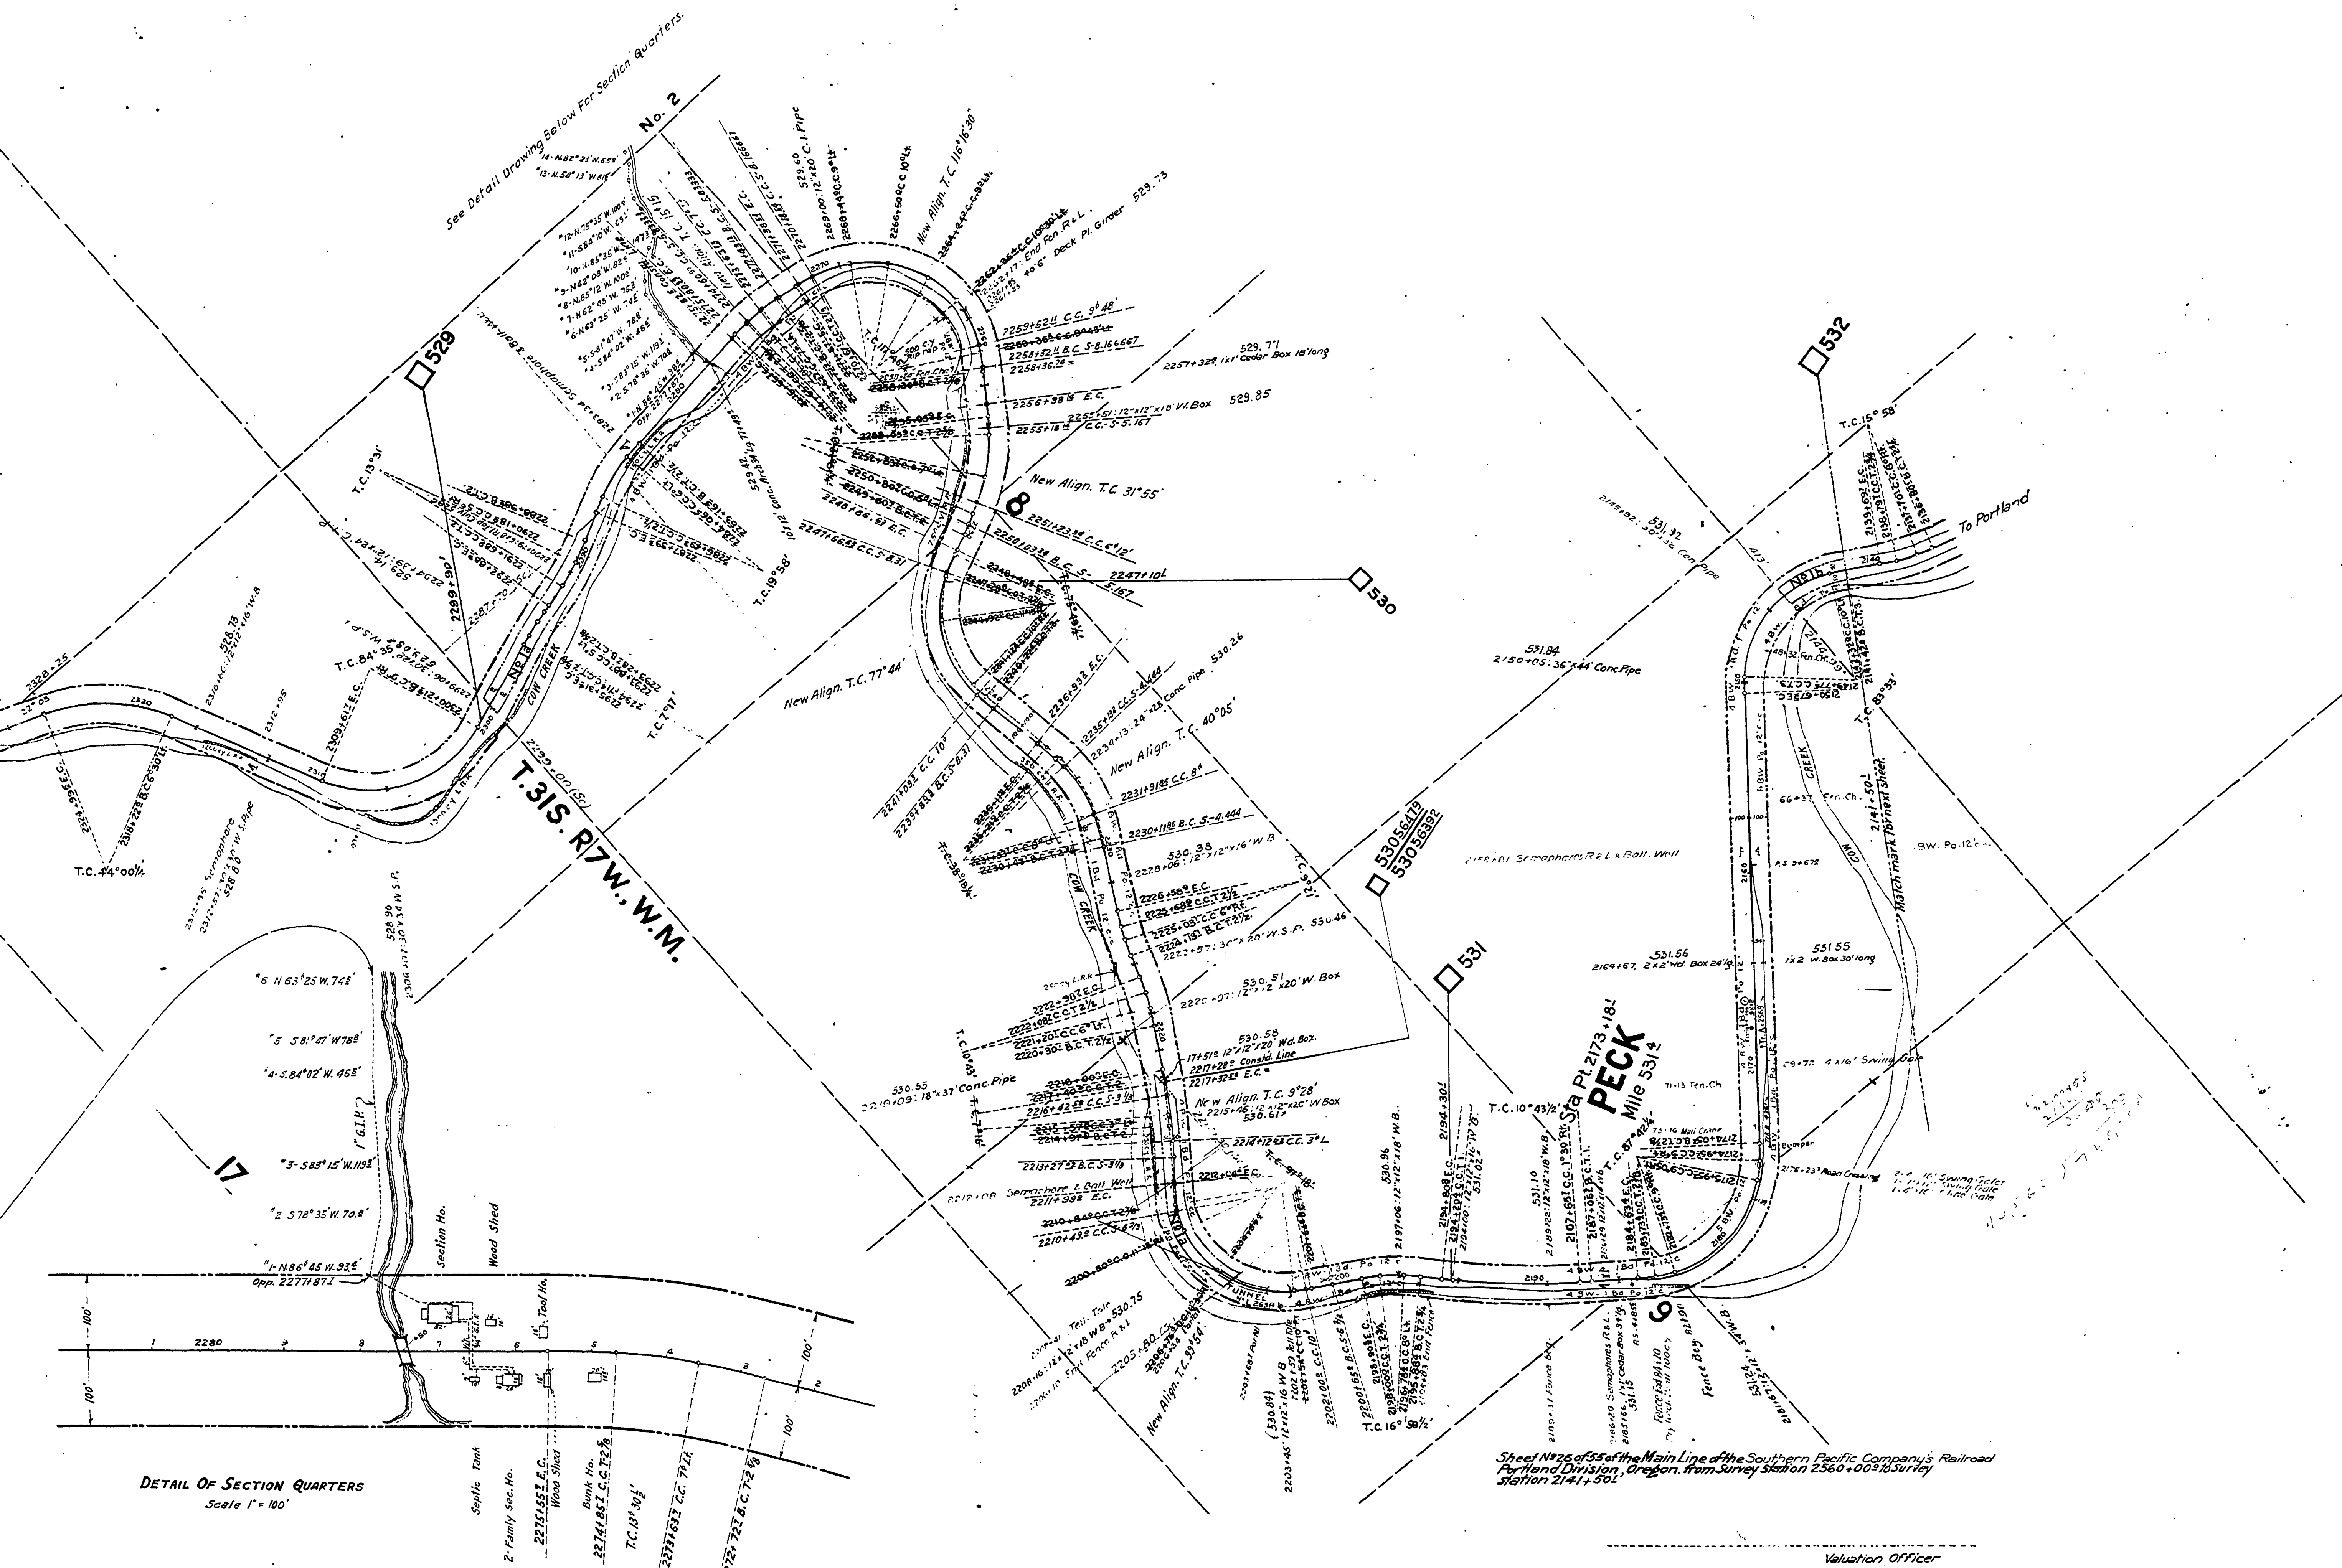

DETAIL OF SECTION QUARTERS
Scale 1" = 100'

Sheet No. 26 of 35 of the Main Line of the Southern Pacific Company's Railroad
Portland Division, Oregon, from Survey Station 2560+00 to Survey
Station 2141+50

Valuation Officer

RIGHT OF WAY AND TRACK MAP
MAIN LINE
SOUTHERN PACIFIC COMPANY
OPERATED BY
SOUTHERN PACIFIC COMPANY
PORTLAND DIVISION, COUSLAS COUNTY, OREGON
FROM STATION 2360+00 TO STATION 2141+50
Scale: 1 inch = 400 feet

VALUATION DEPARTMENT
SAN FRANCISCO, CALIFORNIA

RV16S26