
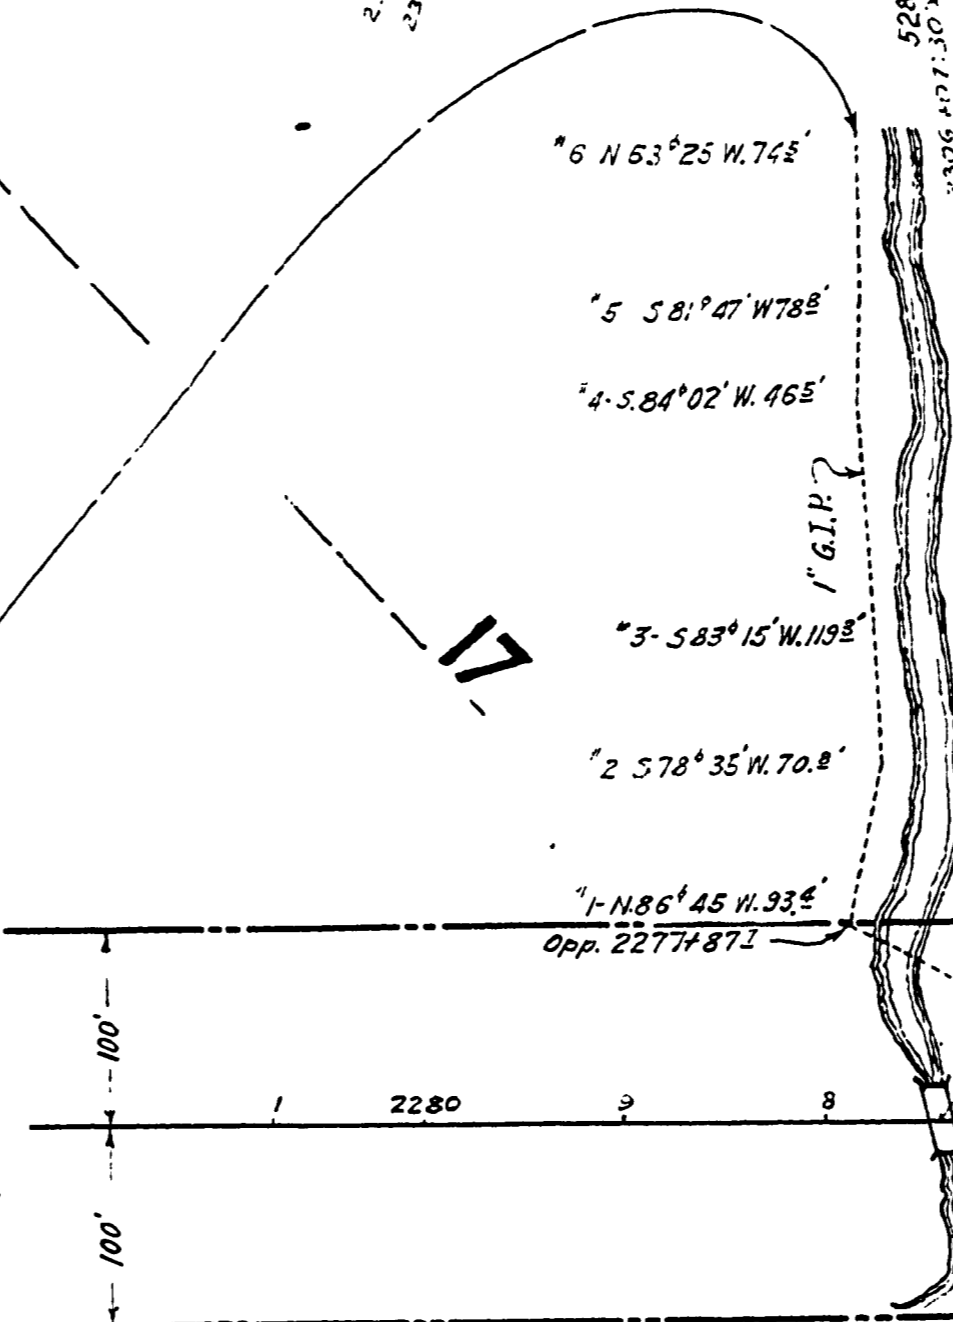


2360+00 Match mark for next sheet

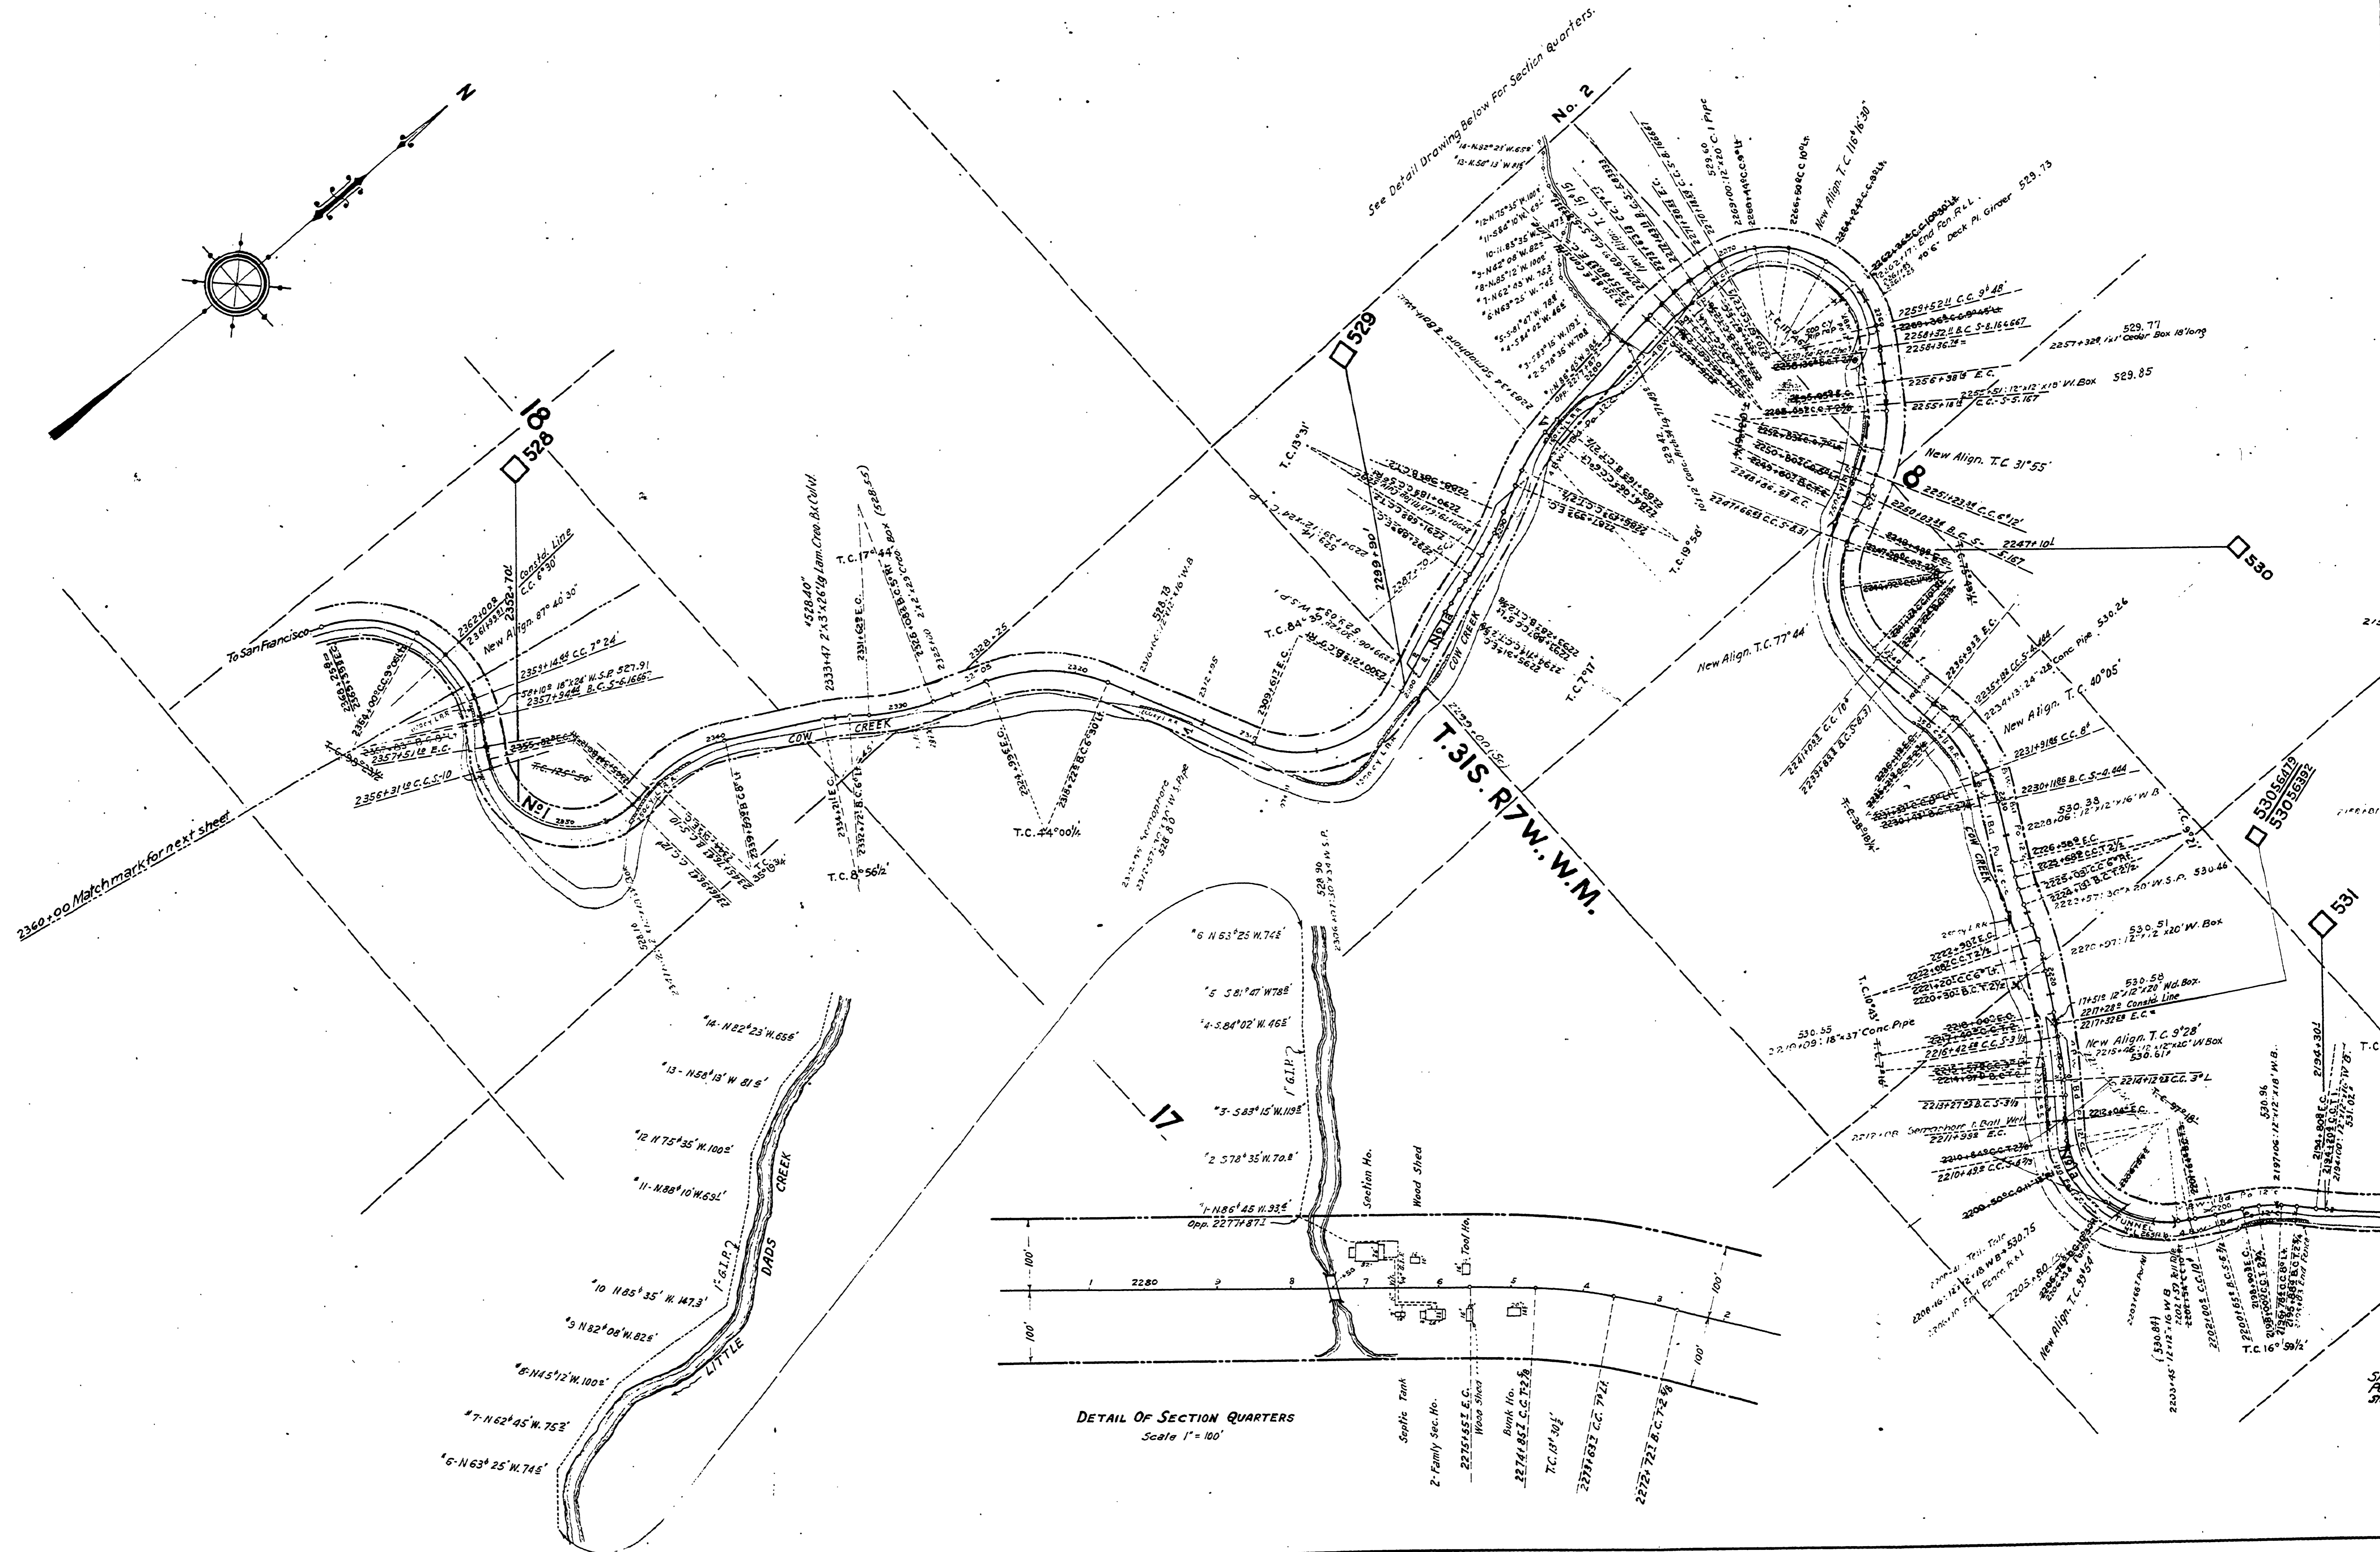

DETAIL OF SECTION QUARTERS  
Scale 1" = 100'

See Detail Drawing Below For Section Quarters

T.31S. R.7W. W.M.