


6

60728
41

33

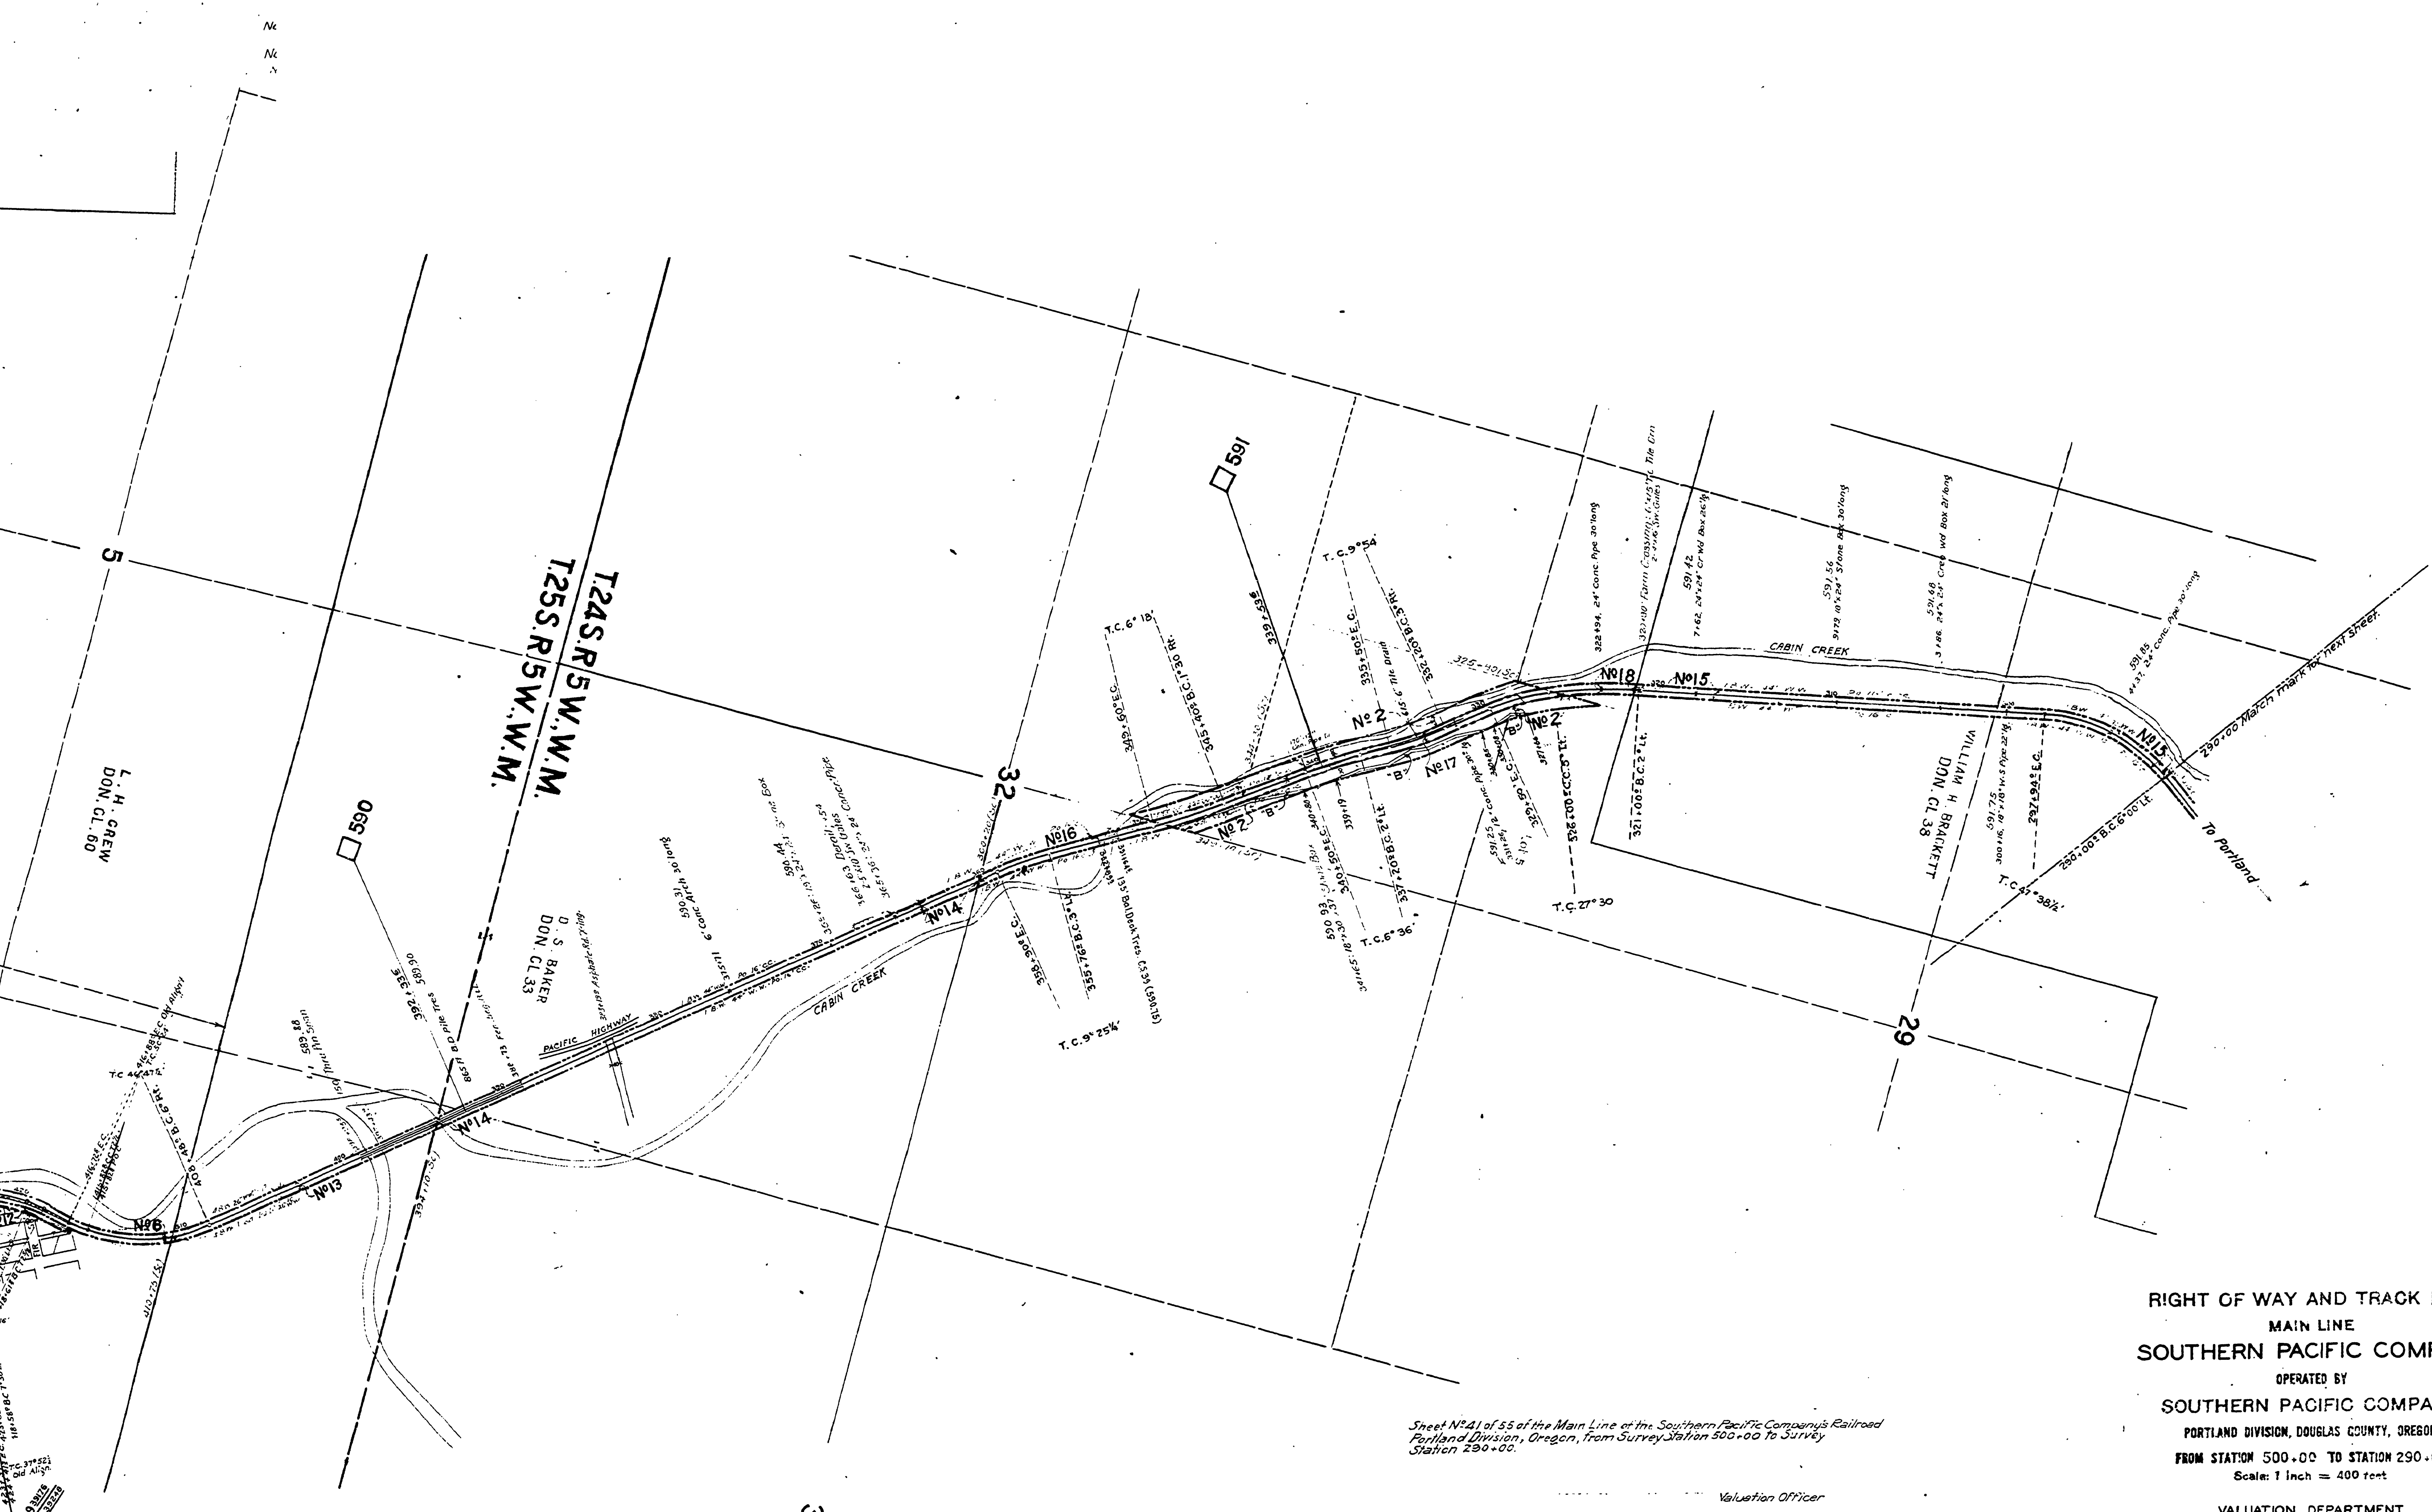

Sheet No. 41 of 55 of the Main Line of the Southern Pacific Company's Railroad
 Portland Division, Oregon, From Survey Station 500+00 To Survey
 Station 290+00.

Valuation Officer

RIGHT OF WAY AND TRACK MAP
 MAIN LINE
 SOUTHERN PACIFIC COMPANY
 OPERATED BY
 SOUTHERN PACIFIC COMPANY
 PORTLAND DIVISION, DOUGLAS COUNTY, OREGON
 FROM STATION 500+00 TO STATION 290+00
 Scale: 1 inch = 400 feet
 VALUATION DEPARTMENT
 SAN FRANCISCO, CALIFORNIA

V16
 41

33