


**DOUGLAS COUNTY HIGHWAY
IMPROVEMENT
PROFILE AND ALIGNMENT
TILLER - TRAIL
SECTION**
SECTION 11 TWP 31 S R 2 W WM.
TRACED FROM GOVERNMENT MAP
OFFICE OF
R. C. FEAR
COUNTY ROADMASTER
HORIZ. - 1" = 100'
SCALE VERT. - 1" = 10'

SHEET NO. 1

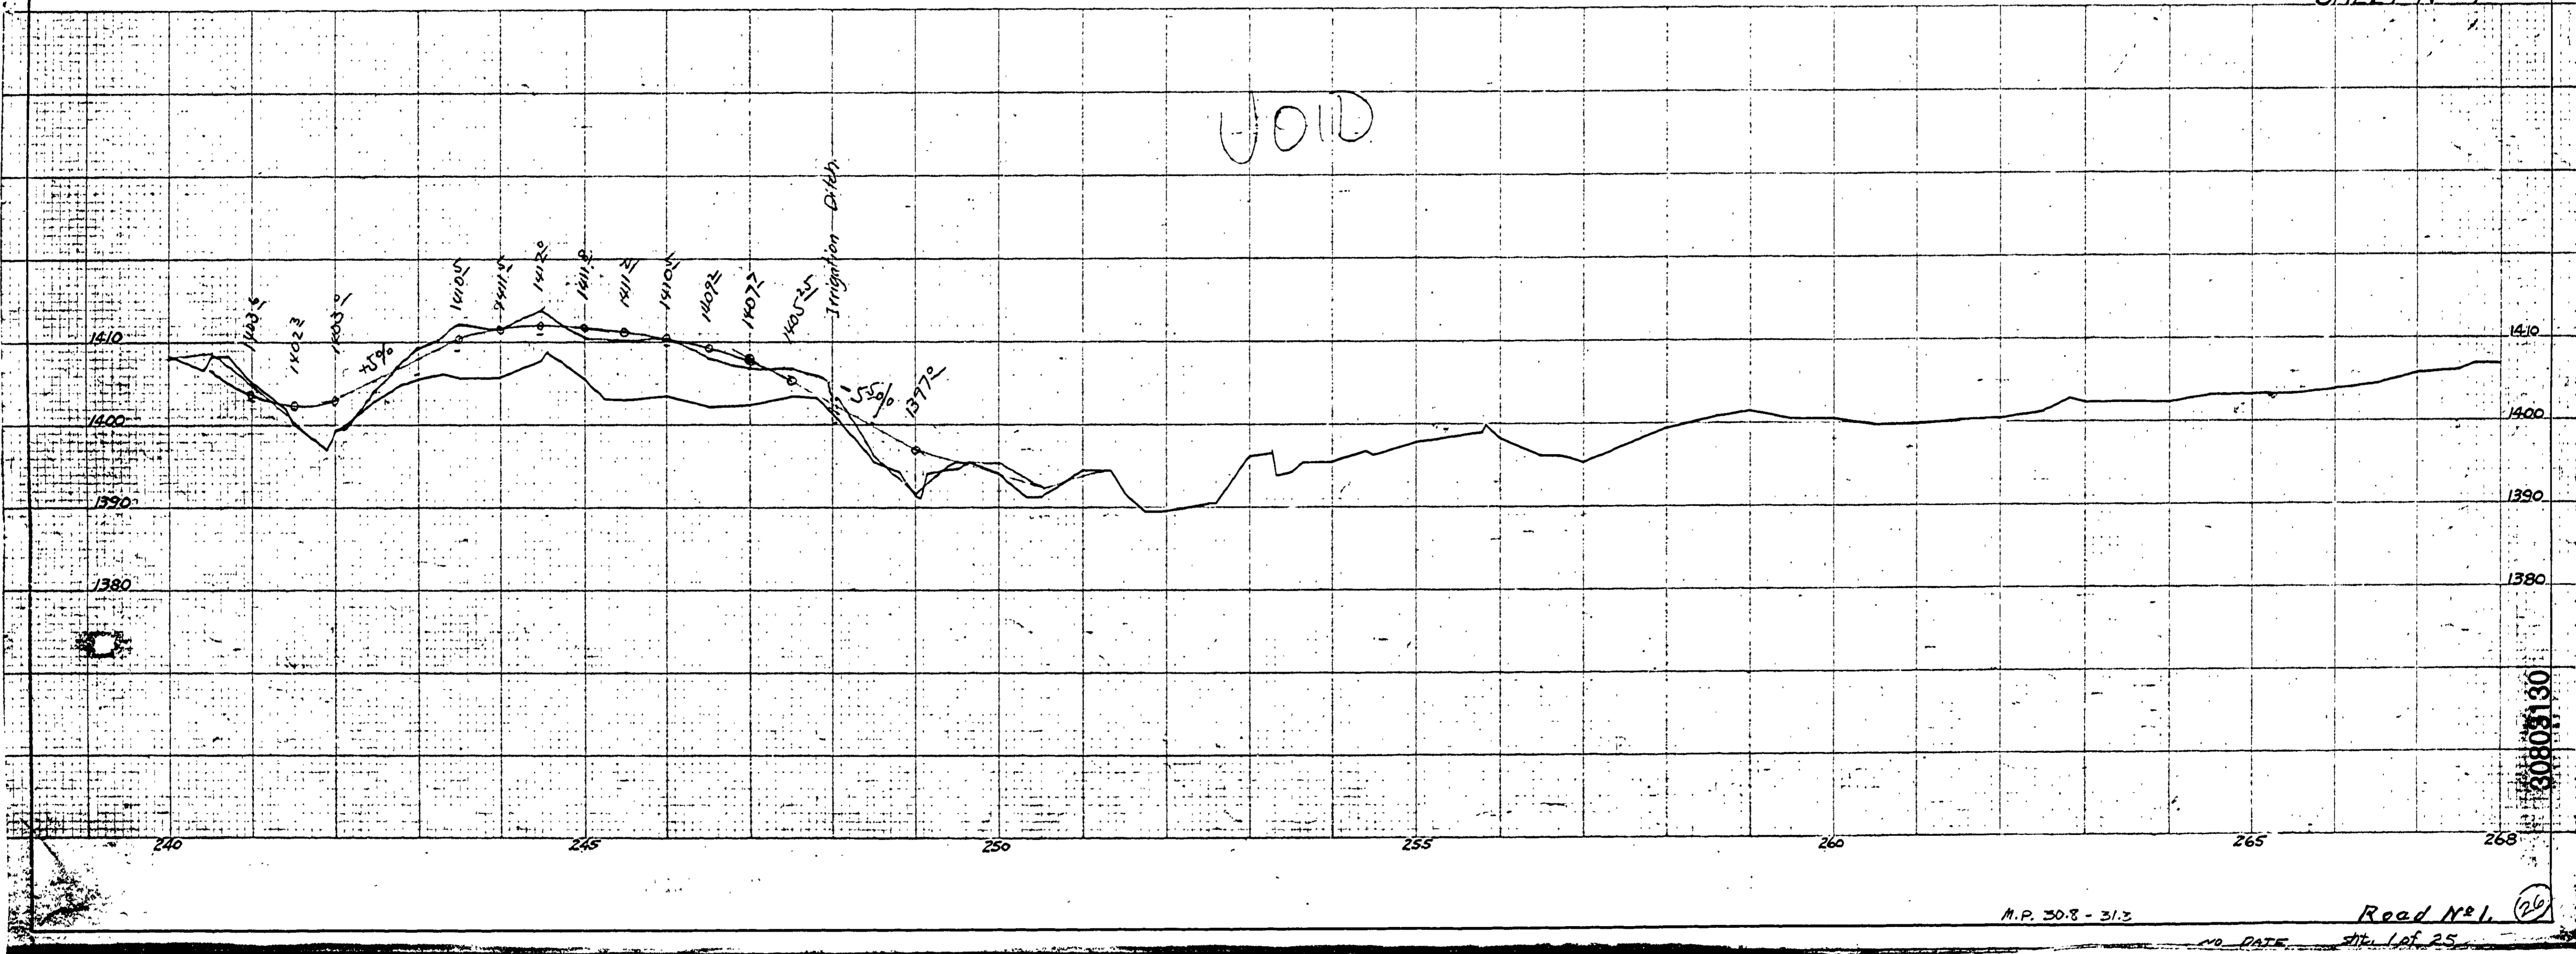

VOID

M.P. 30.8 - 31.3

Reed No. 1
DATE APR 25 1925

30 X

