


**DOUGLAS COUNTY HIGHWAY IMPROVEMENT**  
 PROFILE AND ALIGNMENT  
**TILLER - TRAIL**  
 SECTION  
 SEC. 29 TWP. 31S. R. 1W. W.M.  
 TRACED FROM GOVERNMENT MAP  
 OFFICE OF  
 R.C. FREAR  
 COUNTY ROADMASTER  
 SCALE HORIZ - 1" = 100'  
 SCALE VERT - 1" = 10'  
 MARKET RD #1

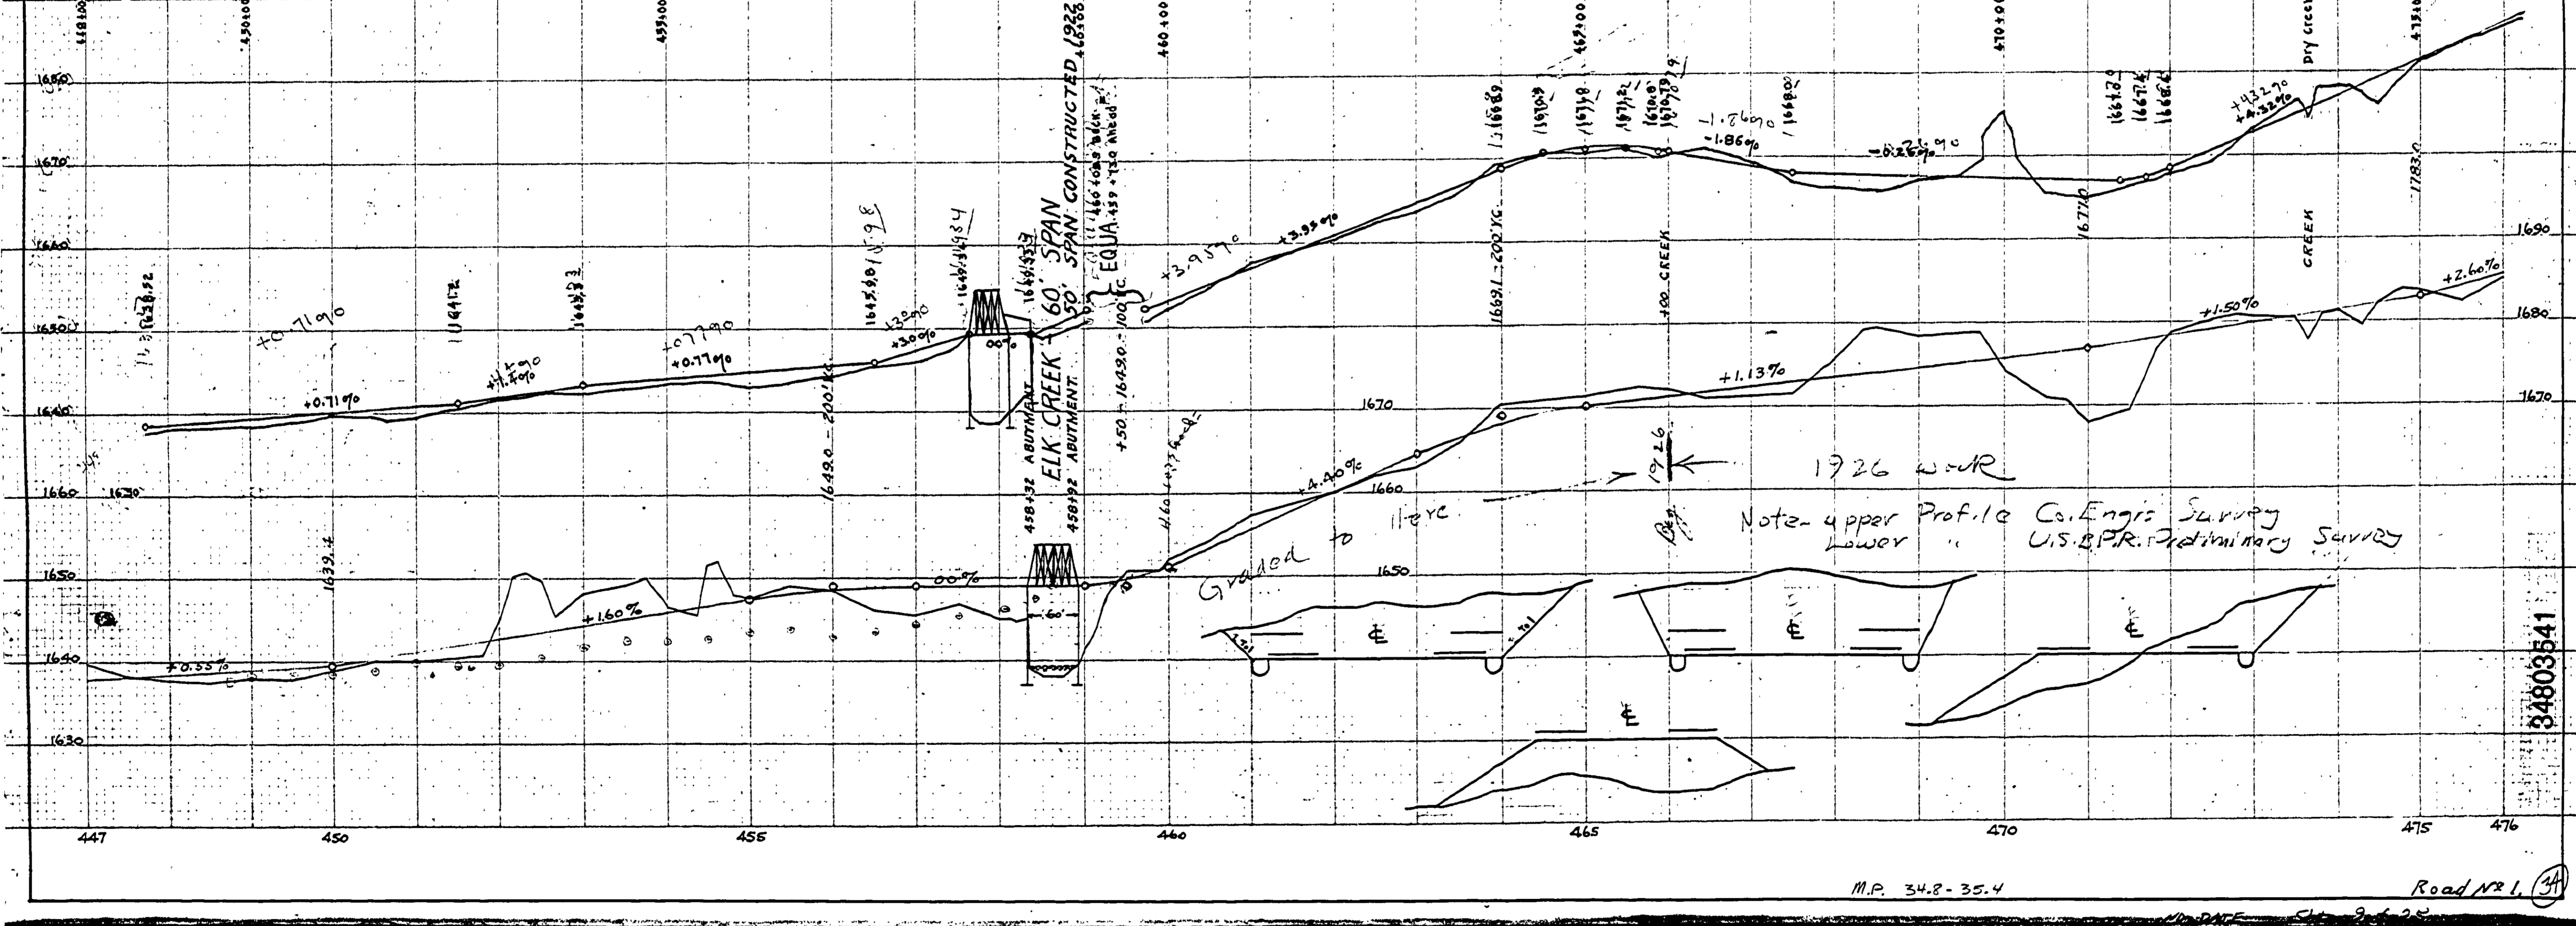

SHEET No 8

84803541

M.P. 34.2 - 35.4

Road No 1, (31)

30 X