




TYPICAL SECTIONS

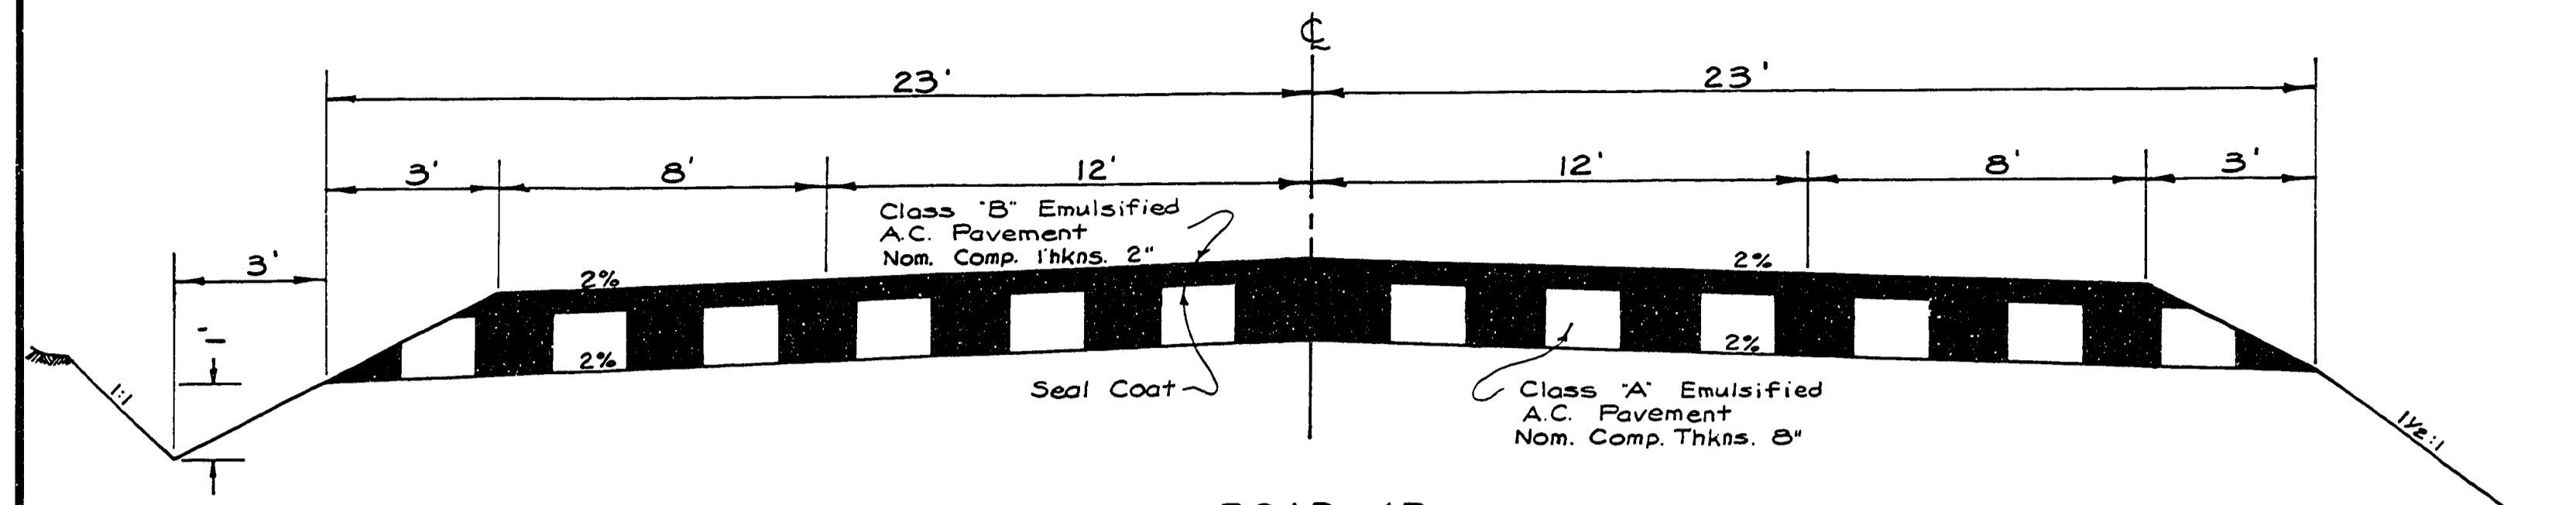

ROAD 4B  
Sta. 0+36.00 to Sta. 4+10.00

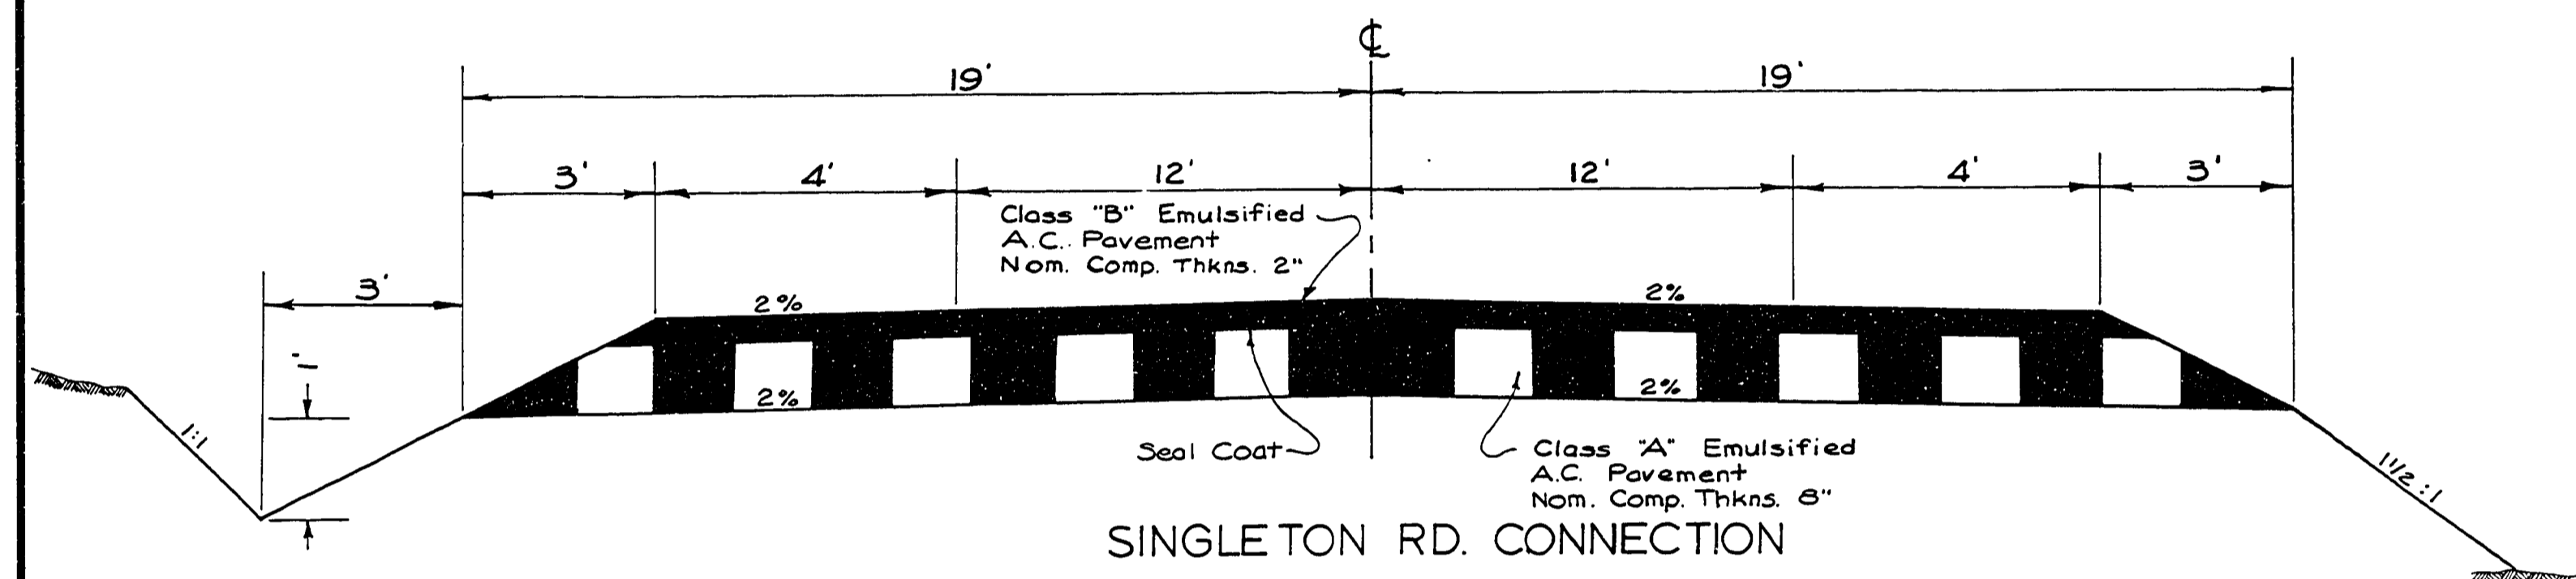


SINGLETON RD. CONNECTION

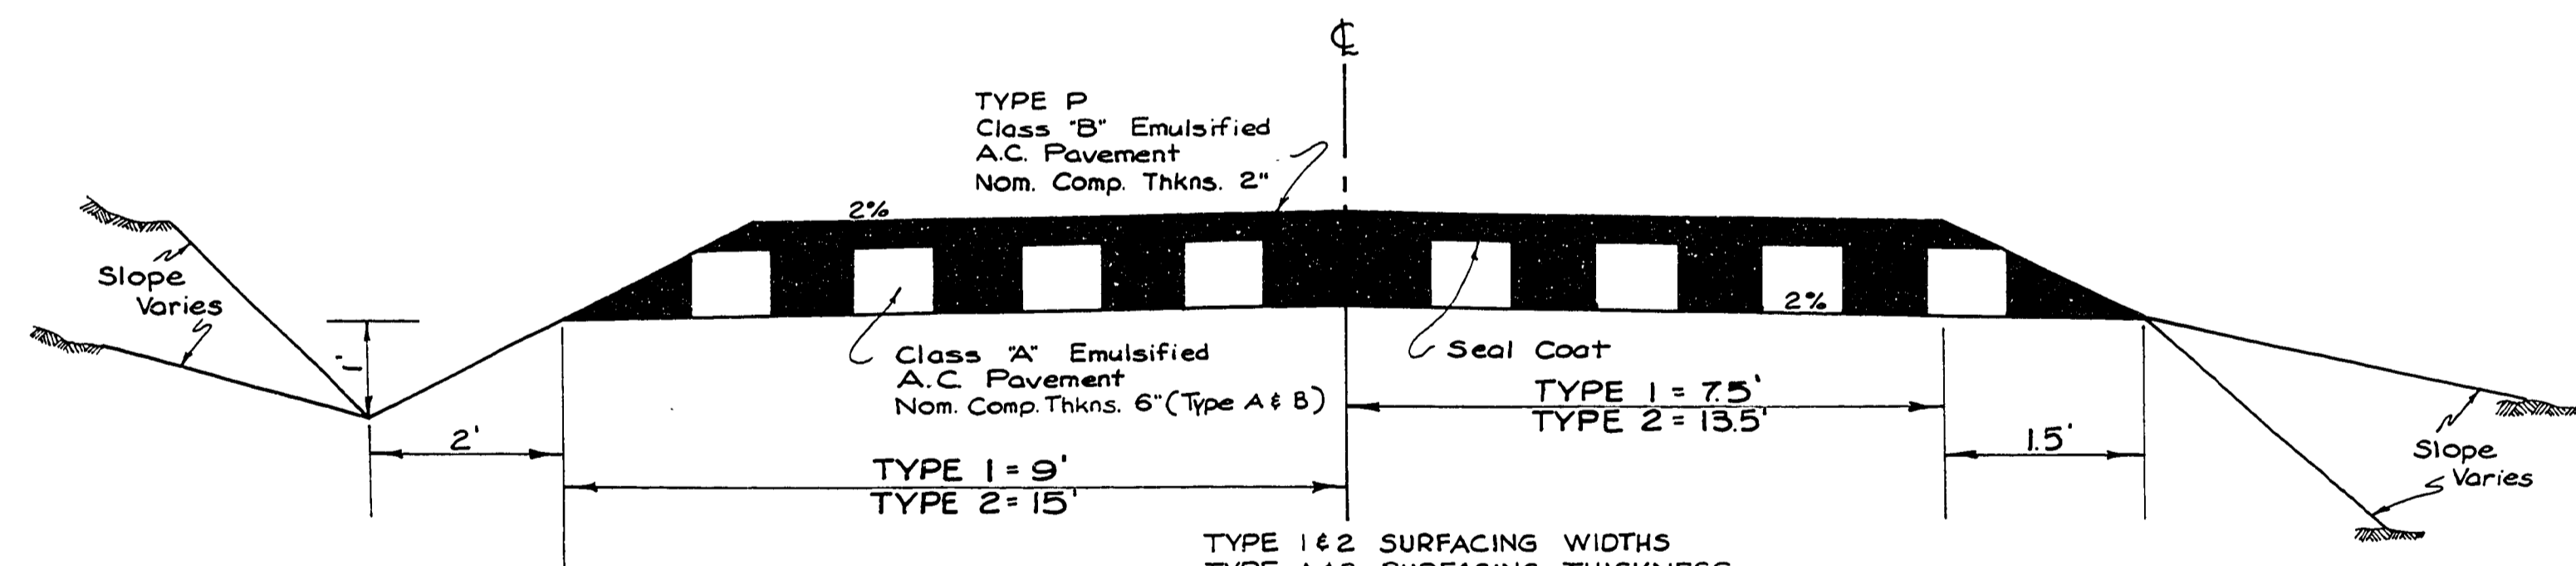


RURAL DRIVEWAY & ROAD APPROACH

TYPE 1 & 2 SURFACING WIDTHS  
TYPE A & B SURFACING THICKNESS  
TYPE P (P SIGNIFIES PAVING REQUIRED)

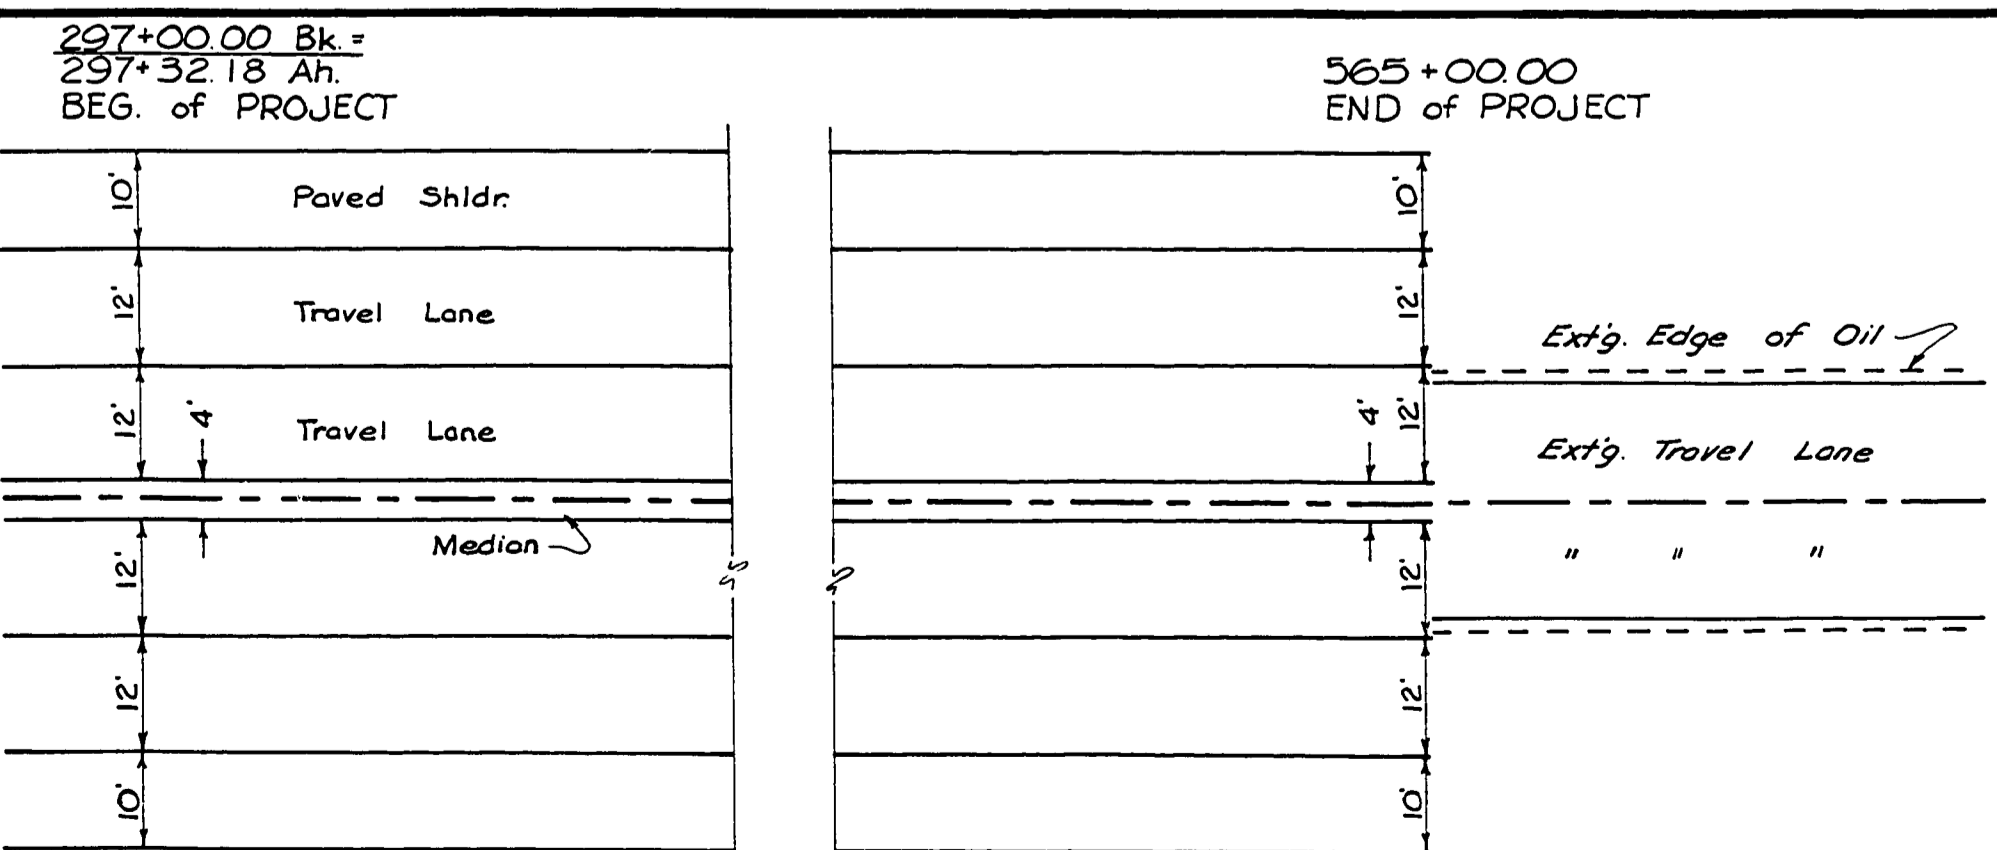

WIDTHS FOR ROAD 4

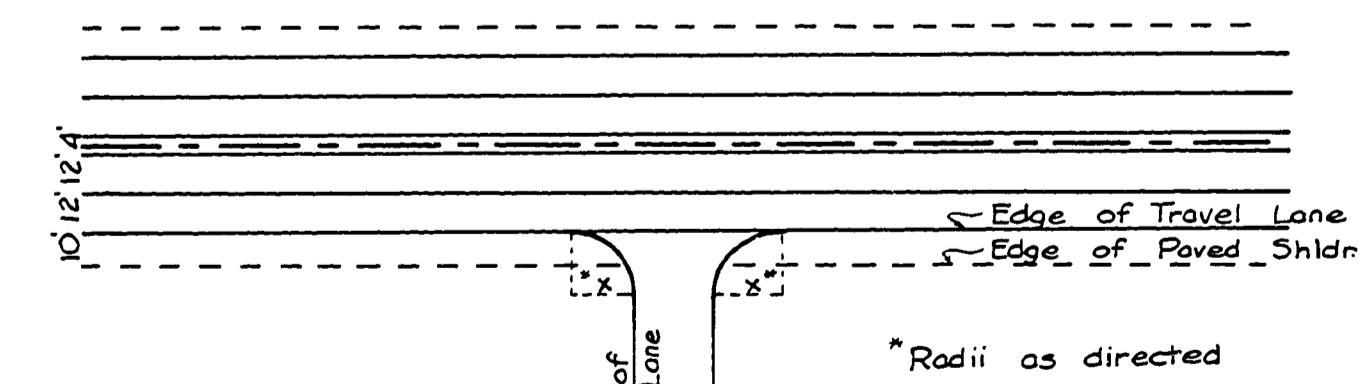

RADIUS PLAN  
MINOR ROADS & DRIVEWAYS

NOT REVISED  
AS CONSTRUCTED

Douglas County Road Dept.  
NORTH UMPQUA HWY. # 4  
Date: April 1970 Sheet 4  
GEORGE E. GRUBB County Engineer

0000DRWY