


**INTERSECTION PLAN**

STA 618+50  
 NORTH UMPQUA HWY RD #4 WITH THE  
 FOLLOWING ROADS  
 WHISTLERS LANE RD #223  
 GLIDE DISPOSAL SITE RD #318

NOTE: CROSS HATCHING DENOTES  
 PAINTED MEDIAN AREA

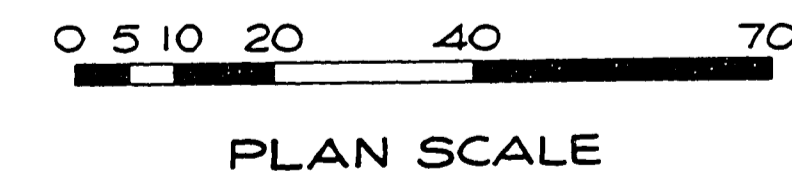

NOT REVISED  
 AS CONSTRUCTED

DOUGLAS COUNTY ROAD DEPT.  
 NORTH UMPQUA HWY RD #4  
 1972 SHT 5  
 GEORGE E. GRUBB COUNTY ENGR.

00001TR