
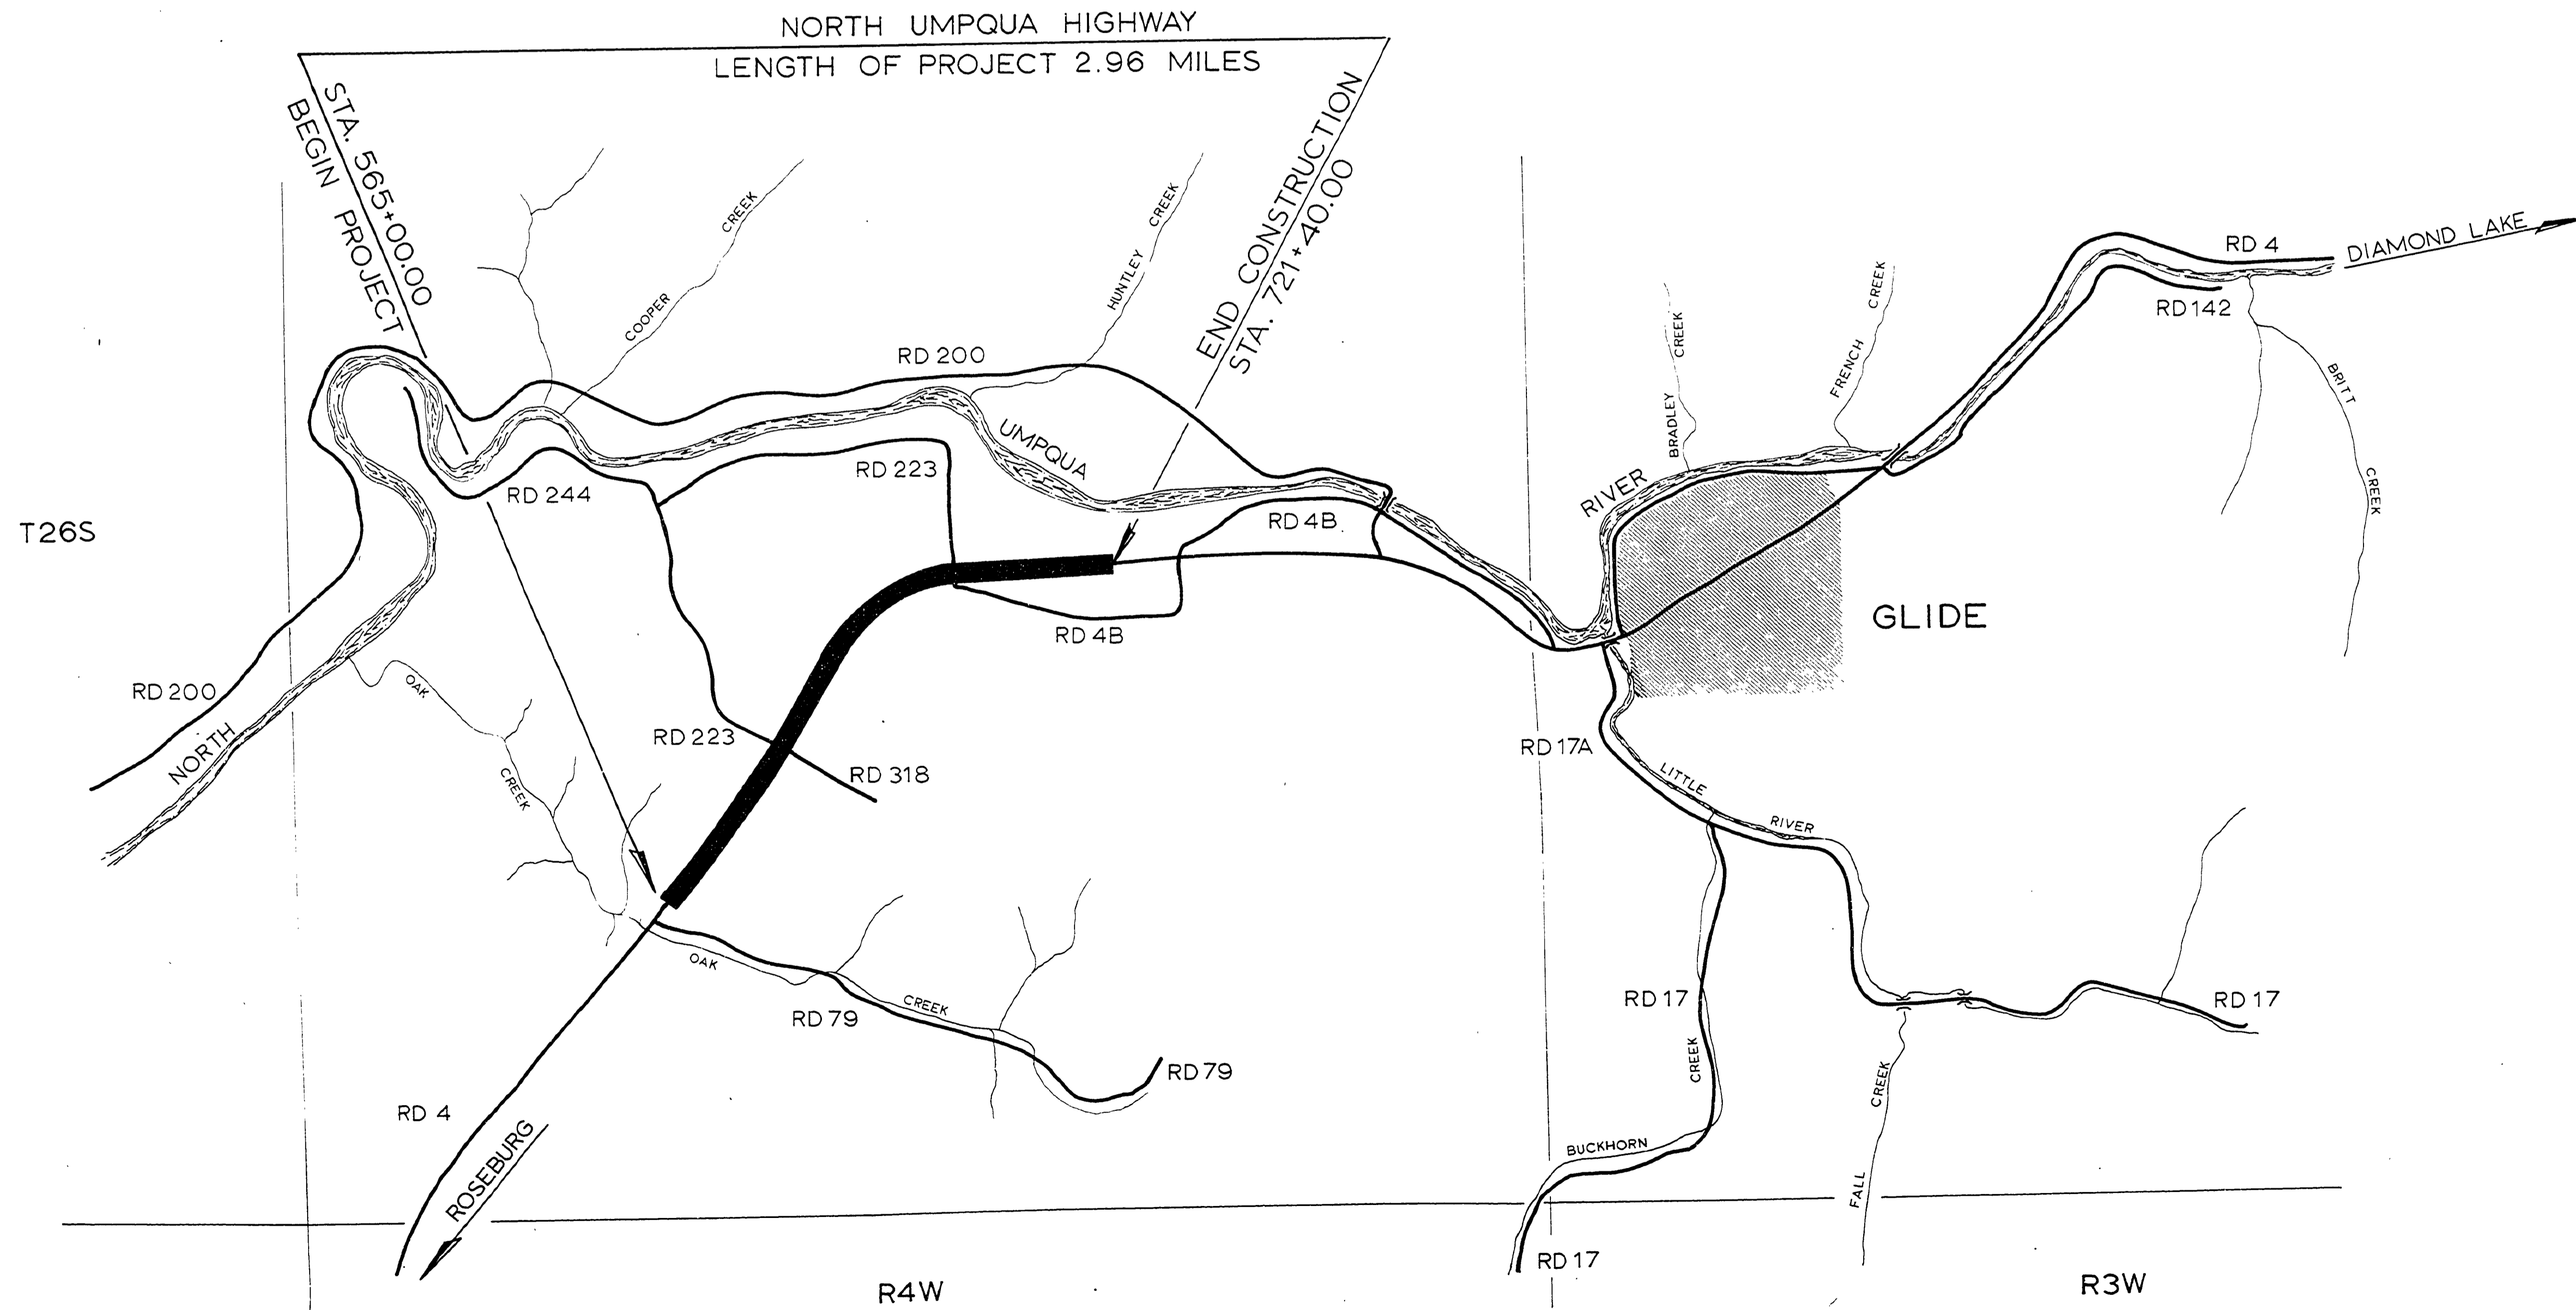


DOUGLAS COUNTY, OREGON  
 PLANS FOR PROPOSED PROJECT  
 GRADING & SURFACING  
**NORTH UMPQUA HIGHWAY**  
**COUNTY ROAD NO. 4**  
 MILE POINT 10.67 TO MILE POINT 13.63

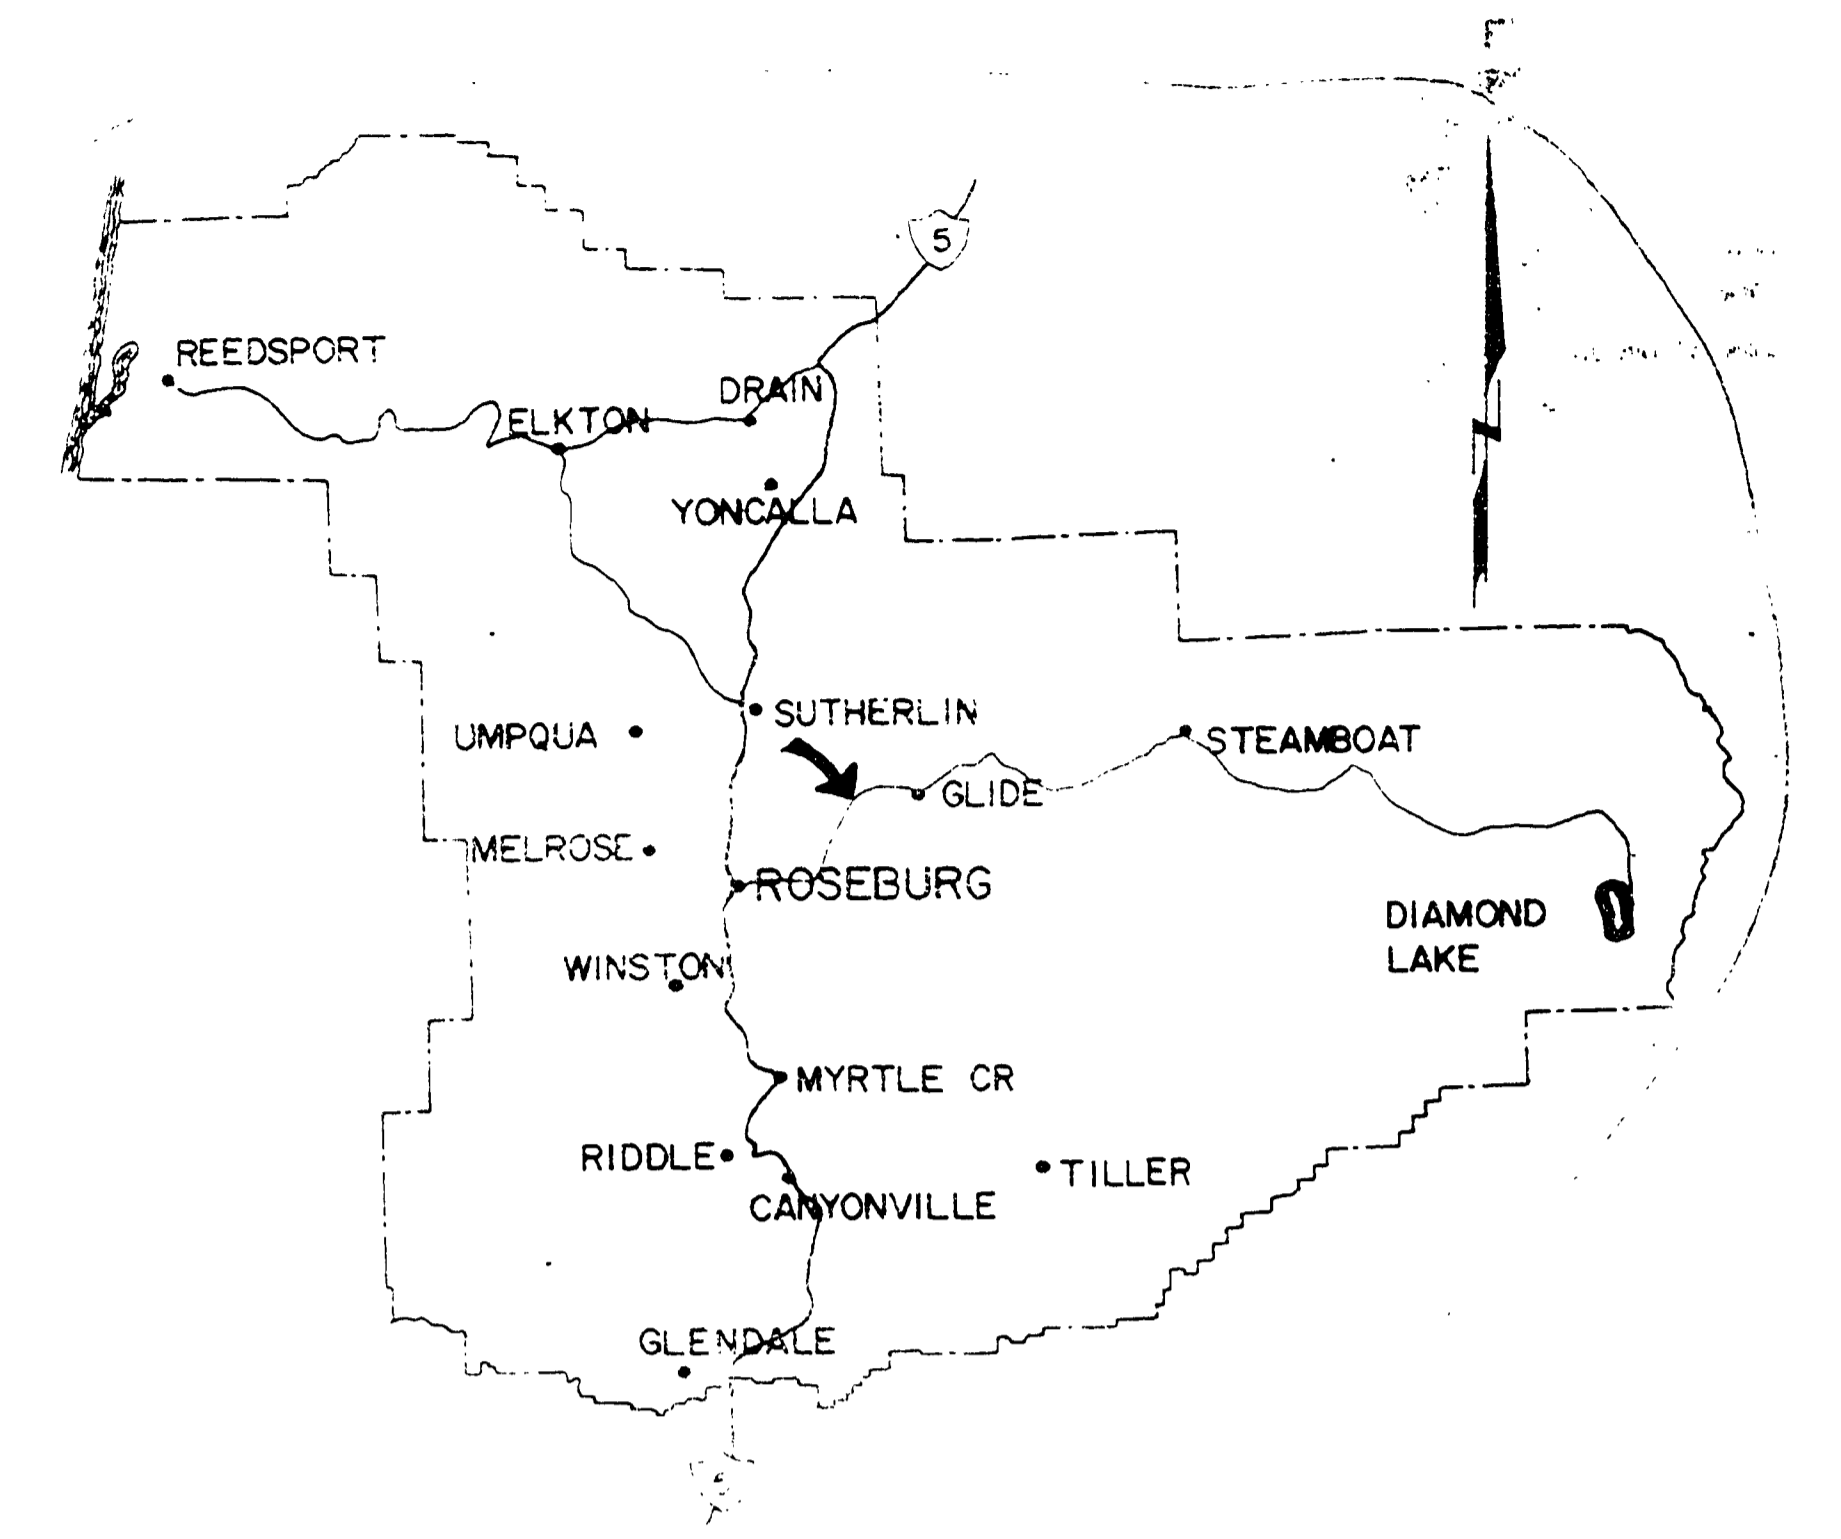

**INDEX OF DRAWINGS**

SHEET NUMBER	TITLE
1	TITLE SHEET
2	QUANTITY SUMMARY & ROAD TYPICAL
3 & 4	TYPICAL SECTIONS
5 & 6	INTERSECTION PLANS
7 THRU 12	ROAD PLANS

STANDARD DRAWINGS  
 1,5,9,13&14  
 TOTAL OF 17 SHEETS



NOT REVISED  
 AS CONSTRUCTED  
 DOUGLAS COUNTY ROAD DEPT.  
**NORTH UMPQUA HIGHWAY RD.#4**  
 1972 SHT 1  
 GEORGE E. GRUBB COUNTY ENG.

1070136C

