


MP11

SEC 21,28 T26S R4W W.M.

RD 4

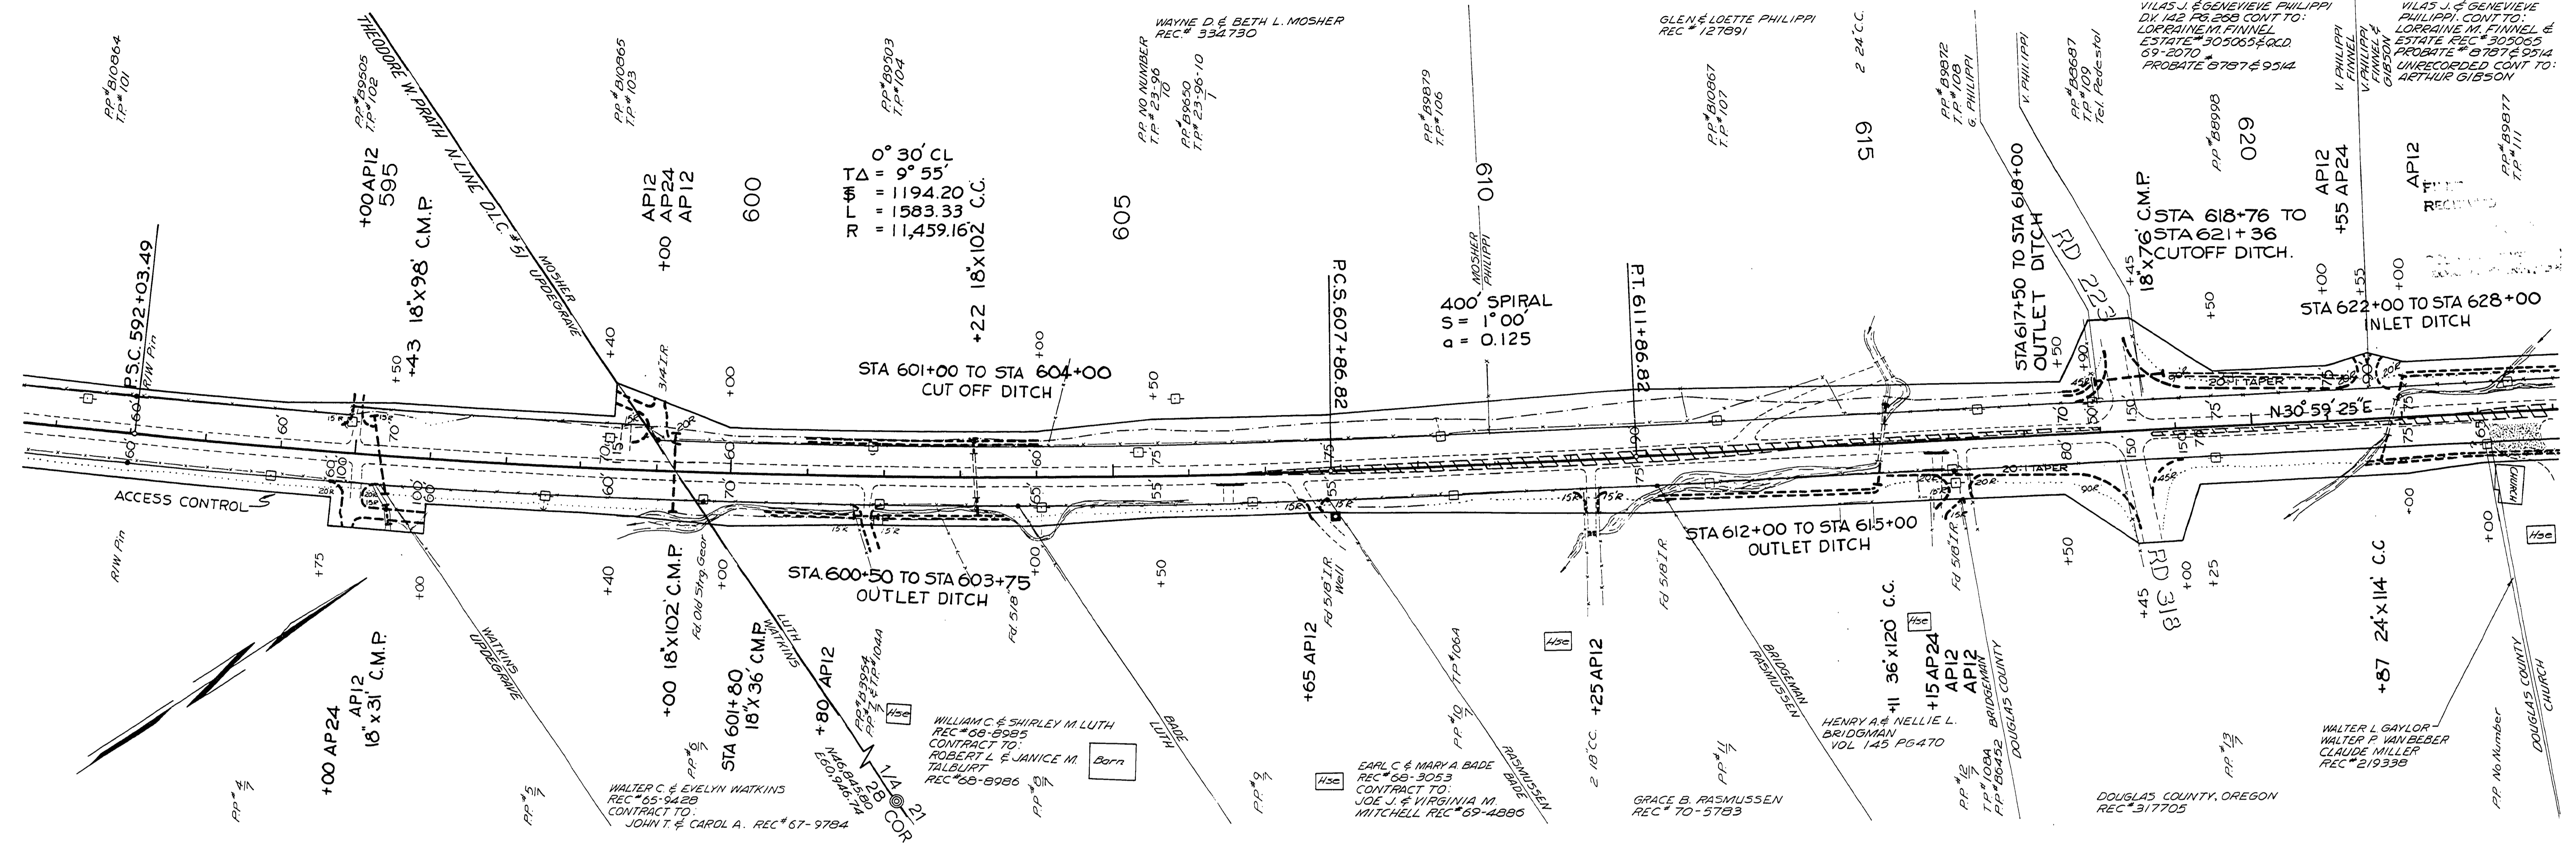

8-19-74
 REVISED AS BUILT PH
 DOUGLAS COUNTY ROAD DEPT
 NORTH UMPQUA HWY RD #4
 1972 SHT B
 GEORGE E. GRUBB COUNTY ENGR.

11391198