


SEC. 15 T26S R 4W W.M.

RD 4

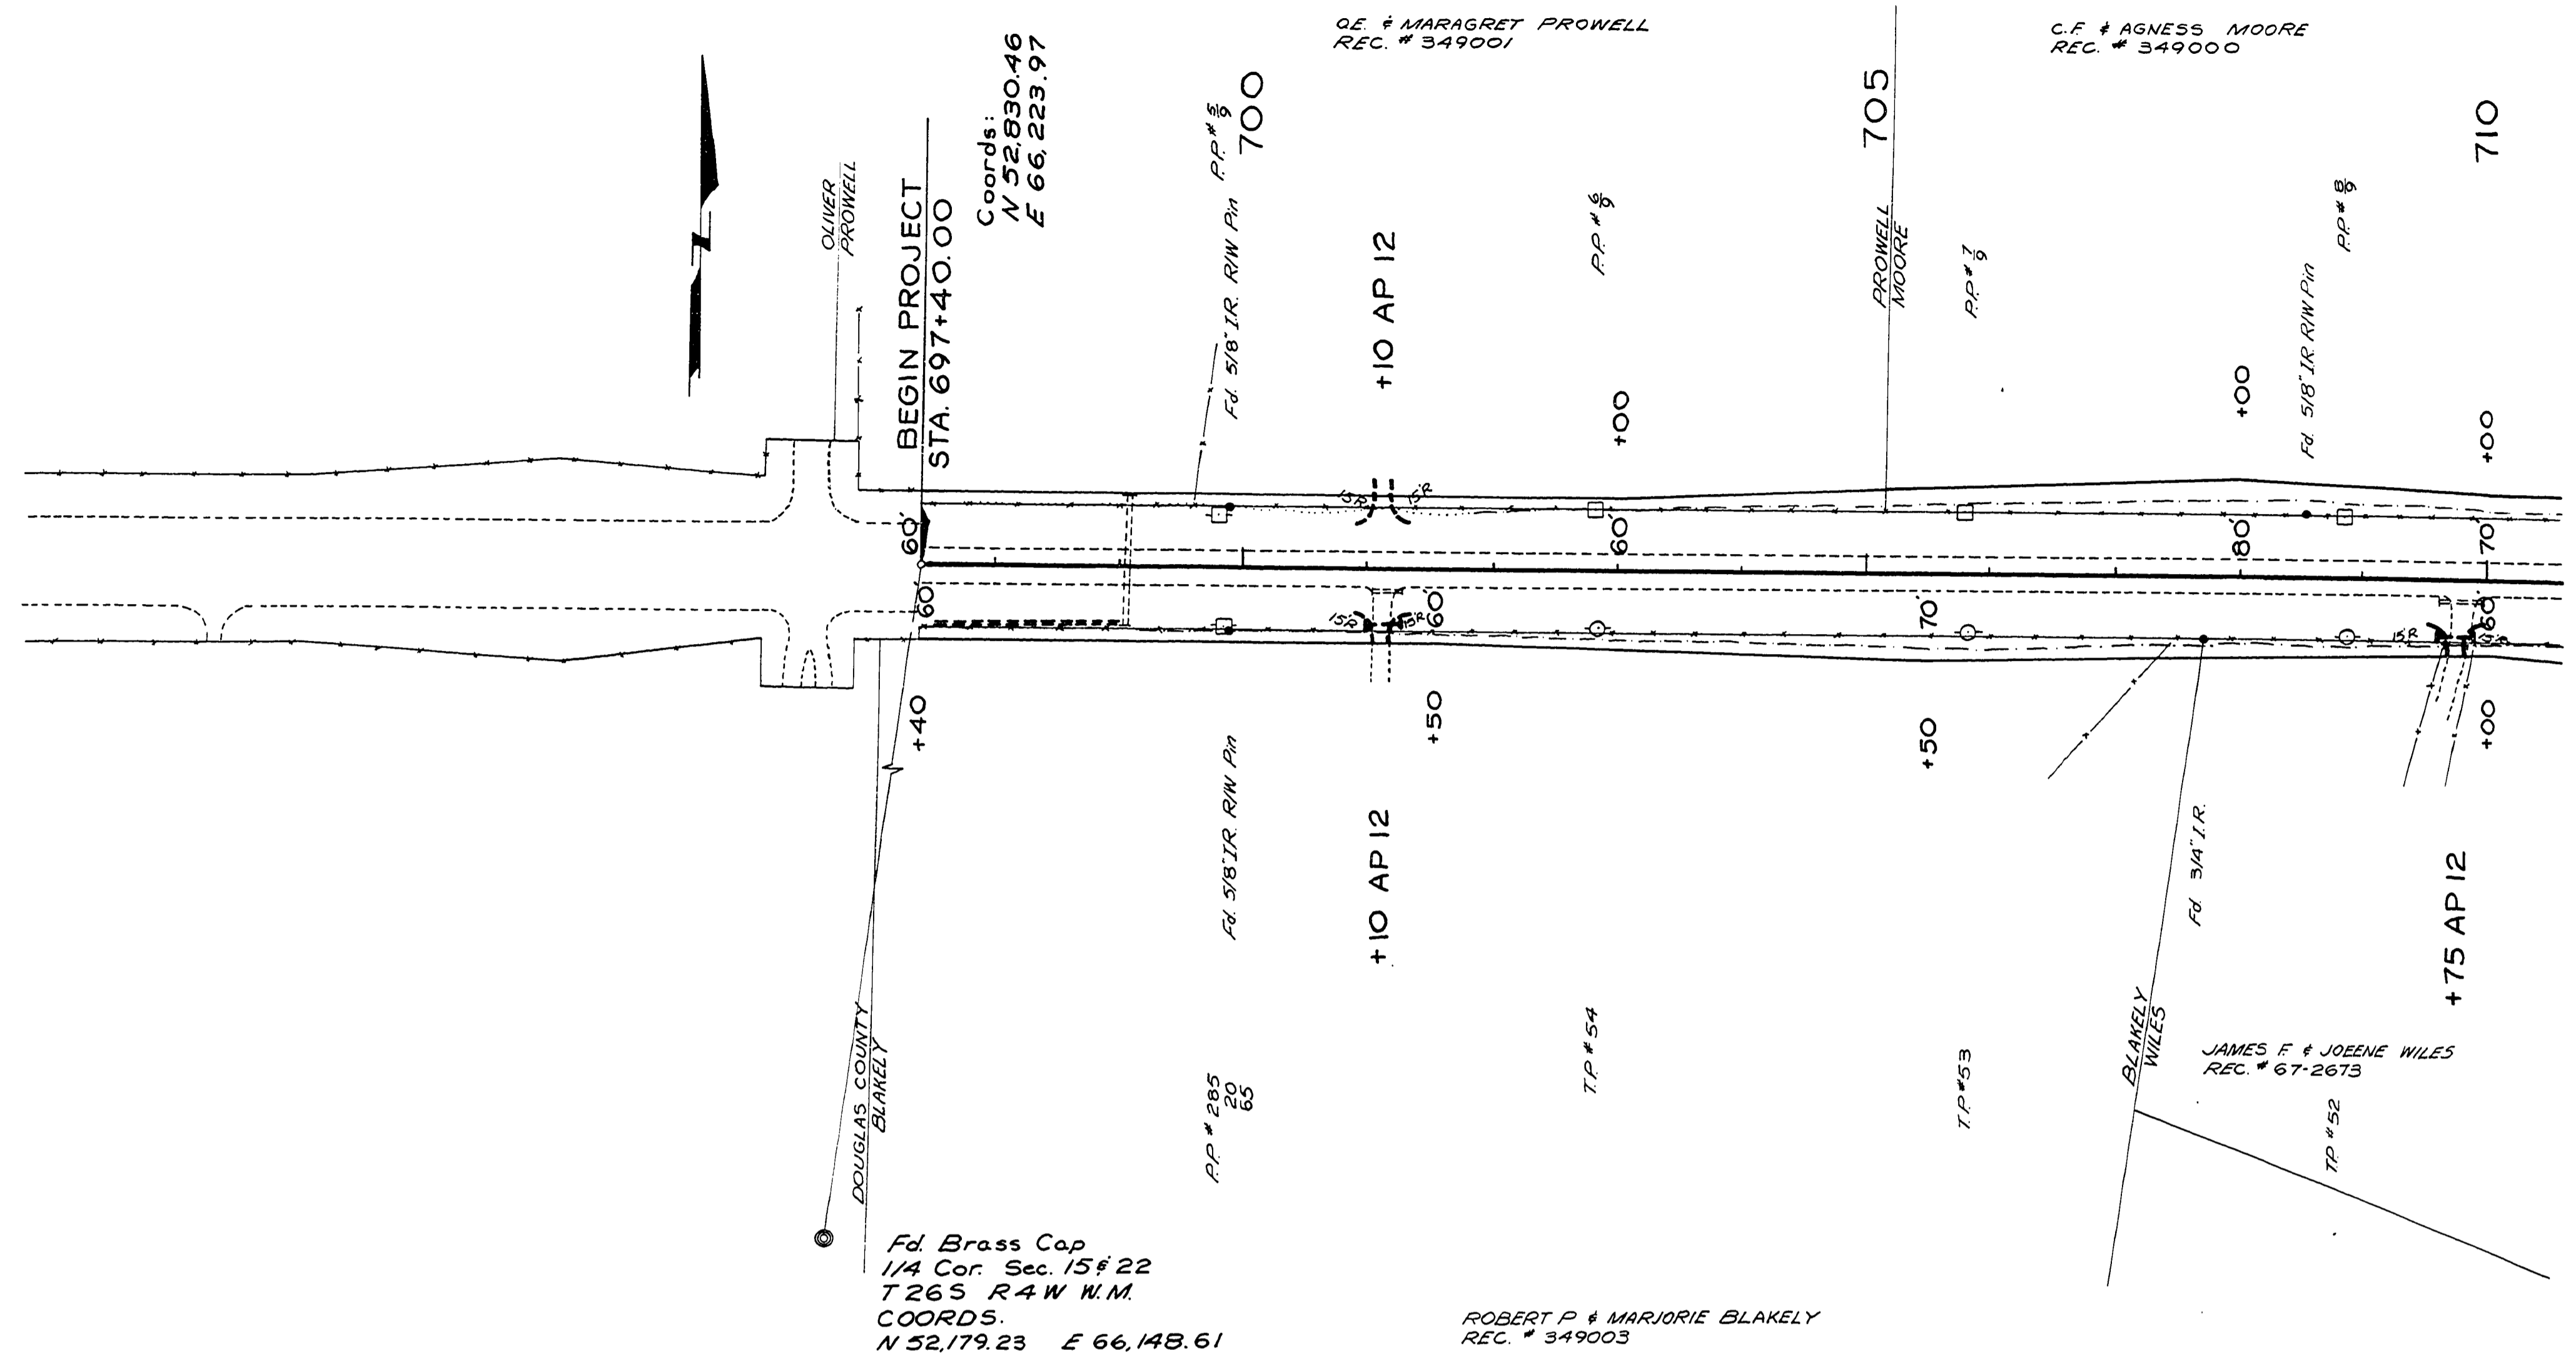

Coords:  
N 52,830.46  
E 66,223.97

O.E. & MARGARET PROWELL  
REC. # 349001

C.F. & AGNESS MOORE  
REC. # 349000

Fd. Brass Cap  
1/4 Cor. Sec. 15 & 22  
T26S R4W W.M.  
COORDS.  
N 52,179.23 E 66,148.61

ROBERT P. & MARJORIE BLAKELY  
REC. # 349003

JAMES F. & JOENE WILES  
REC. # 67-2673

NOT REVISED  
AS CONSTRUCTED

DOUGLAS COUNTY ROAD DEPT.  
NORTH UMPQUA HWY. RD. 4  
1973 SHT. 6  
GEORGE E. GRUBB, COUNTY ENGR.

13371361

700~

705~

M.P. 13.37-13.61

Rd # 4 1973 07 01 (2)