
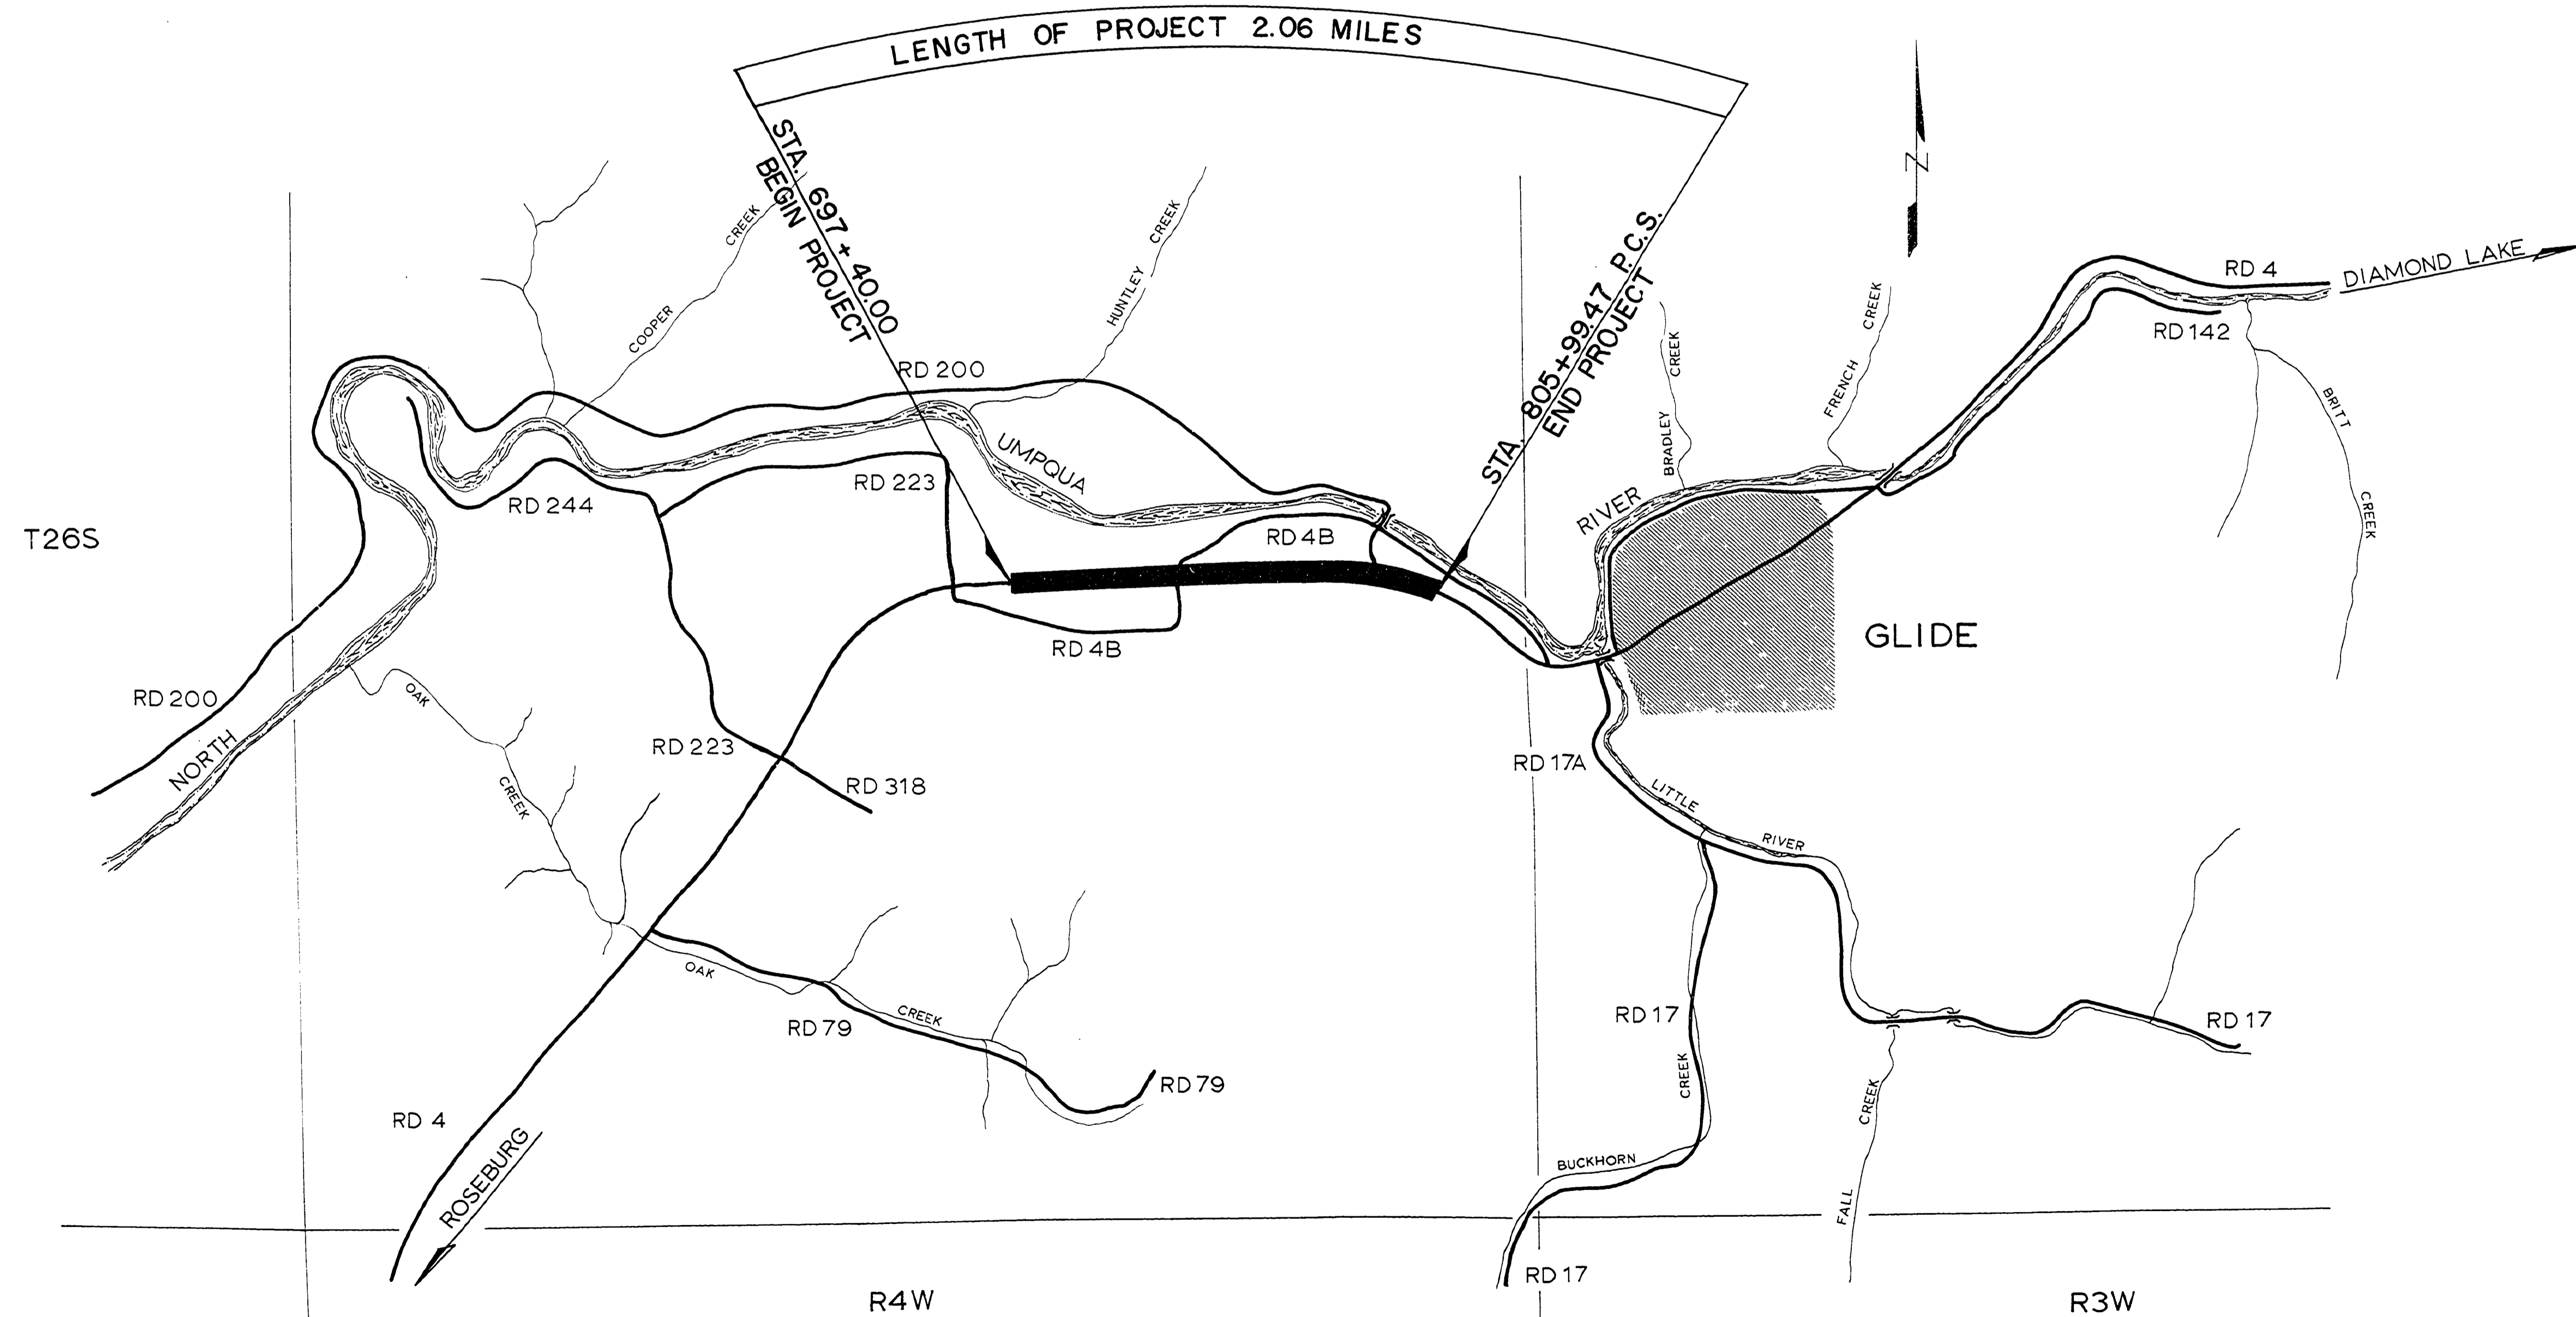


DOUGLAS COUNTY, OREGON  
 PLANS FOR PROPOSED PROJECT  
 SURFACING  
**NORTH UMPQUA HIGHWAY**  
**COUNTY ROAD NO. 4**  
 MILE POINT 13.18 TO MILE POINT 15.24

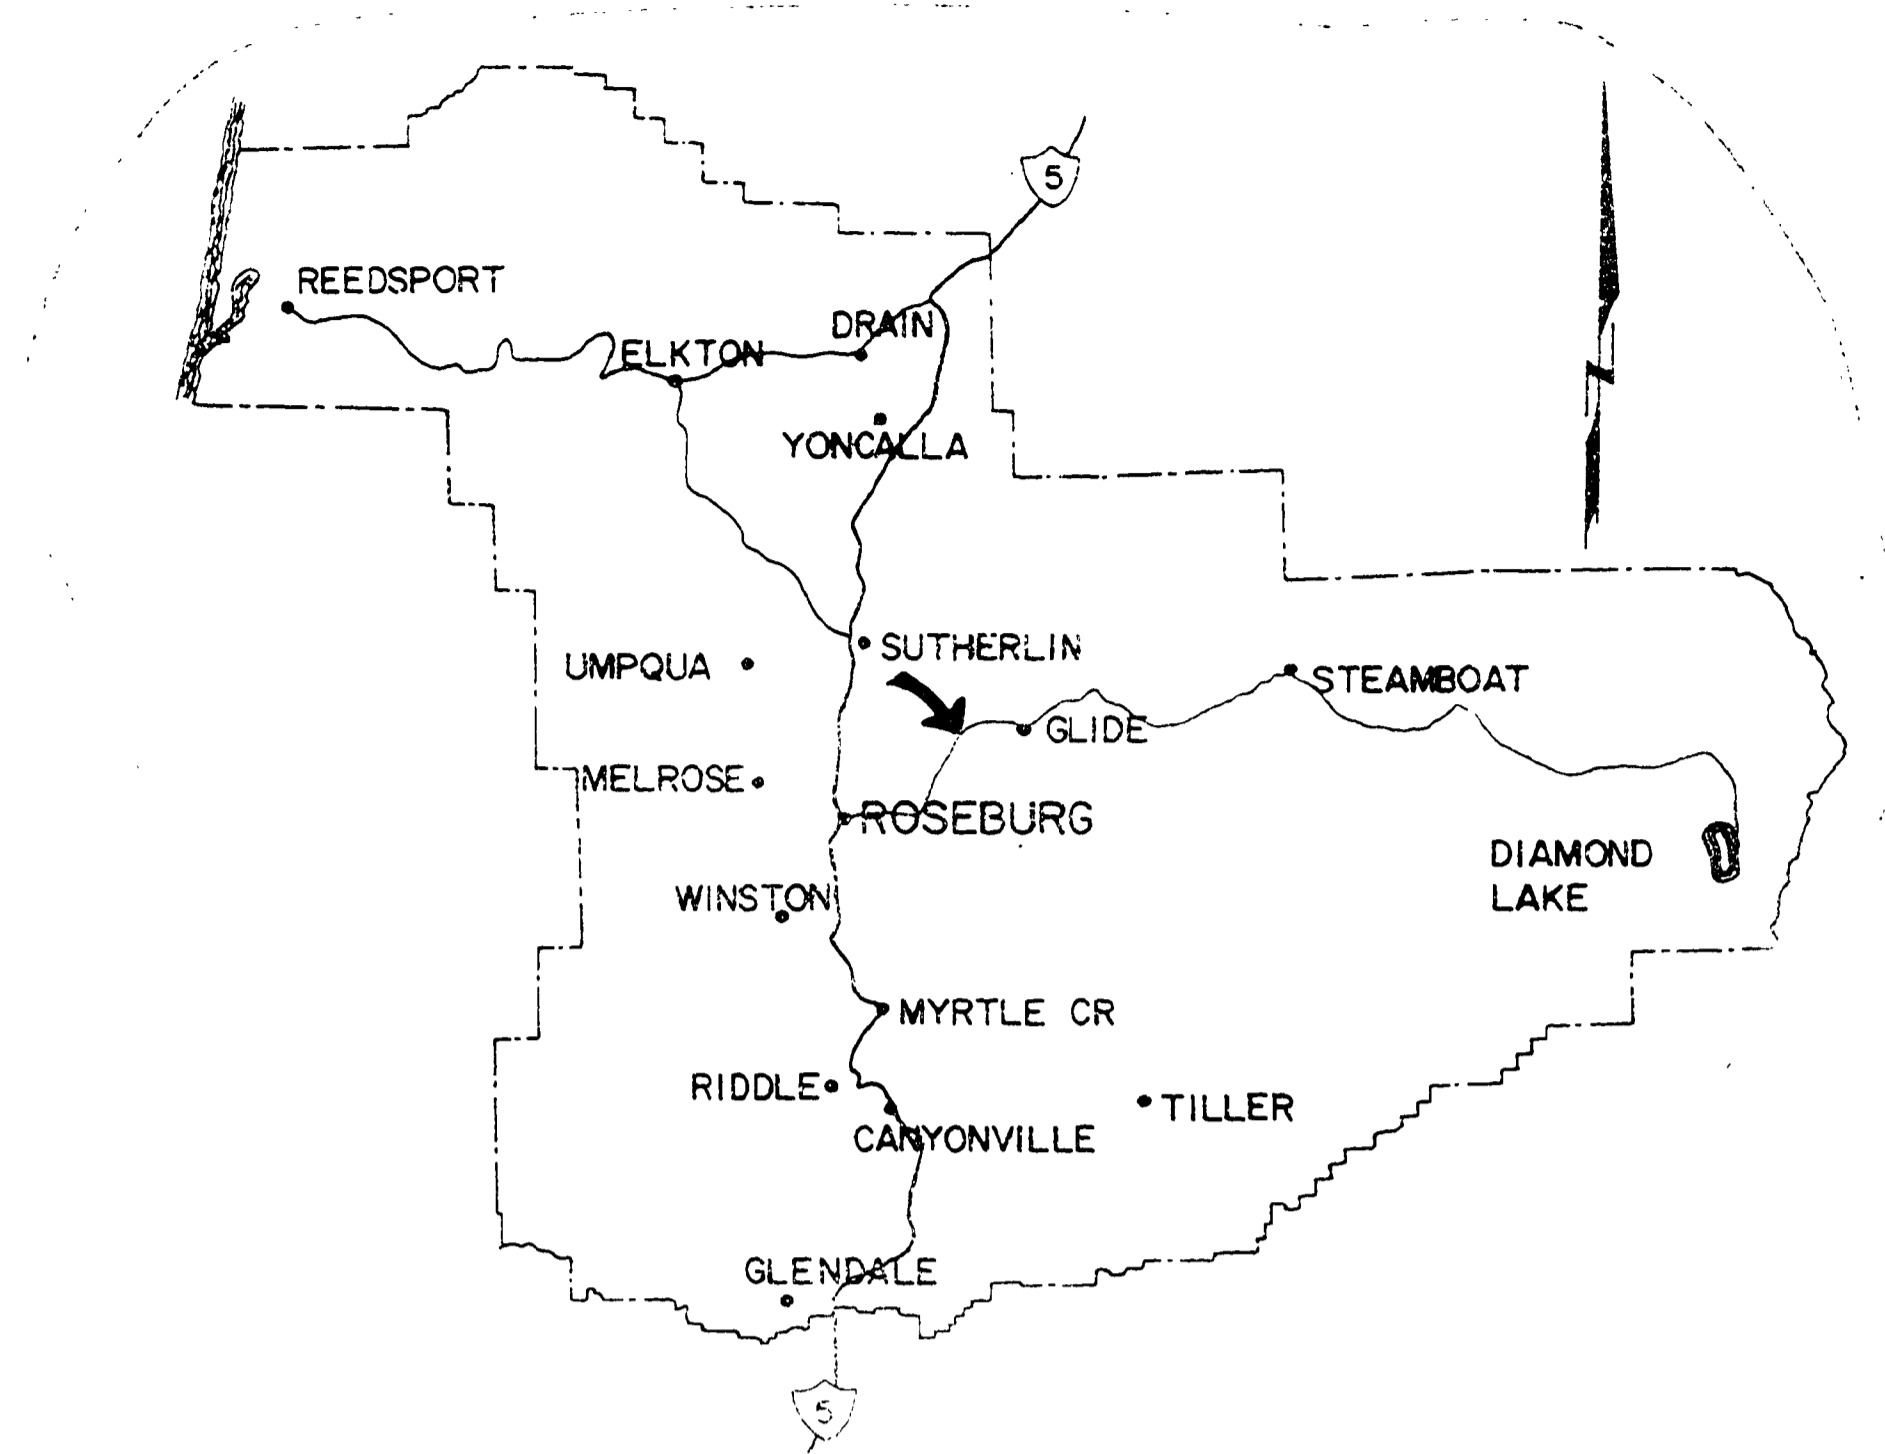

**INDEX OF DRAWINGS**

SHEET NUMBER	TITLE
1	TITLE SHEET
2	QUANTITY SUMMARY & ROAD TYPICAL
	TYPICAL SECTIONS
	INTERSECTION PLANS
	ROAD PLANS

STANDARD DRAWINGS

TOTAL OF SHEETS

NOT REVISED  
 AS CONSTRUCTED



DOUGLAS COUNTY ROAD DEPT.  
**NORTH UMPQUA HIGHWAY RD.#4**  
 1973 SHT 1  
 GEORGE E. GRUBB COUNTY ENG.

1337158C