



DOUGLAS COUNTY, OREGON NORTH UMPQUA HIGHWAY ROAD # 4

MILE POINT 15.24 TO 17.81

GRADING, PAVING, STORM DRAINAGE & WATER SYSTEM

MAY, 1977

WATER SYSTEM DESIGNED BY C&G ENGINEERING
FOR GLIDE WATER ASSOCIATION

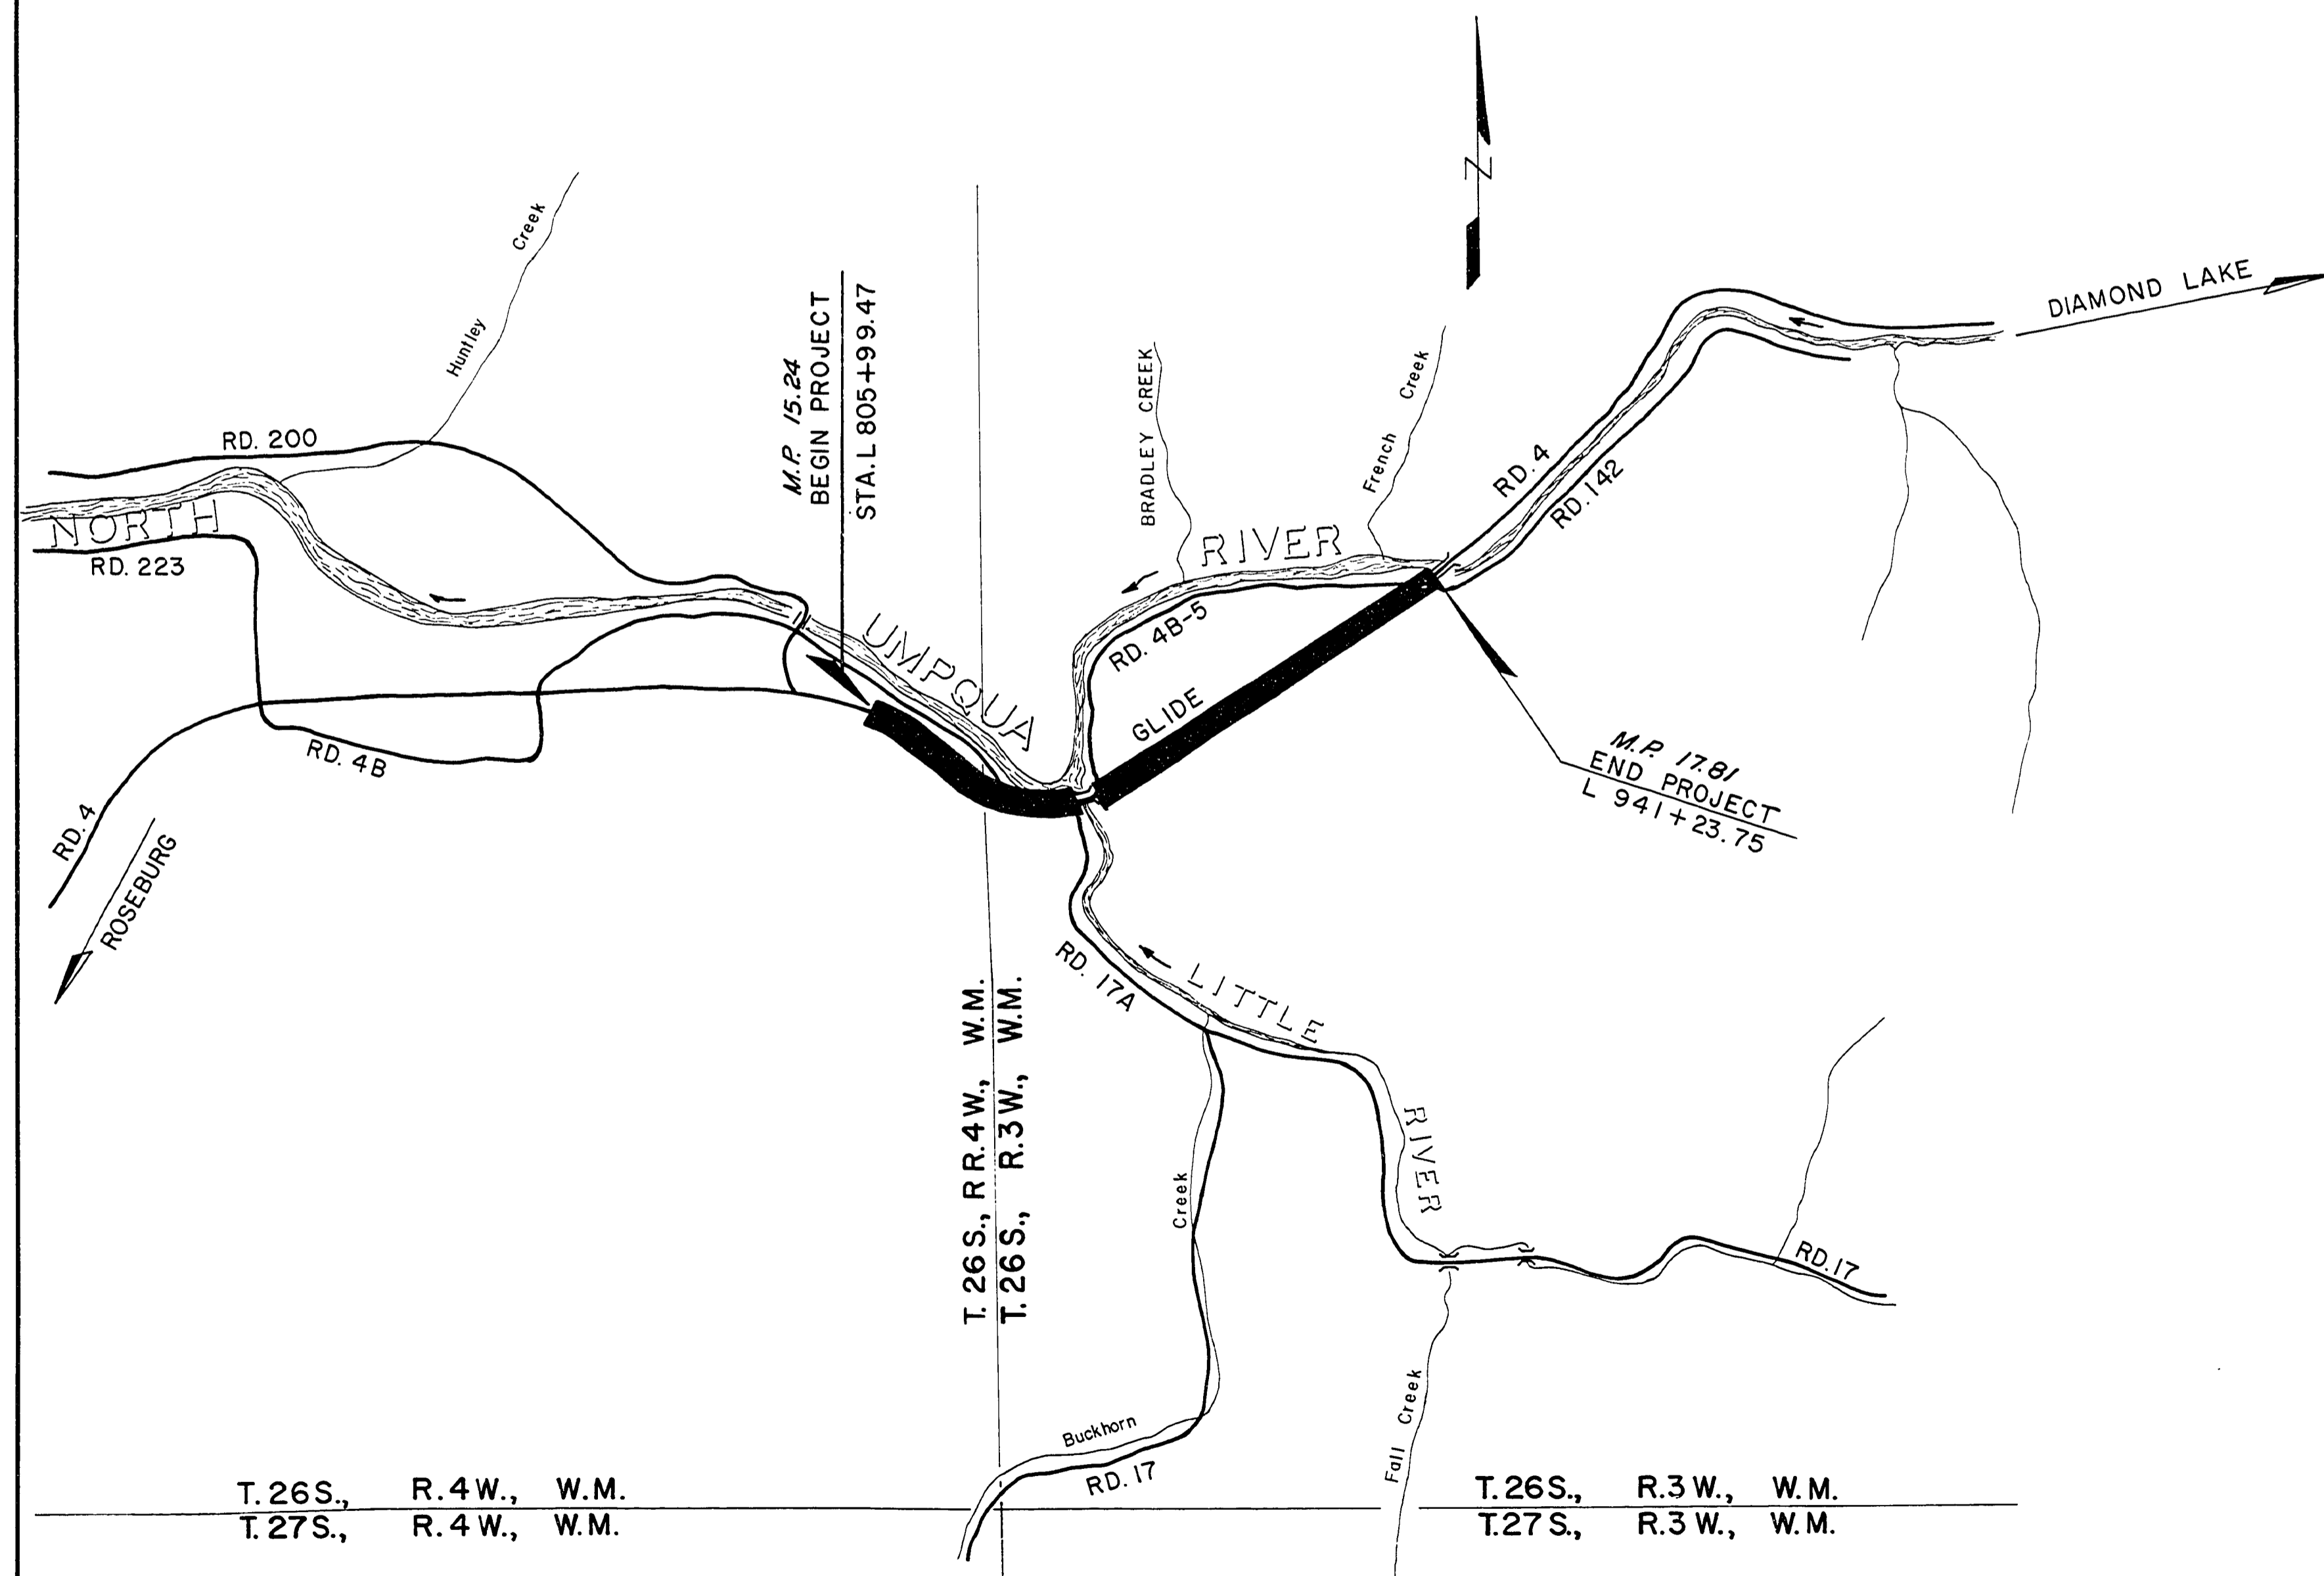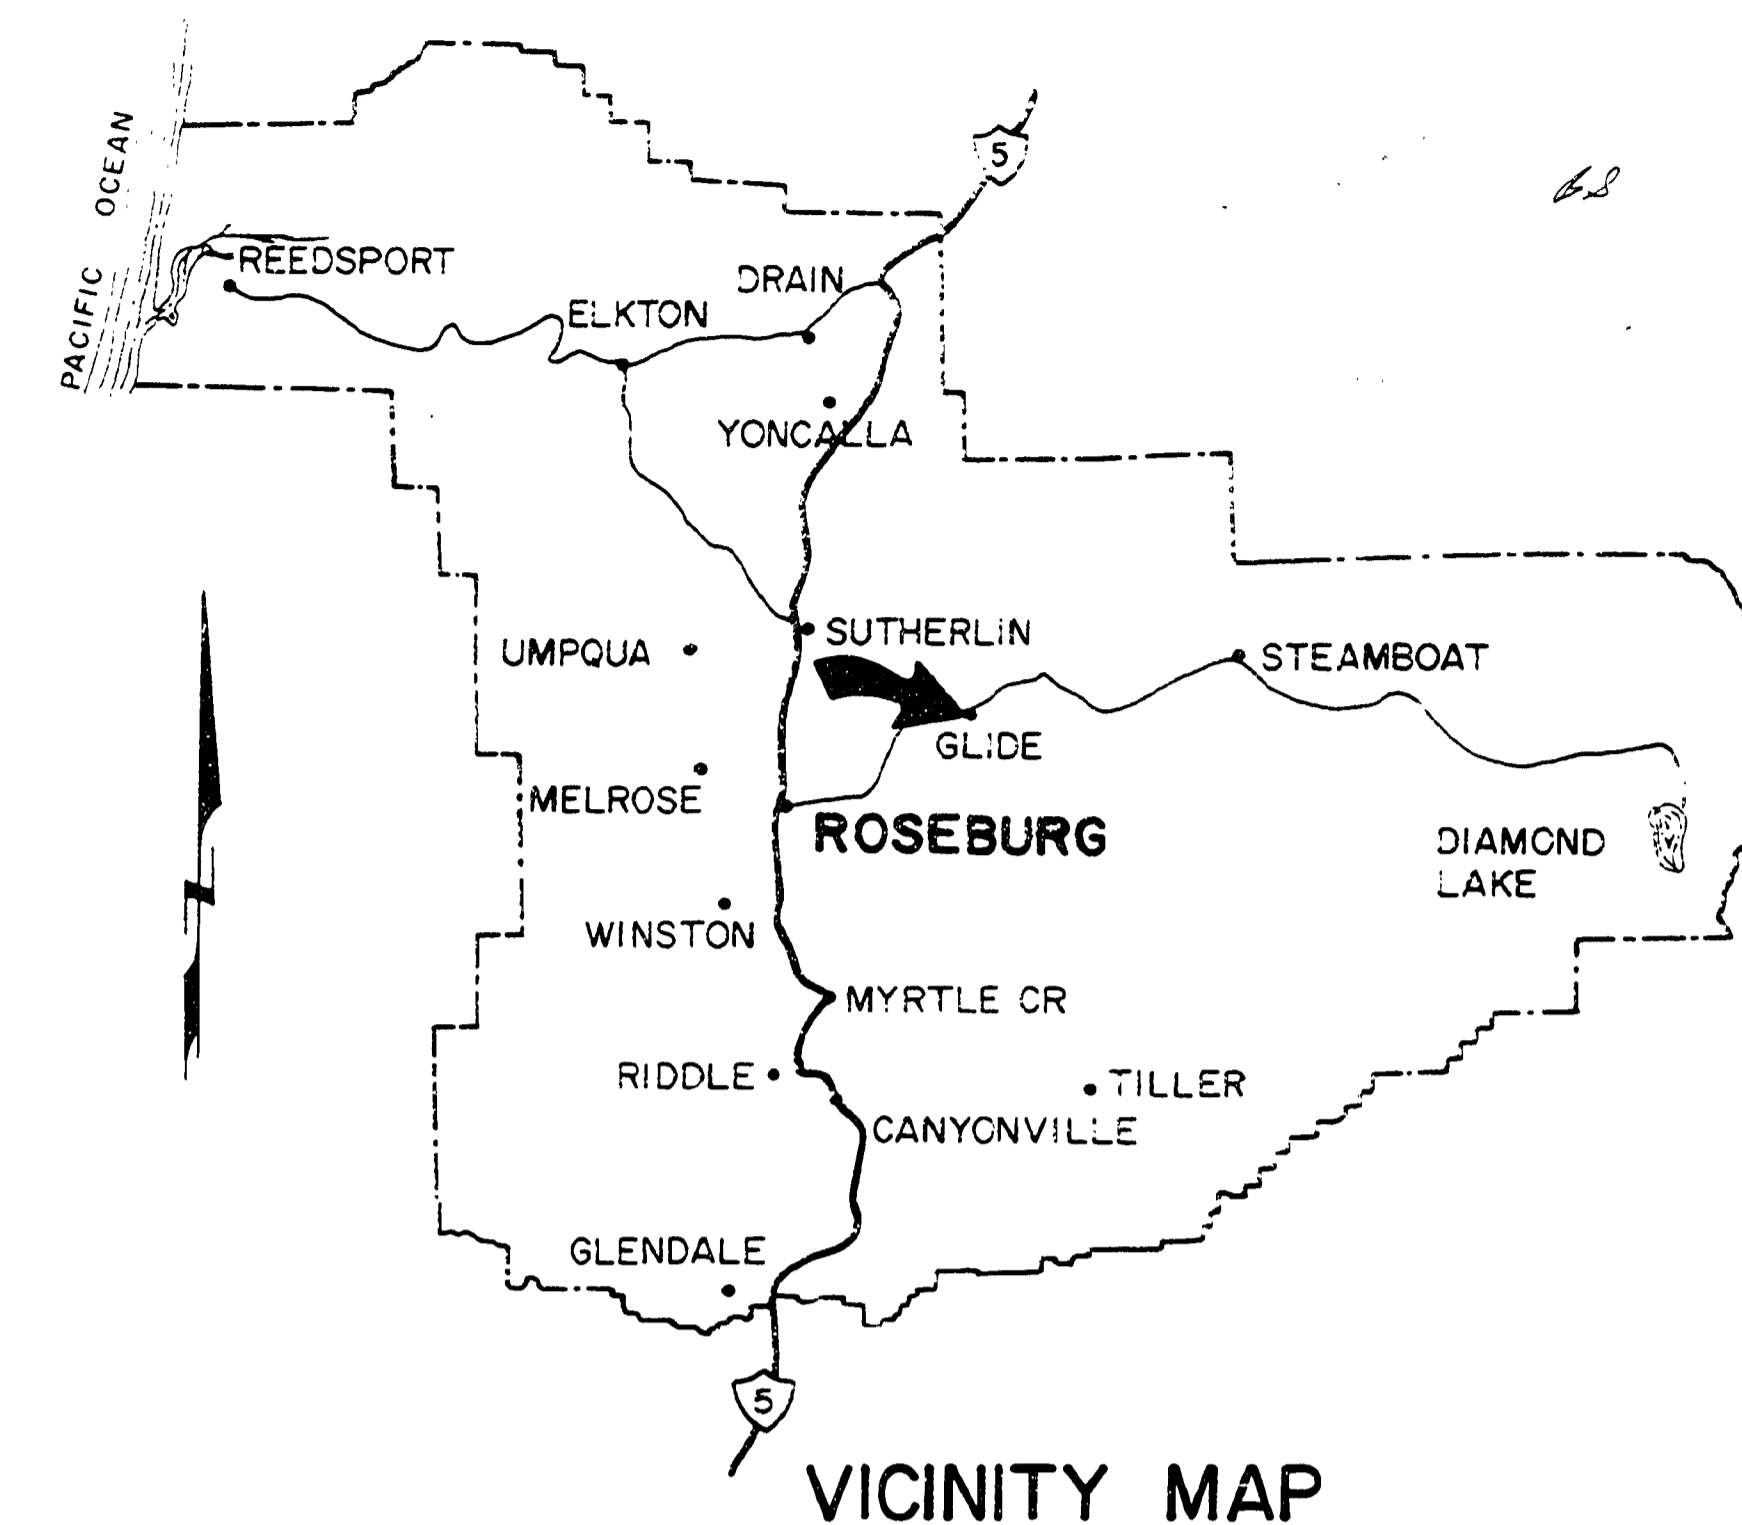

LOCATION MAP
NO SCALE

INDEX TO DRAWINGS

SHEET NO.	DESCRIPTION
1	COVER SHEET
2	QUANTITY SUMMARY
3	TYPICAL DETAILS
4	MINOR STREET & DRIVEWAY PROFILES
5-14	ROAD PLANS
15	STANDARD DRAWING NO. 310
16	STANDARD DRAWING NO. 4
17	STANDARD DRAWING NO. 5
18	STANDARD DRAWING NO. 9
19	WATER SYSTEM DETAILS
20-25	WATER SYSTEM PLANS



Legend:

- = SET 5/8" x 30" I.R. W/ ALUMINUM CAP MARKED DOUGLAS CO. RD. DEPT. R-W
- = FOUND MON. (AS NOTED)
- ⊙ = FOUND BRASS CAP (MARKED AS NOTED)

AS CONSTRUCTED

Drn. By: R.F. & JAM
Ckd By: KJ/WP

ROSEBURG, OREGON	
SURVEYED	J. LONG
DESIGNED	W. ROGERS
DRAFTED	B.B. BALL
REVIEWED	W. POLAND
BOOK	1 thru 21
DOUGLAS COUNTY PUBLIC WORKS DEPARTMENT NORTH UMPQUA HWY. ROAD 4 1977 SHT. 1 GEORGE E. GRUBB, DIRECTOR	

1544180C

Rd # 4 1977 2. 1 of 14 25