
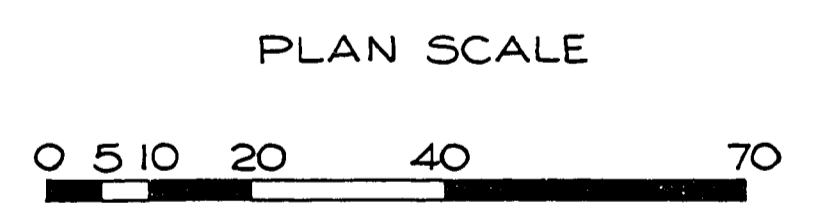


NOTE: CROSS HATCHING DENOTES PAINTED MEDIAN AREA.

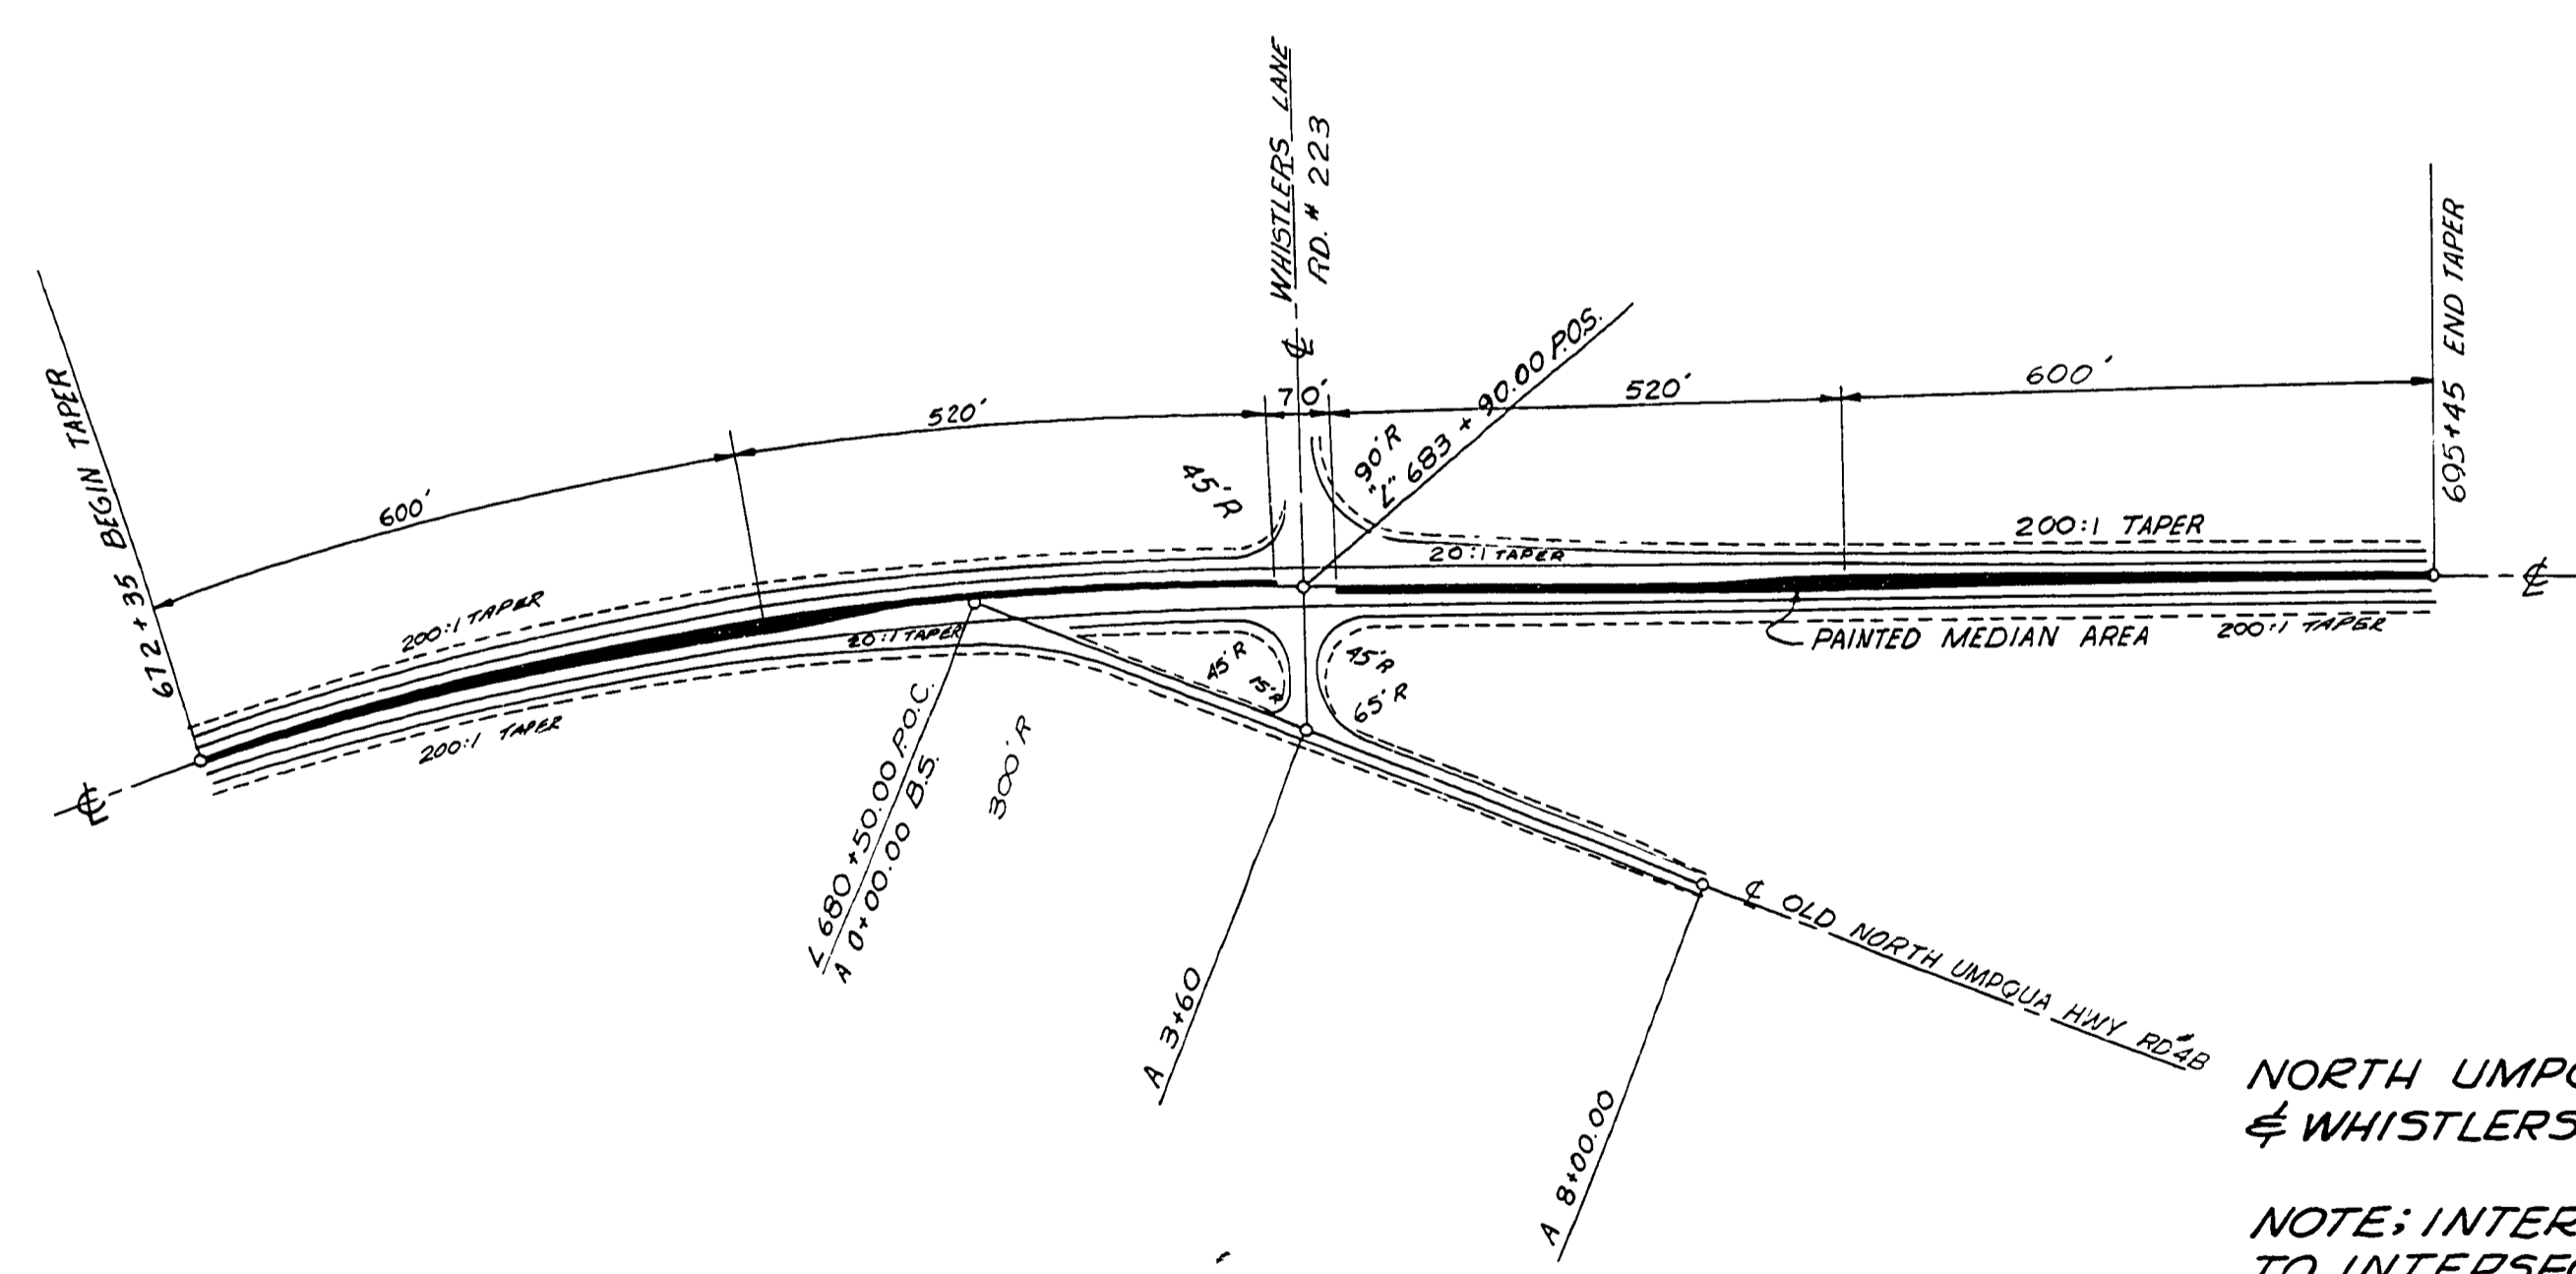

**INTERSECTION PLAN**

STA 683+90  
NORTH UMPQUA HWY RD #4, OLD NORTH UMPQUA HWY RD #4B  
& WHISTLERS LANE RD #223

NOTE: INTERSECTION PLAN FROM STA 683+90 AHEAD, IDENTICAL TO INTERSECTION PLAN, SHT NO. 5

NOT REVISED  
AS CONSTRUCTED

DOUGLAS COUNTY ROAD DEPT  
NORTH UMPQUA HWY RD #4  
1972 SHT 6  
GEORGE E. GRUBB COUNTY ENGR.

INTERSECT