


PROFILE OF
ROSEBURG - GLIDE RD
OAK CREEK SECT
STA. 20+17.2
STA. 79+47.2

OFFICE OF
F. C. FREAR
COUNTY SURVEYOR
ROADMASTER

SCALE 1" = 100' HORIZ.
1" = 10' VERT.

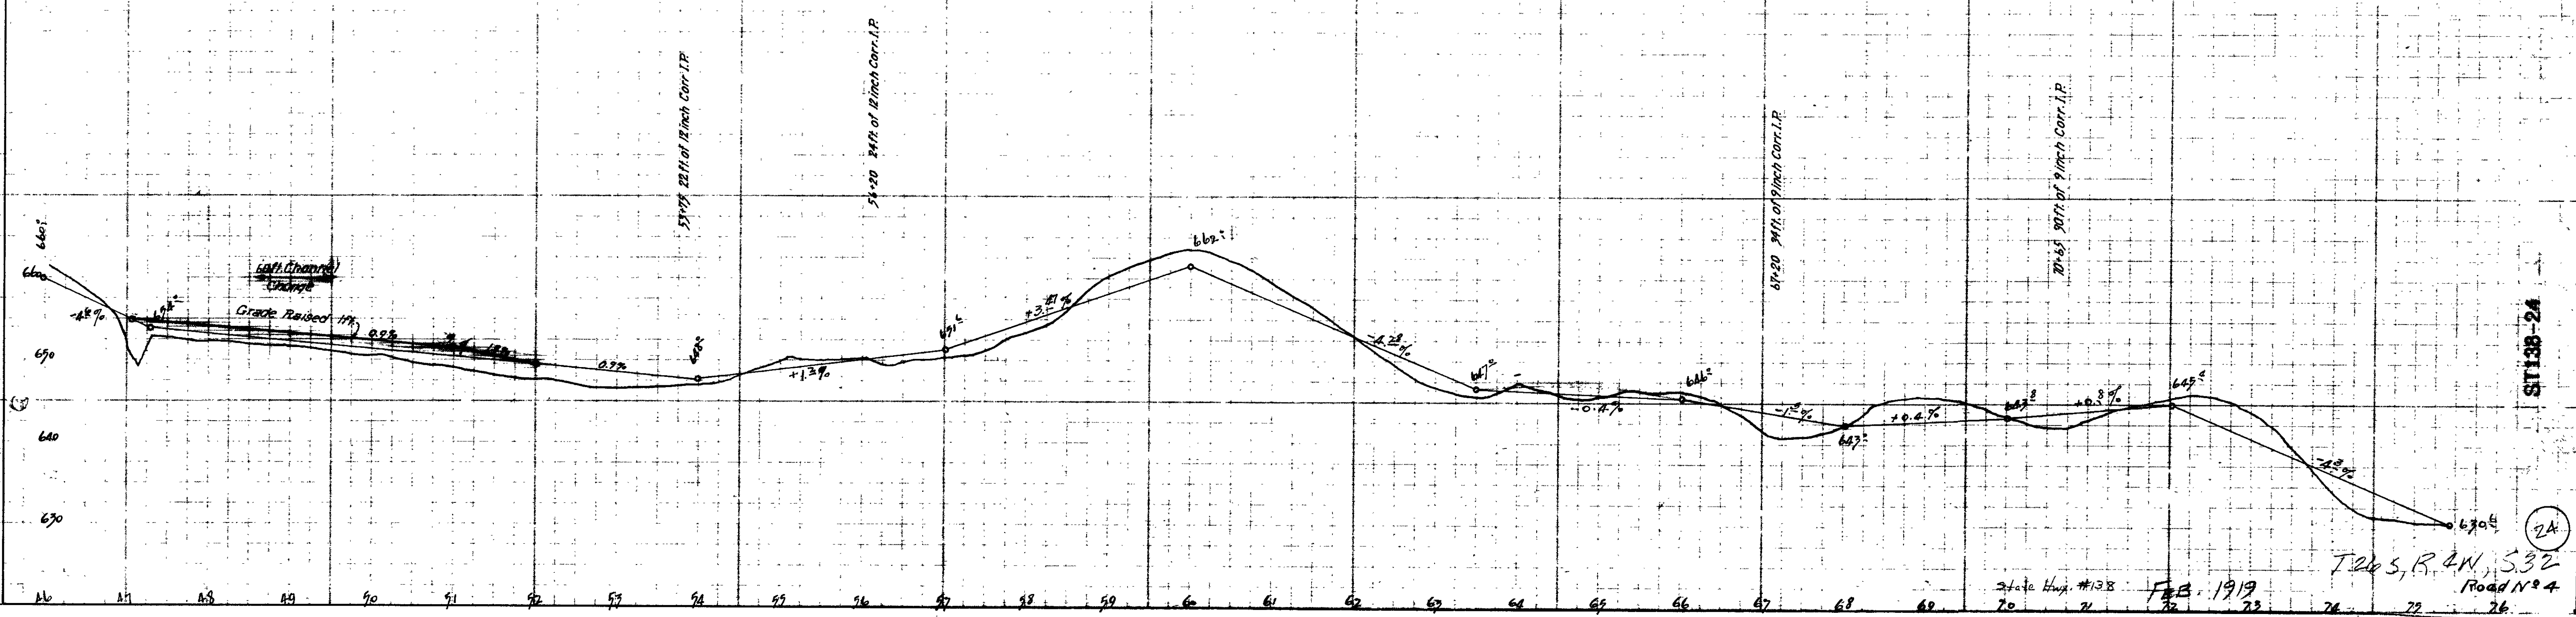

ST 138-24

Feb 5, R. W., S. 32
Road No. 4
24

24 to Hwy. #138
FEB. 1919
70 71 72 73 74 75 76