




TYPICAL SECTION
STA. 495+80 TO STA. 750+00

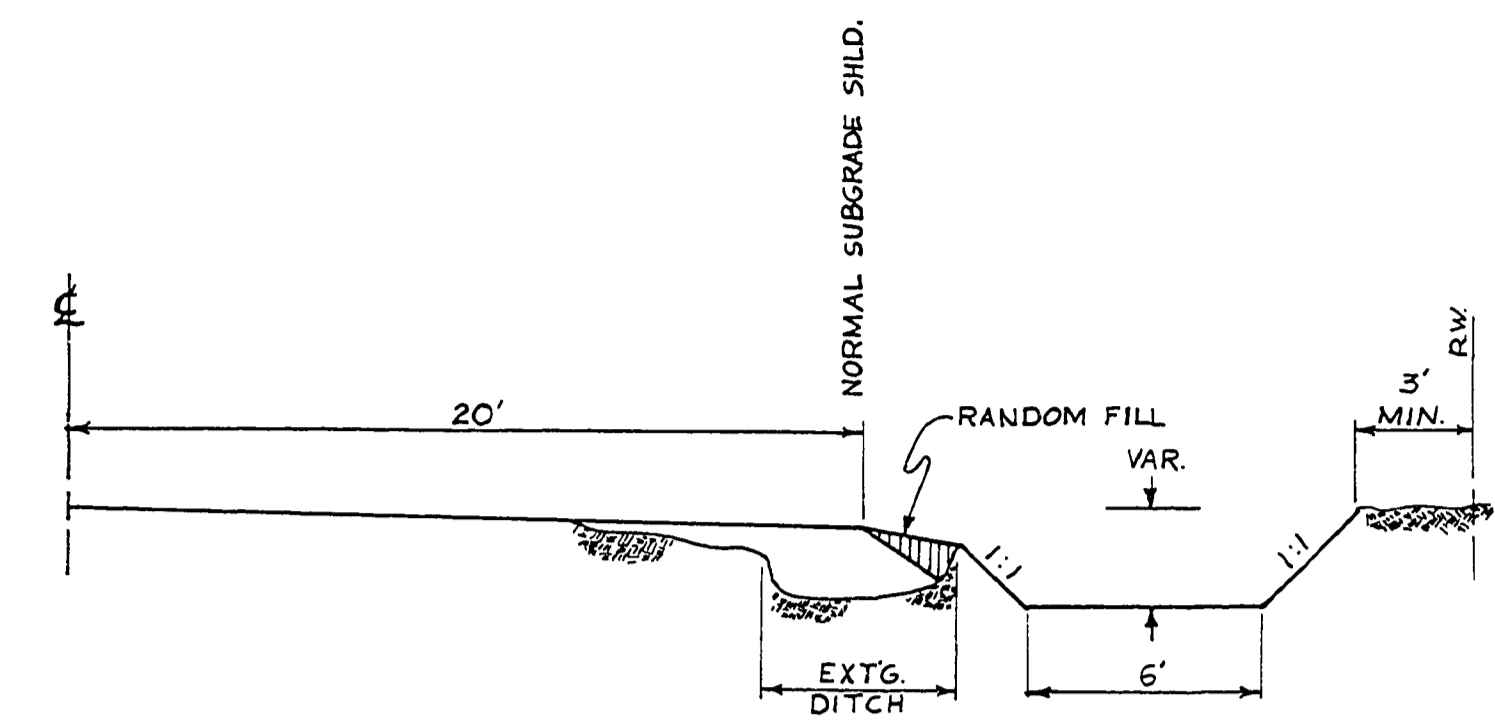

TYPICAL FLAT BOTTOM DITCH
STA. 496+50 to STA. 501+00

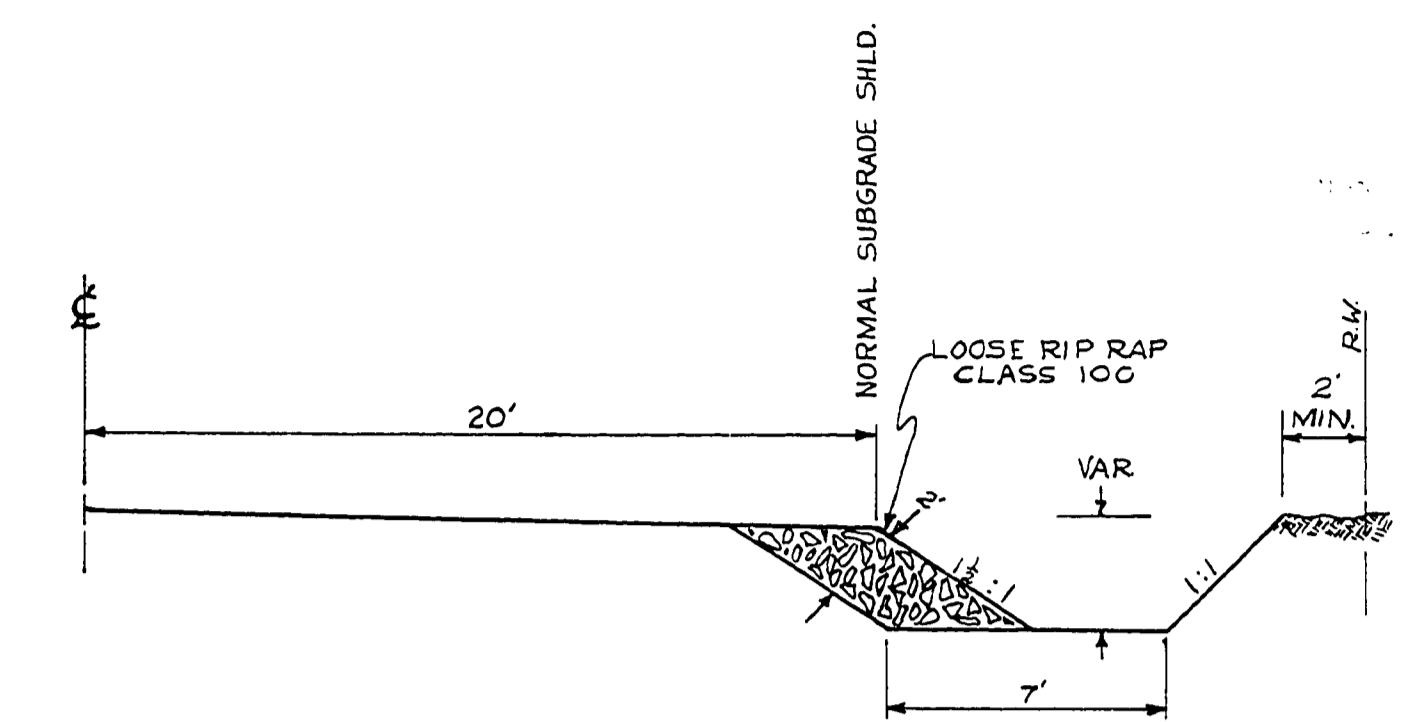


TYPICAL FLAT BOTTOM DITCH
STA. 501+00 to STA. 501+85

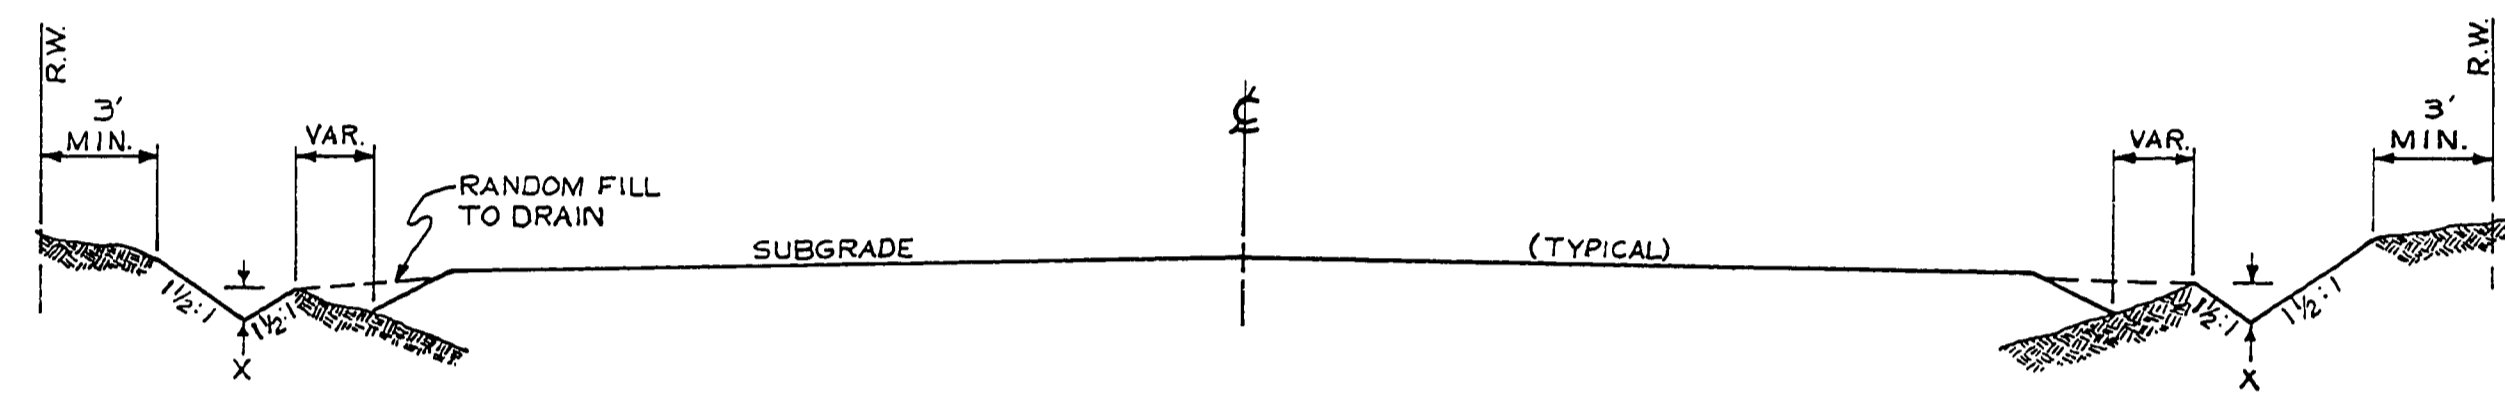


VARIABLE DITCH IN EMB. AREA
X = VARIABLE
1° to 3°

STA. 563+60 to STA. 564+25
570+25
579+00
625+50
636+25
649+25


STA. 510+90 to STA. 511+50
578+75
605+25
661+25
671+00
679+50
683+75
714+00
724+25

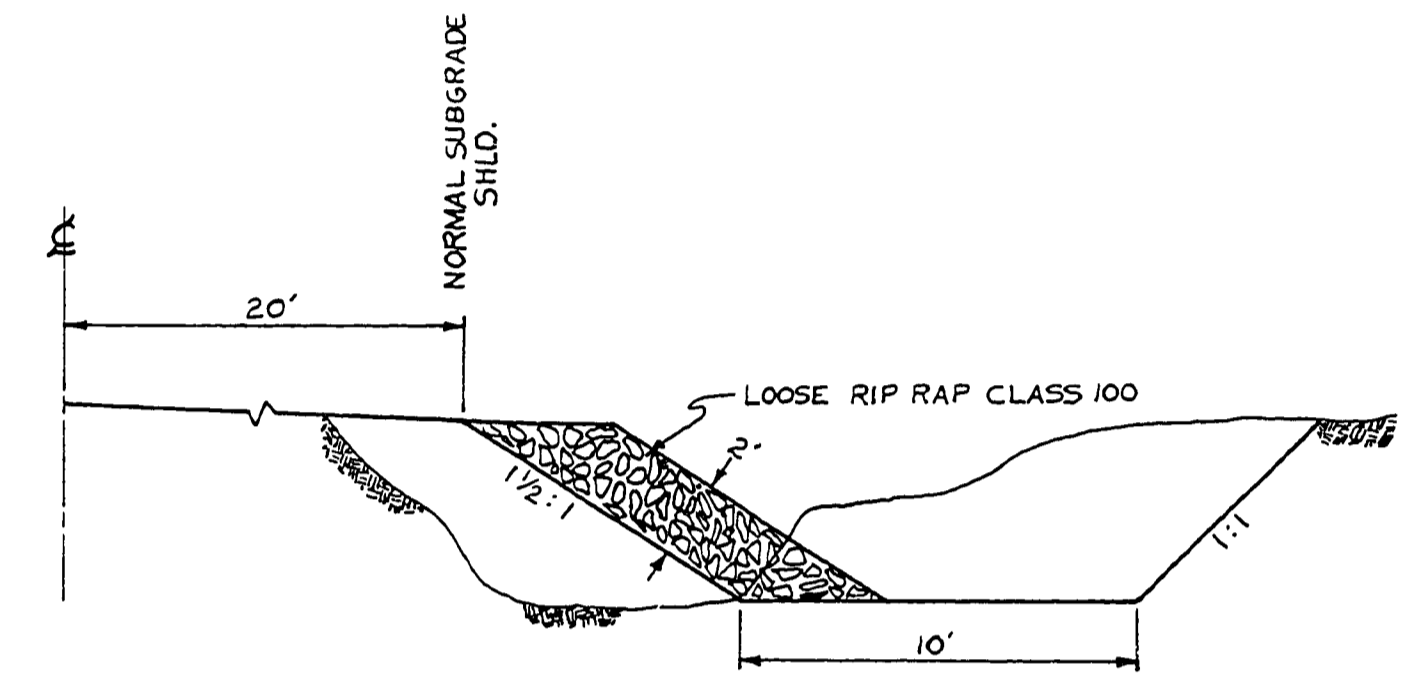

TYPICAL CHANNEL CHANGE
STA. 526+70 to STA. 527+50

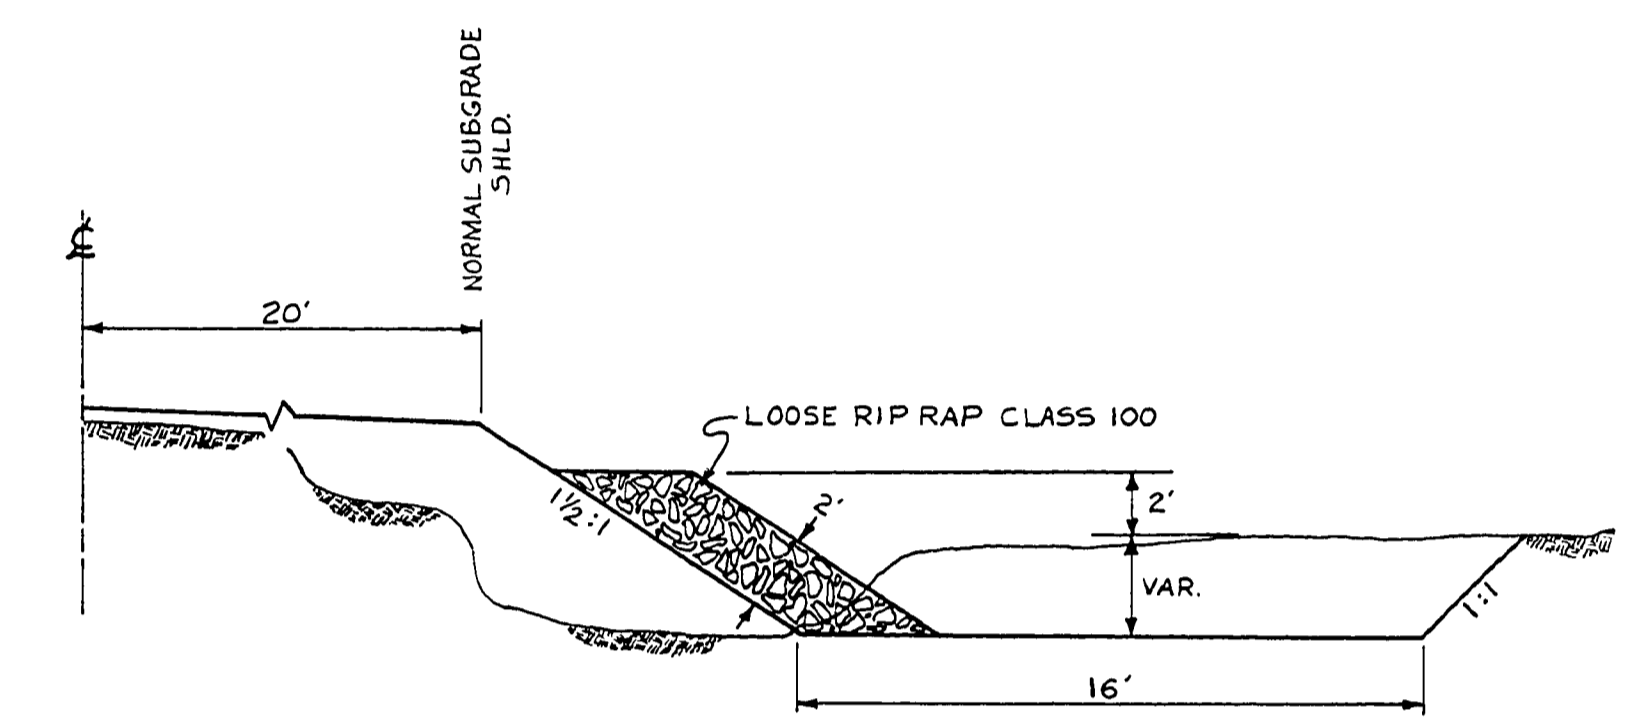


TYPICAL CHANNEL CHANGE
STA. 628+00 to STA. 631+50

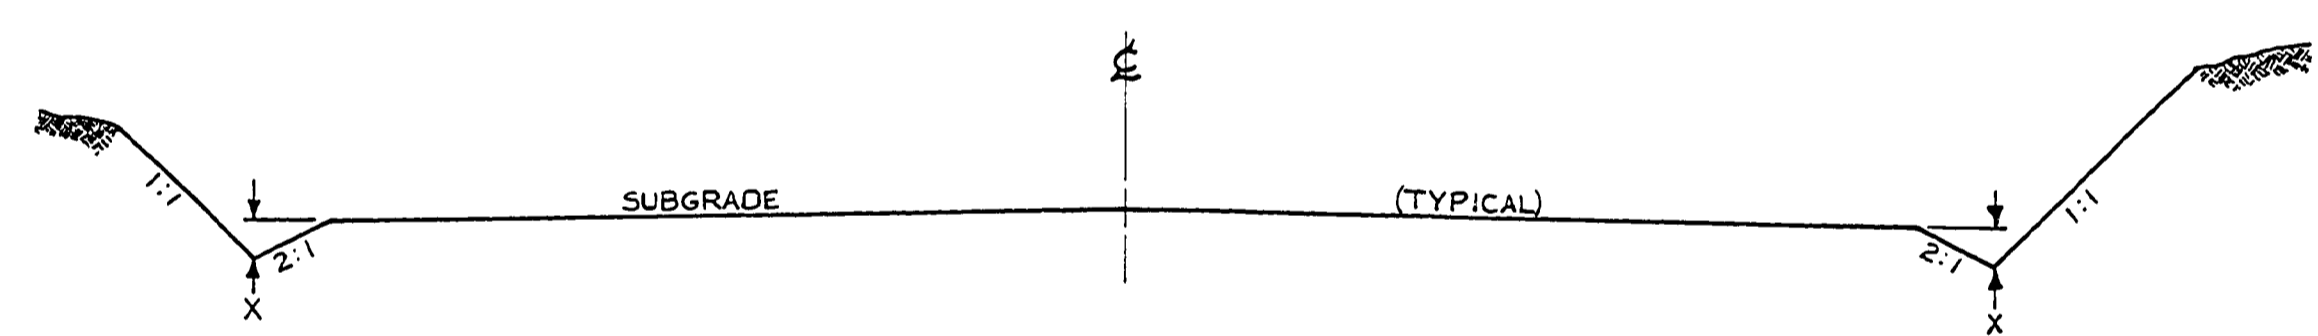

VARIABLE DITCH IN CUT AREA
X = VARIABLE
1° to 3°

STA. 567+20 to STA. 567+50
615+30
647+50
660+00


STA. 522+25 to STA. 524+00
704+00
717+00
731+00

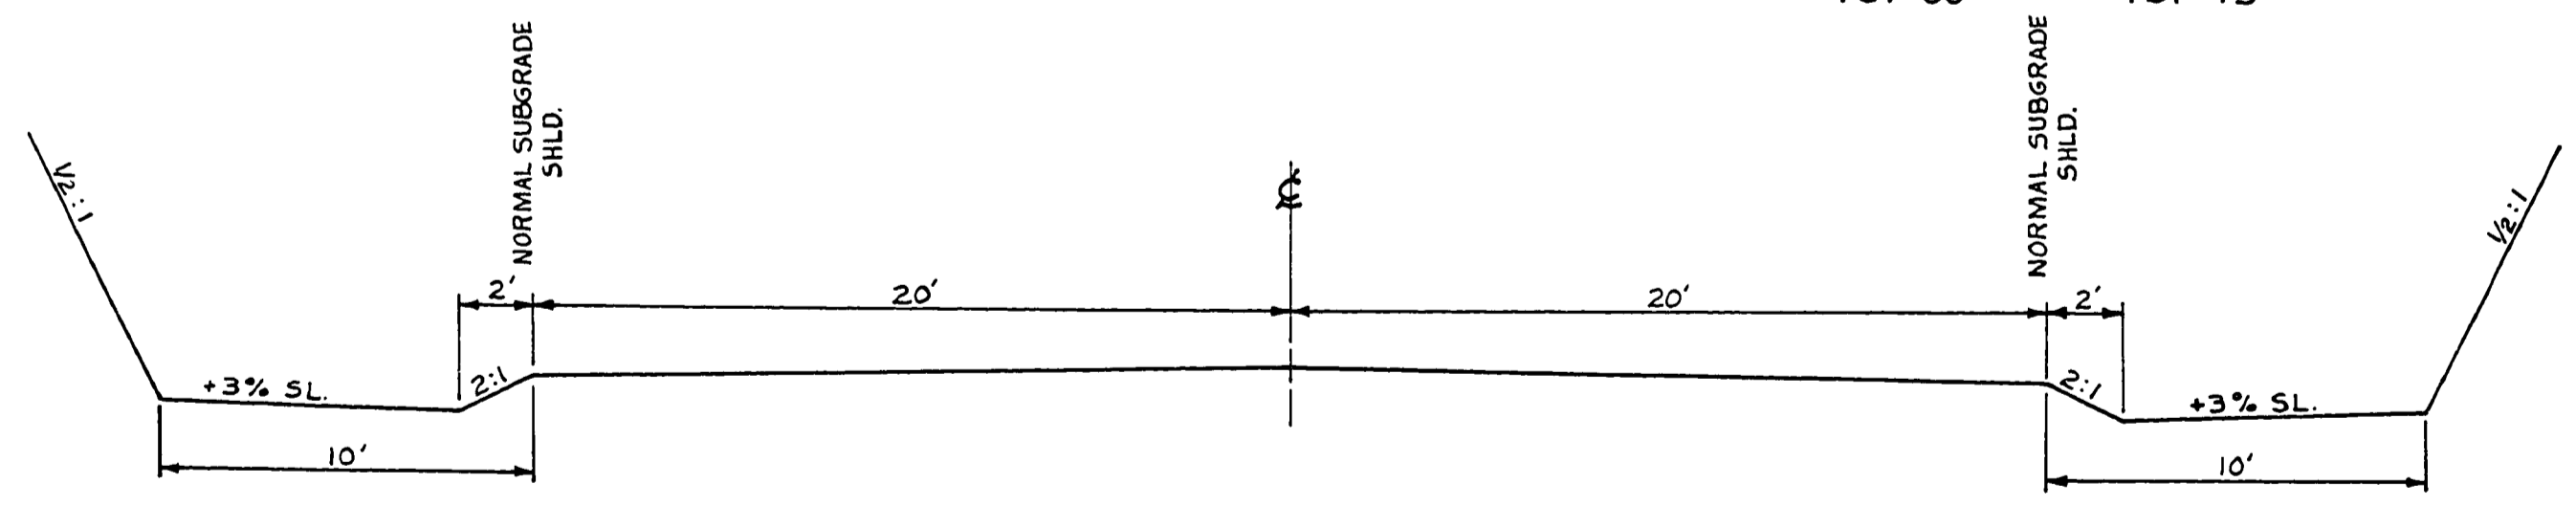

TYPICAL FALLOUT SECTION

STA. 627+50 to STA. 636+00
637+50
650+50
656+50

STA. 651+75 to STA. 653+00
639+75
653+00
657+50

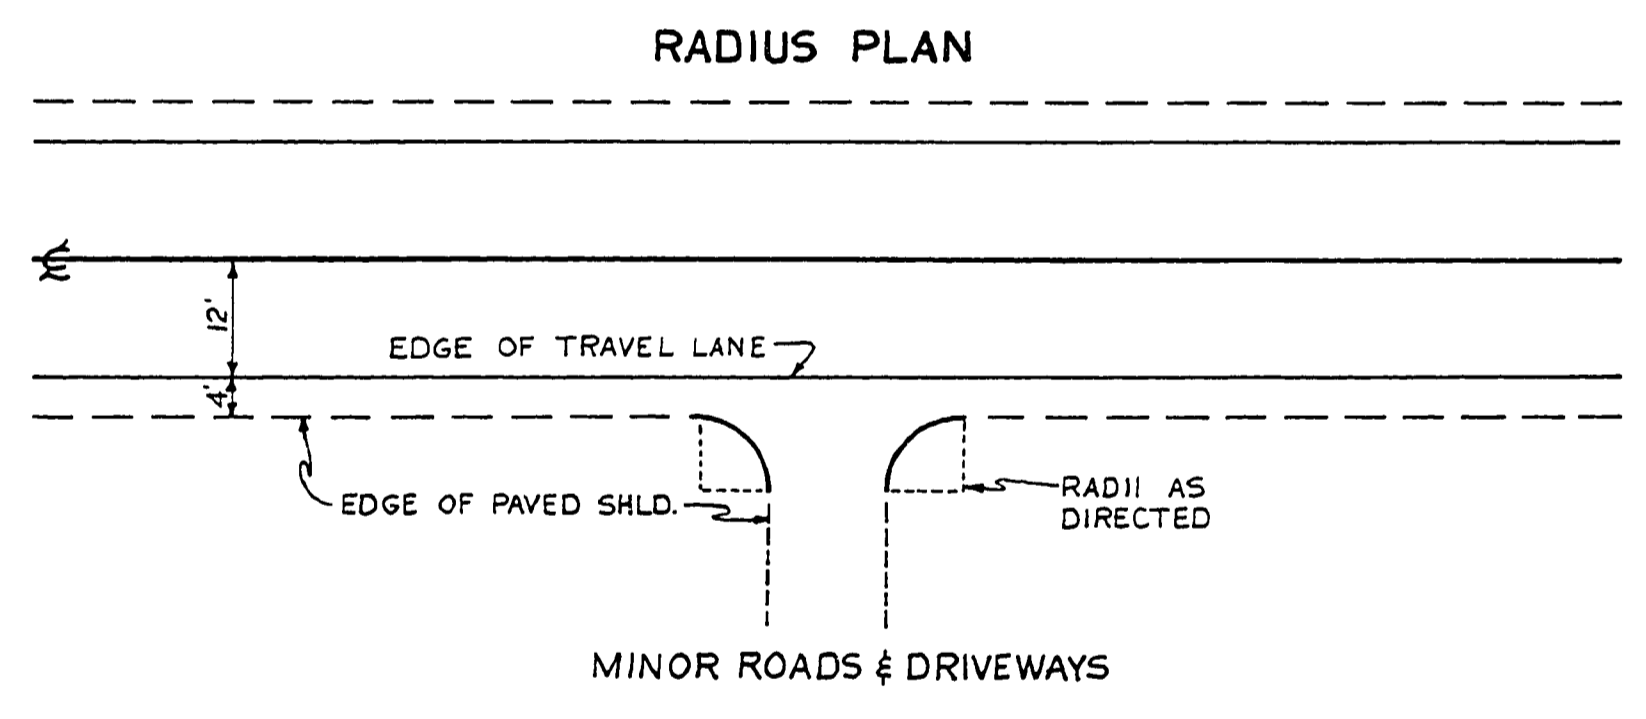

RADIUS PLAN

NOT AS BUILT - AS CONSTRUCTED
11-6-73 T.V.
DOUGLAS COUNTY ROAD DEPT.
ROSEBURG RESTON LOOP 5
1973 SHT. 3
GEORGE E. GRUBB, COUNTY ENG.

1017TYPL

Rd #5 1973 SHT. 3 of 13

3