

6V-199

INDEX OF SHEETS	
SHEET NO.	DESCRIPTION
1	Title Sheet
2	Summary & Typical Sections
3-4	Plan & Profile

Drg. Nos.  
 2050 Curbs & Driveways  
 2050A Manholes  
 2077 Method of Feathering  
 2105 Concrete Inlets  
 S-95 Retaining Wall  
 9795 } R.C. Box Culvert  
 12950 }  
 1R-2-2086 Elec. Conduit

# STATE OF OREGON STATE HIGHWAY DEPARTMENT

PLANS FOR PROPOSED PROJECT

GRADING & PAVING

## EAST UNIT, GARDEN VALLEY RD. SECTION

GARDEN VALLEY ROAD  
DOUGLAS COUNTY


SEPT. 30, 1958

READV., OCT., 1958

EAST UNIT, GARDEN VALLEY RD. SEC. GARDEN VALLEY ROAD DOUGLAS COUNTY				SHEET No. 1
FED. ROAD Div. No.	STATE	PROJECT NUMBER	FISCAL YEAR	TOTAL SHEETS
8	OREGON	DUS-402(1)		See Index


4-60

5370

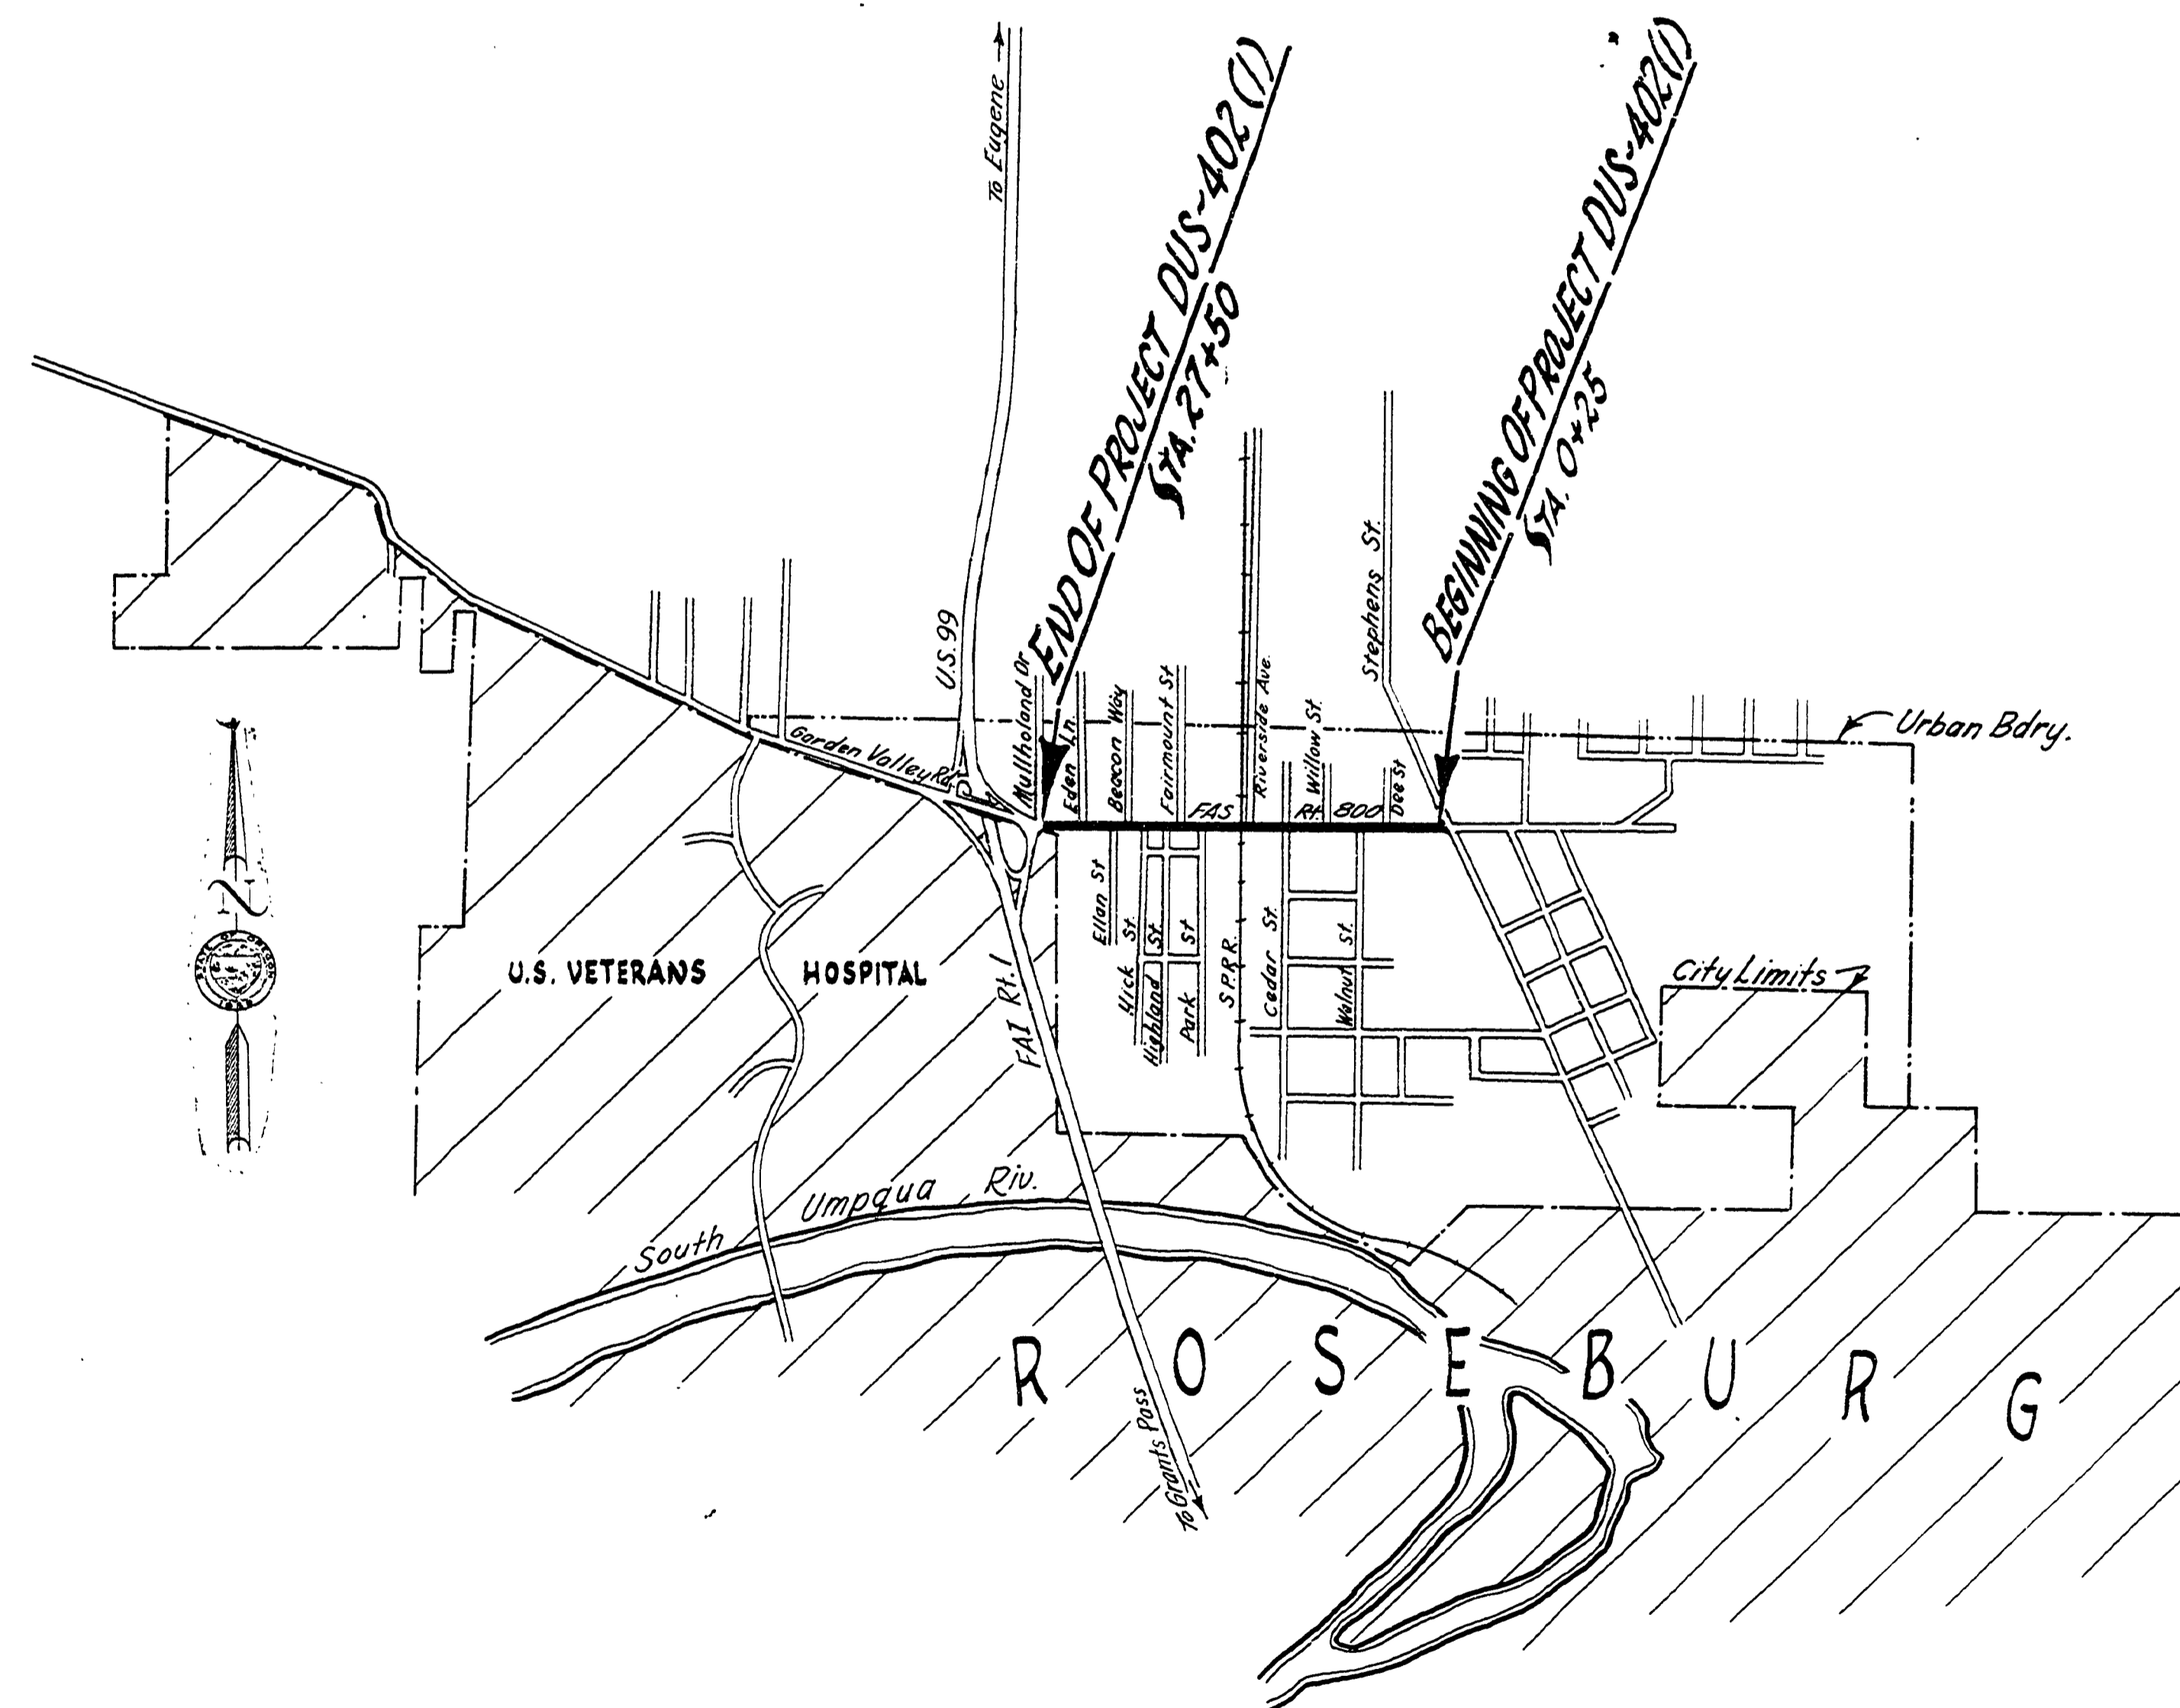

**CONVENTIONAL SIGNS**

- State Line
- County Line
- City or Town Limits
- Township Line
- Section Line
- Donation Land Claim Line
- Fence Line
- Guard Rail
- Unfenced Property or Right of Way Line
- Existing Roads
- Trails
- Base or Survey Line
- Railroads
- Retaining Wall
- Culverts
- Drop Inlet
- Trolley Pole
- Power Pole
- Telephone or Telegraph Poles
- Marsh
- Irrigation Ditches
- Bridges
- Trees

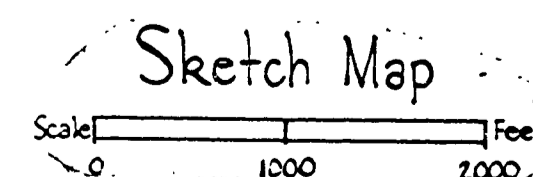

FILED  
 RECEIVED  
 SEP 22 1958  
 COUNTY CLERK  
 DOUGLAS COUNTY



STATE HIGHWAY ENGINEER

STATE HIGHWAY COMMISSION  
 M. K. McIver Chairman  
 Robert B. Chessman Commissioner  
 Kenneth N. Fridley Commissioner

DEPARTMENT OF COMMERCE  
 BUREAU OF PUBLIC ROADS  
 APPROVED: \_\_\_\_\_  
 DIVISION ENGINEER DATE

000005C




# SUMMARY

Length of Project DUS 402 (I) 0.516 Miles


ITEM	UNIT	NET QUANTITY	ALLOWANCE	TOTAL QUANTITY
Clearing & Grubbing	All	All		All
Removal of Curbs	Lin.Ft.	265	25	290
Removal of Catch Basins	One	5	1	6
Removal of Miscellaneous Concrete & Masonry	All	All		All
Drainage Excavation, Unclassified	Cu.Yd.	558	52	610
Structural Excavation, Unclassified	"	7	1	8
General Excavation, Unclassified	"	6,655	665	7,320
Finishing Roadbed & Slopes	All	All		All
8-inch Sewer Pipe	Lin.Ft.	540	50	590
12-inch " "	"	656	64	720
15-inch " "	"	632	58	690
18-inch " "	"	216	24	240
18-inch Asbestos-Protected Corrugated Metal Pipe, Protected Invert, 12 Gauge	"	32	4	36
Extra For Pipe Under Pavement	"	208	22	230
6-inch Concrete Drain Pipe	"	16	2	18
Salvaging Culvert Pipe	"	60	6	66
1 1/4-inch Electrical Conduit	"	120	10	130
Concrete Manholes	One	6	1	7
Concrete Inlets, Type "G"	"	19	1	20
Concrete Curbs	Cu.Yd.	127	13	140
Adjustment of Manholes	One	11	1	12
Adjustment of Catch Basins	"	2	1	3
Class "A" Concrete in Box Culverts & Retaining Walls	Cu.Yd.	80	10	90
Metal Reinforcement in Box Culverts & Retaining Walls	Lb.	9,760	490	10,250
Pipe Handrail	Lin.Ft.	178	12	190
Coarse Crushed Material in Base	Cu.Yd.	5,246	524	5,770
3/4" O Material in Base	"	960	90	1,050
Sprinkling	M-Gal.	156	14	170
Preparation of Base	All	All		All
3/4" O Material in Binder Course	Cu.Yd.	100	10	110
RC-3 Asphalt	Ton	16	2	18
RS-1 Asphalt	"	1	1	2
Class "B" Asphaltic Concrete	"	2,555	125	2,680

# TYPICAL SECTIONS

EAST UNIT, GARDEN VALLEY ROAD SEC. GARDEN VALLEY RD. DOUGLAS CO.				SHEET No. 2
FED. ROAD Div. No.	STATE	PROJECT NUMBER	FISCAL YEAR	TOTAL SHEETS
8	OREGON	DUS-402(I)		See Index

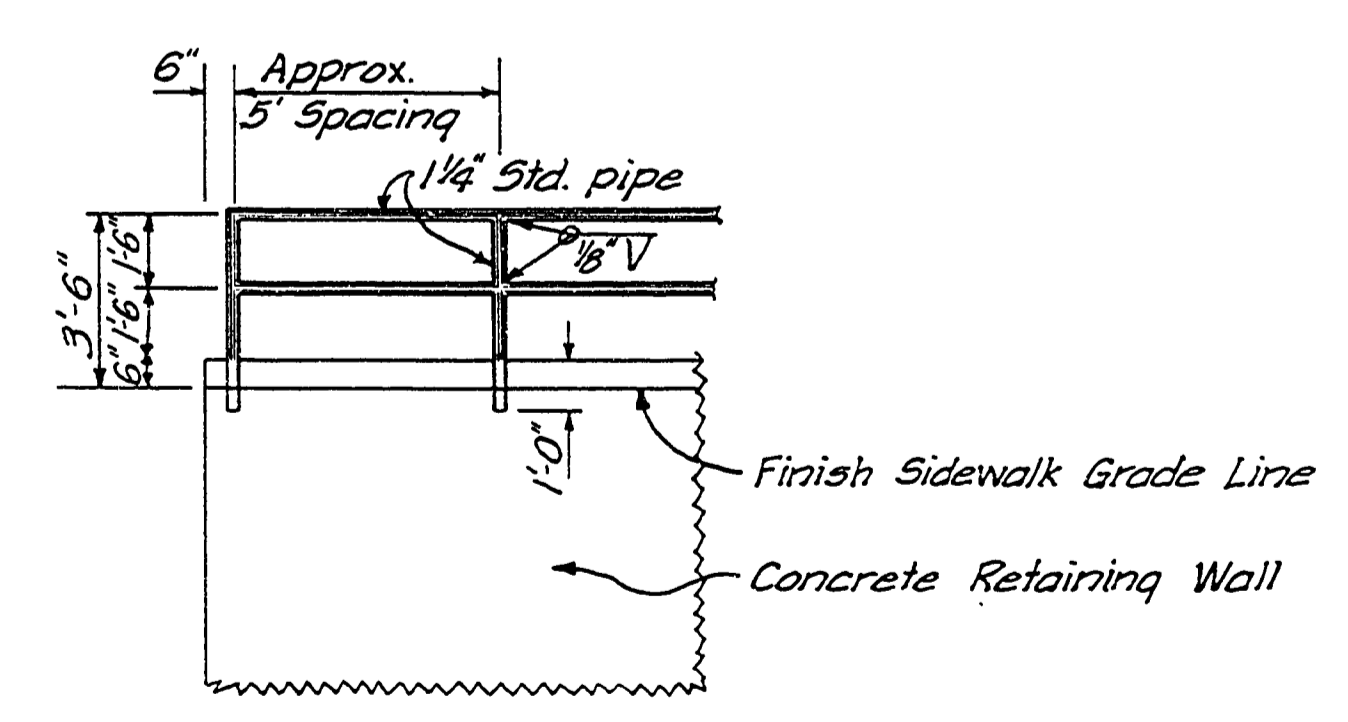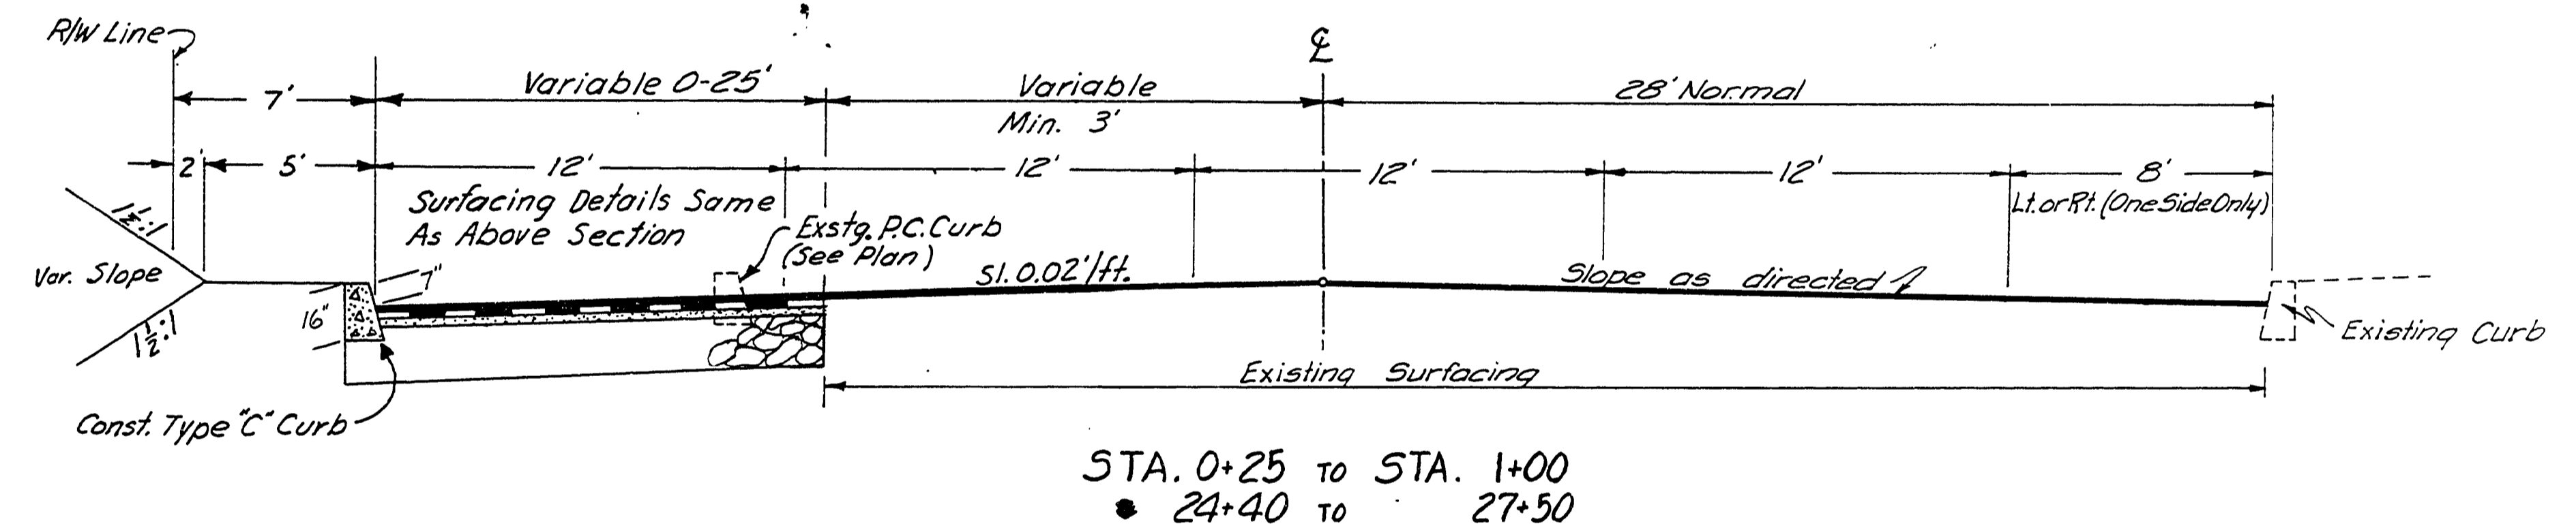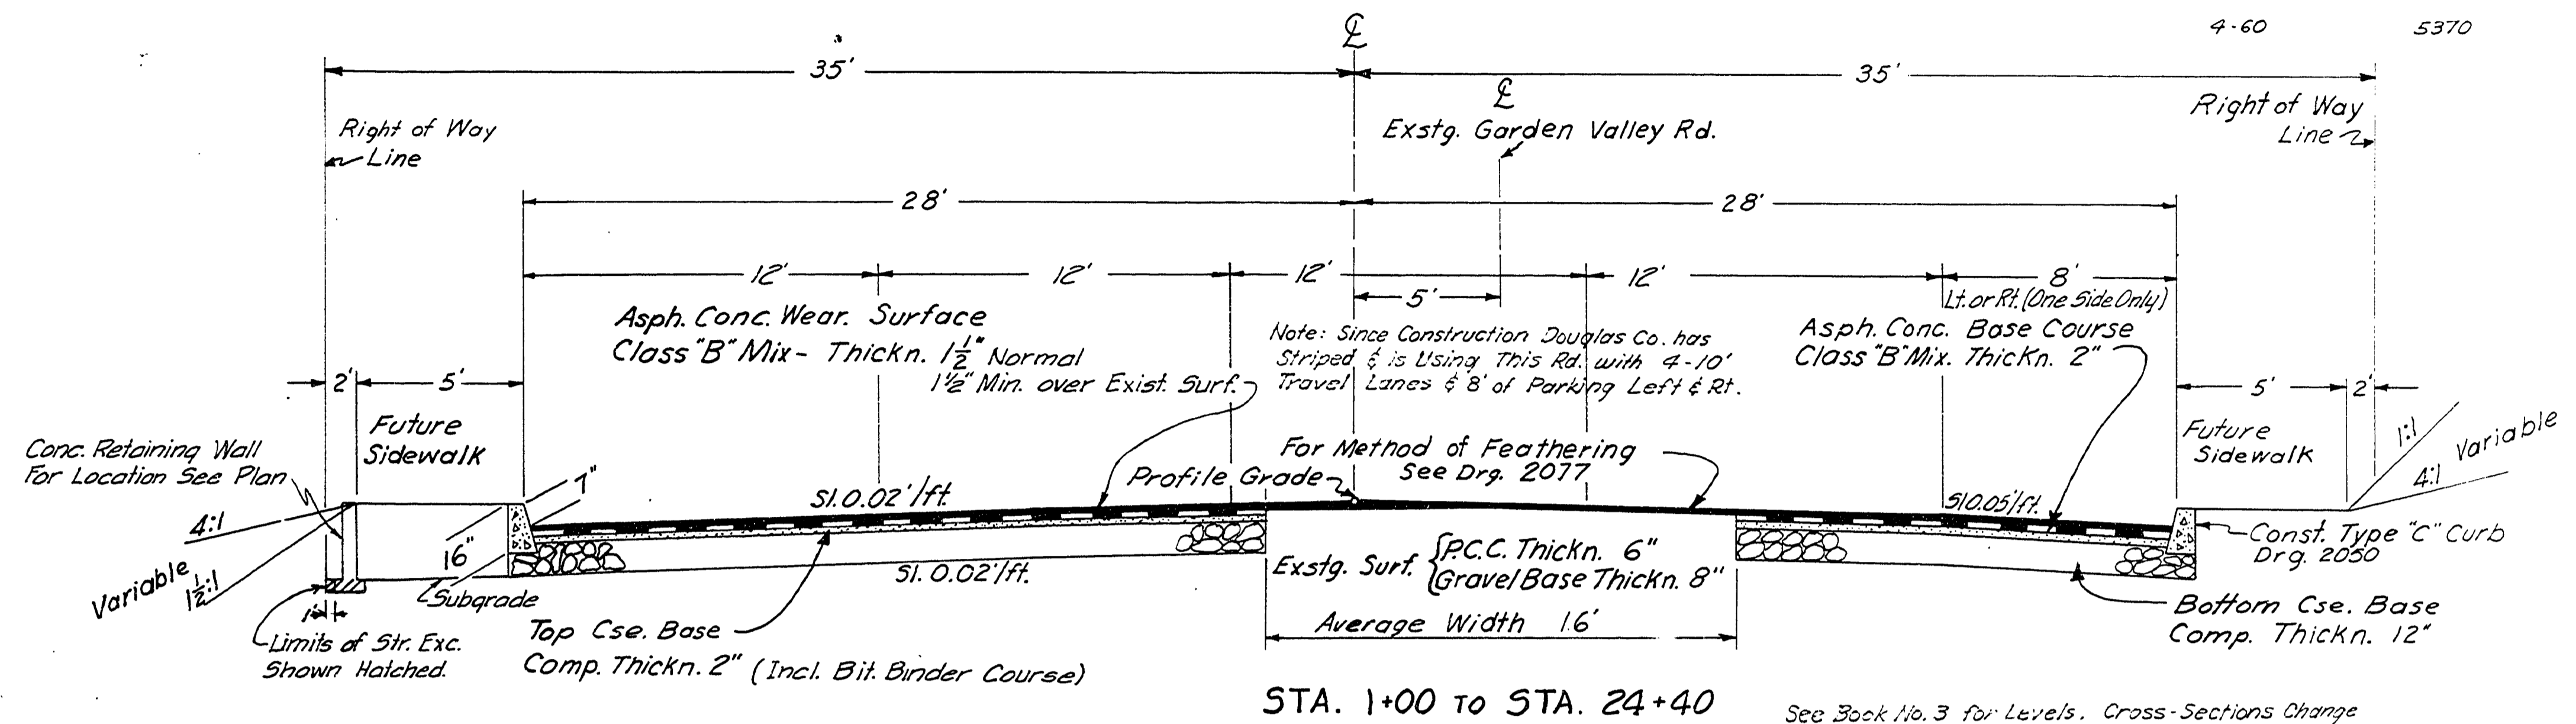

HANDRAIL DETAIL for CONCRETE RETAINING WALLS

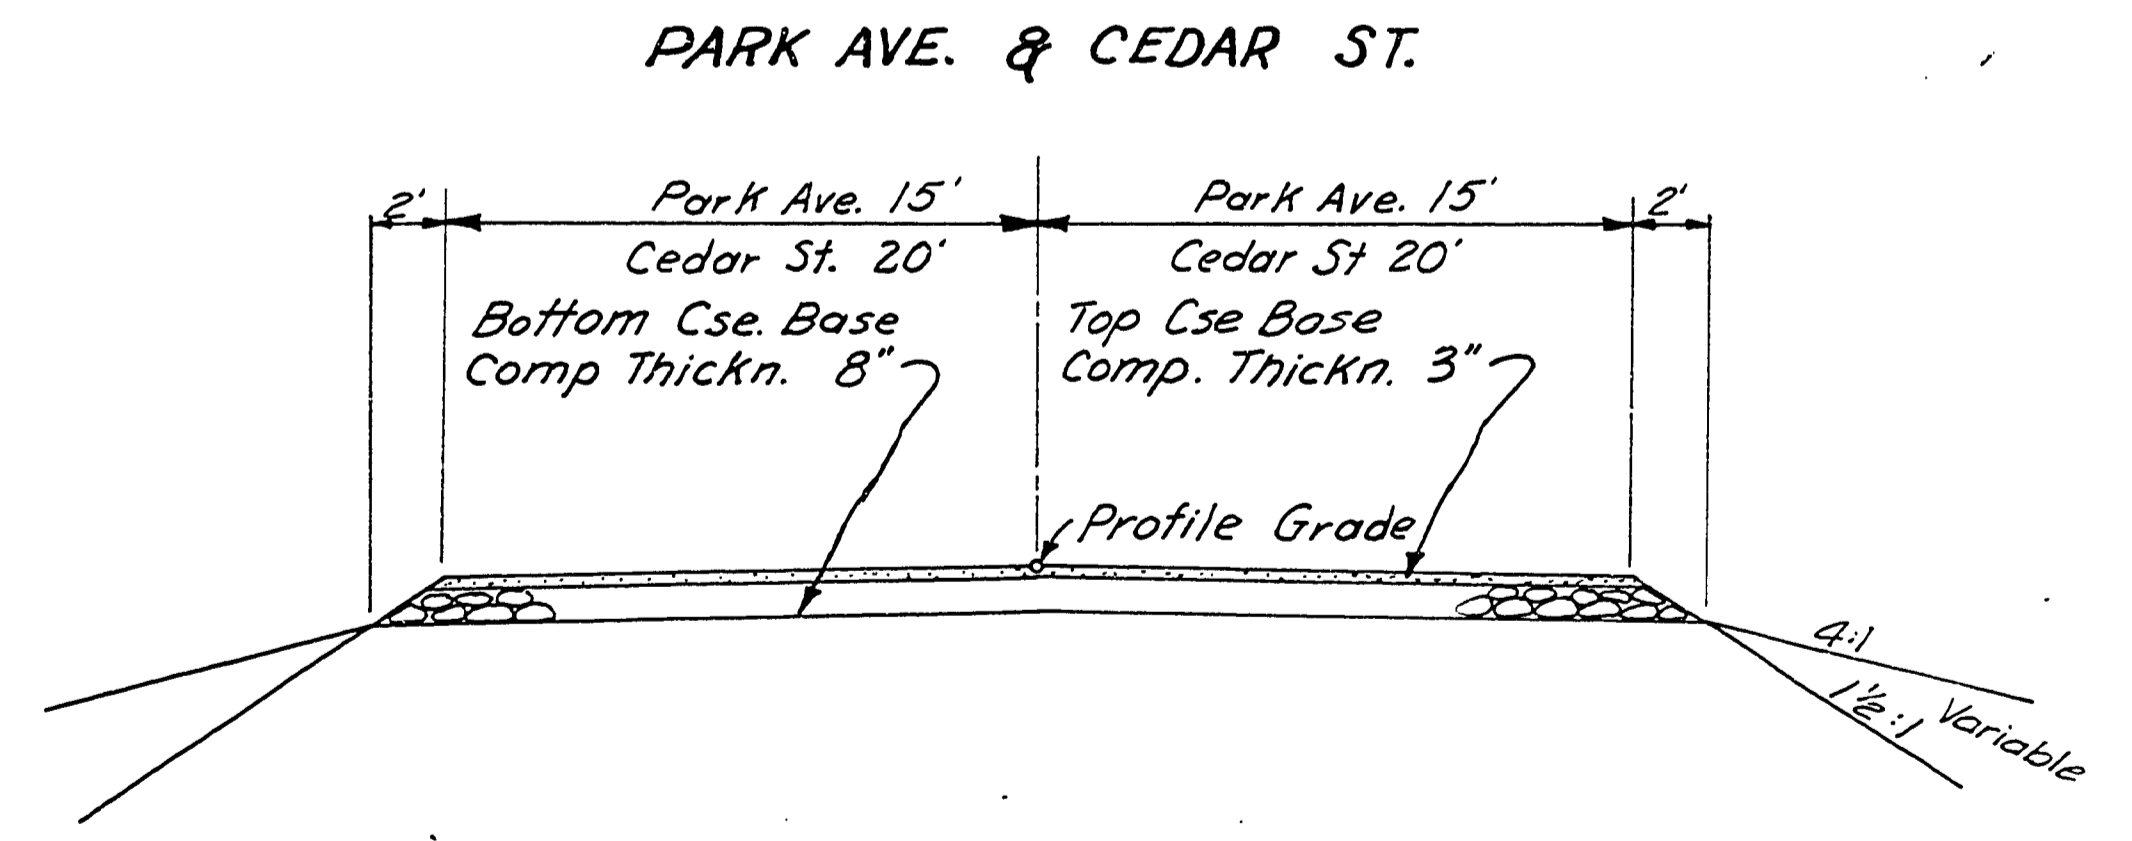

FILED RECEIVED  
DEC 22 1966  
COUNTY SURVEYOR  
DOUGLAS COUNTY, ORE.



Rd # 6

000005T

T. 27 S. R. 6 W. M. Sec. 13

EAST UNIT GARDEN VALLEY ROAD SEC. GARDEN VALLEY RD. DOUGLAS CO.				
FED ROAD Div. No.	STATE	PROJECT NUMBER	FISCAL YEAR	TOTAL SHEETS see Index
8	OREGON	DUS-402 (1)		3

Note: Profile Grade Shown On Plans Adjusted as Required, to Provide Minimum of Asphaltic Pavement Over Existing Pavement as Shown On Typical Sections.

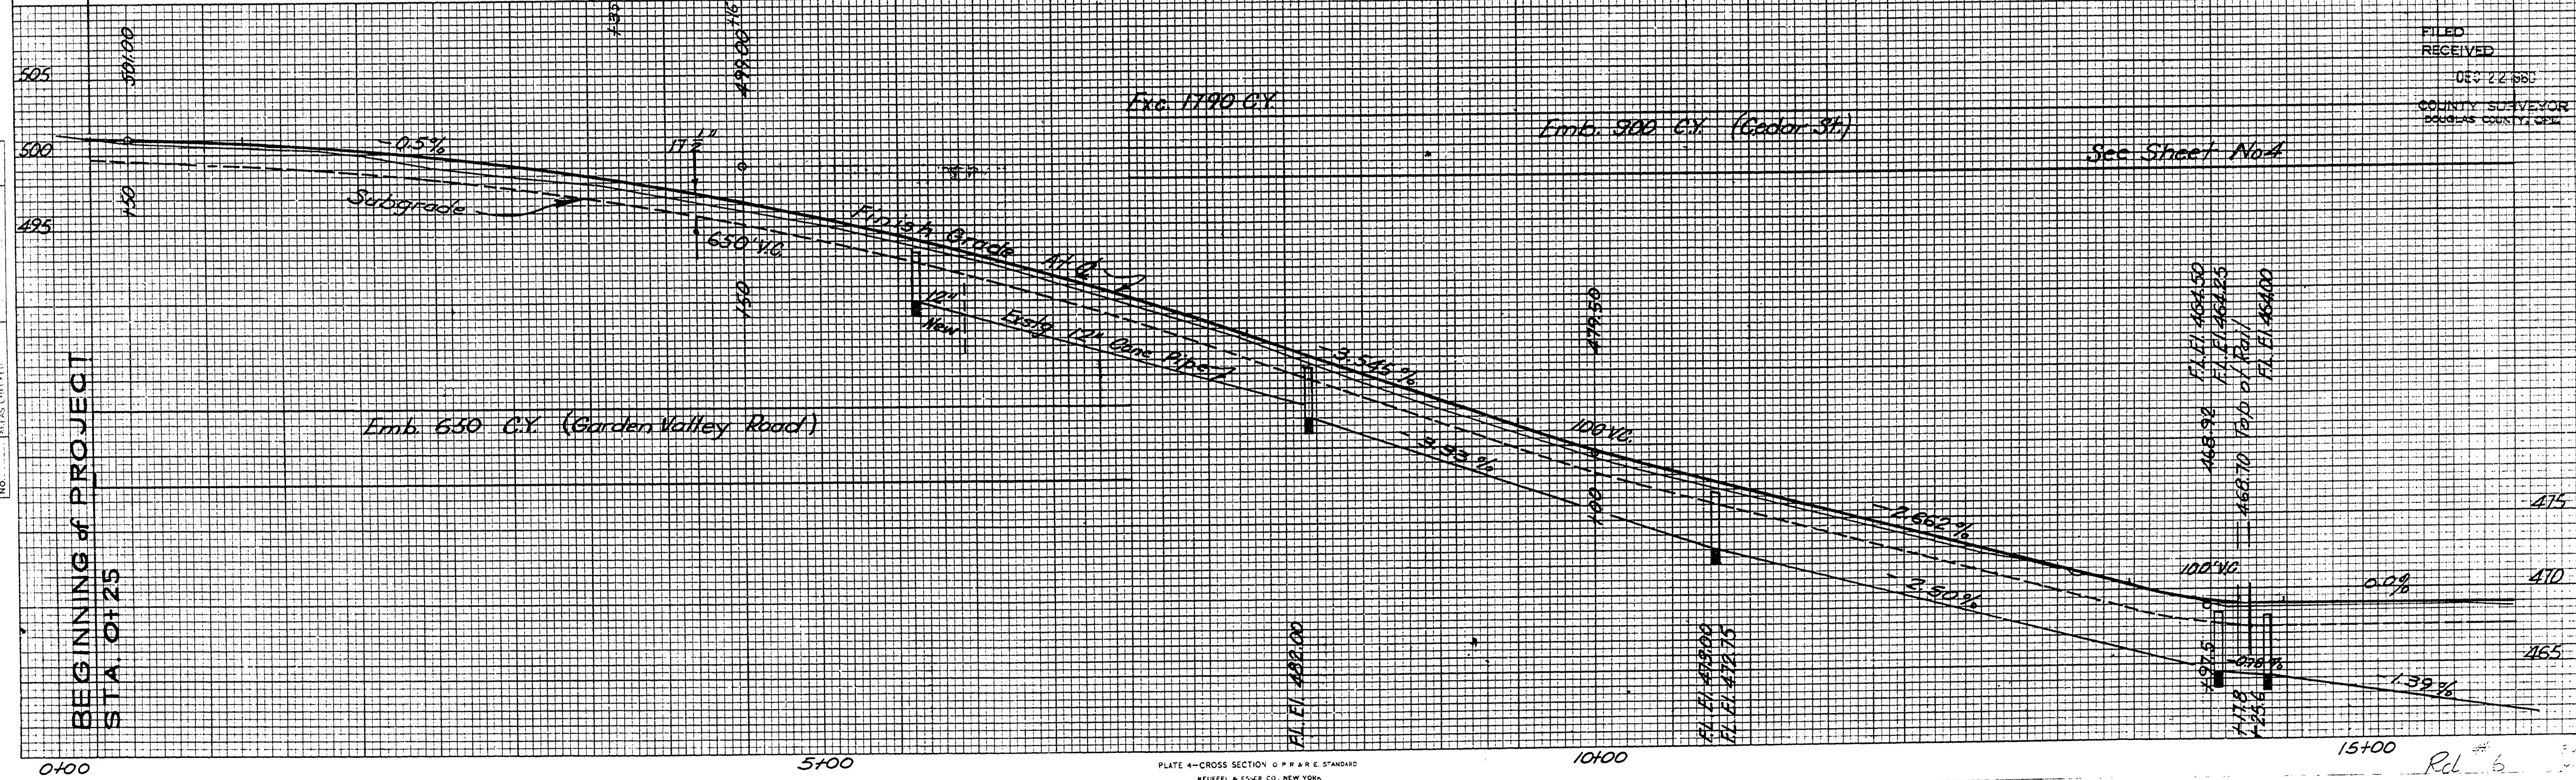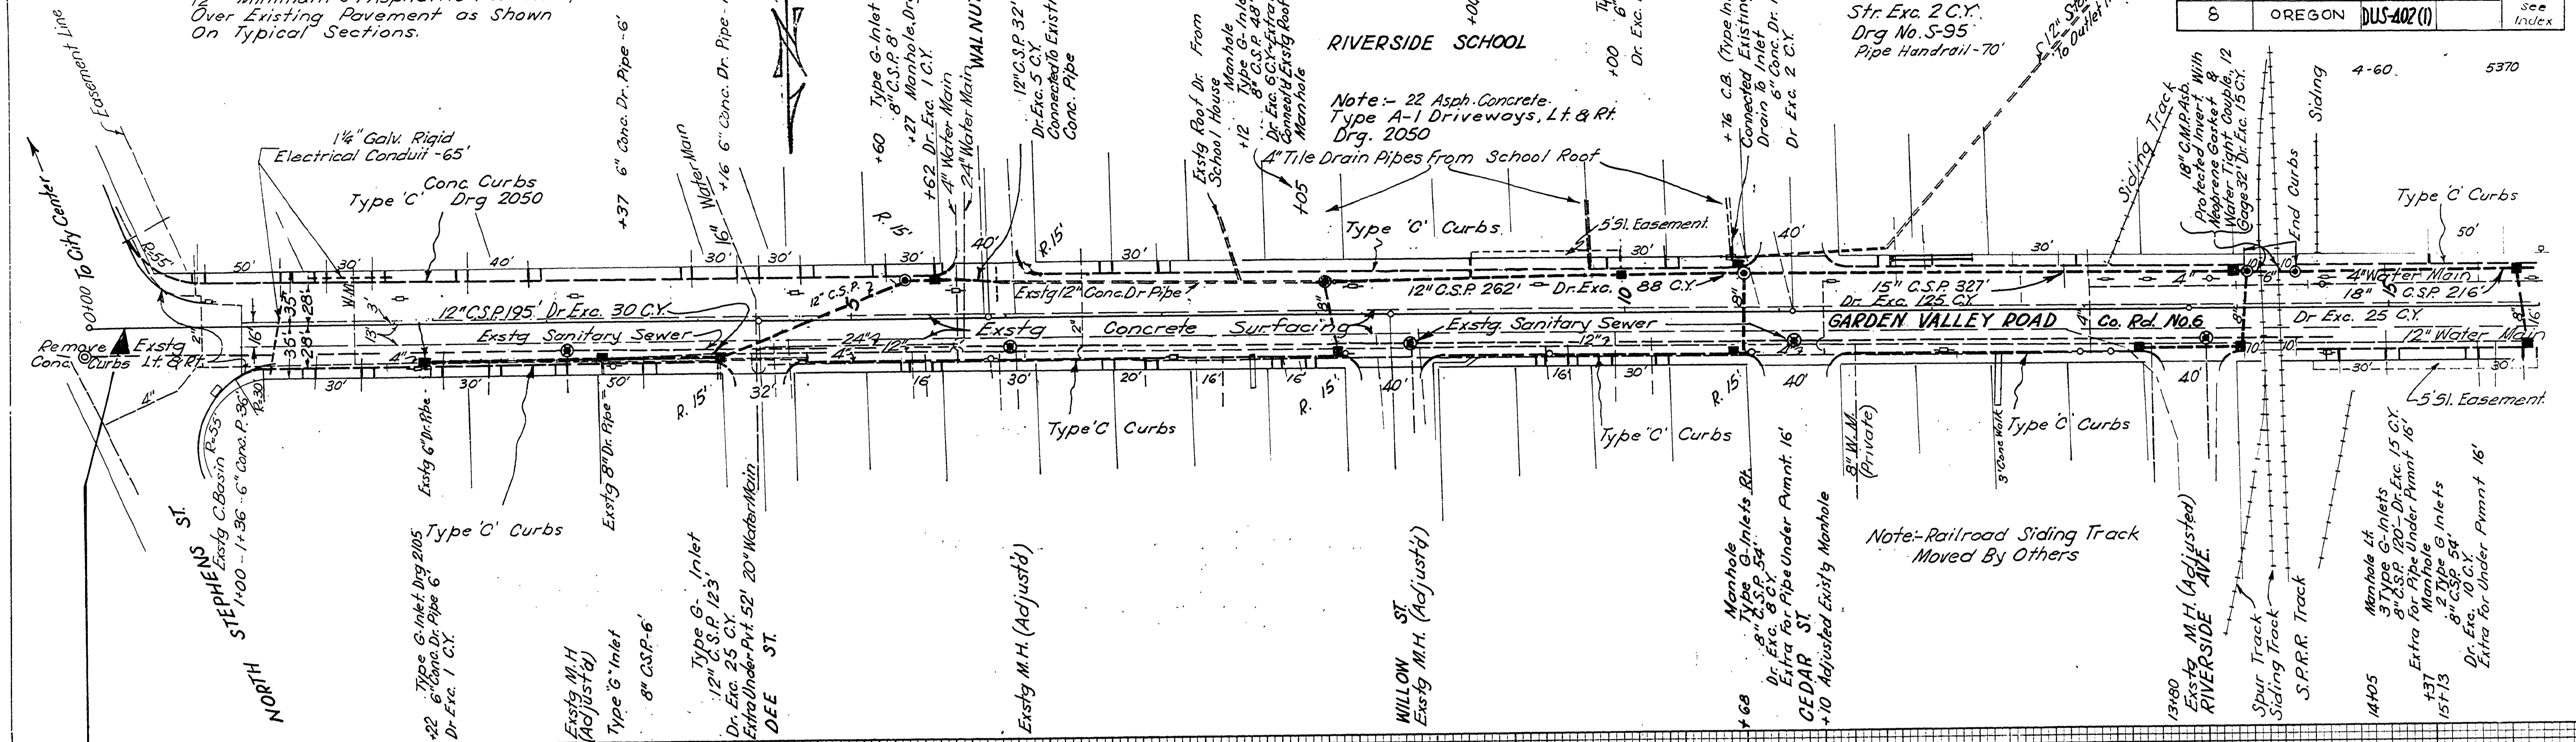

FINAL SURVEY NO. 1000000000

ORIGINAL SURVEY NO. 1000000000



00000028

T.27S.R.6 W.W.M. Sec 13

FILED RECEIVED DEC 22 1963 COUNTY SURVEYOR DOUGLAS COUNTY, ORE.

EAST UNIT GARDEN VALLEY ROAD SEC. GARDEN VALLEY RD. DOUGLAS CO				SHEET NO. 4
FED. ROAD Div. No. 8	STATE OREGON	PROJECT NUMBER DUS-402 (1)	FISCAL YEAR	TOTAL SHEETS

4-60 5370

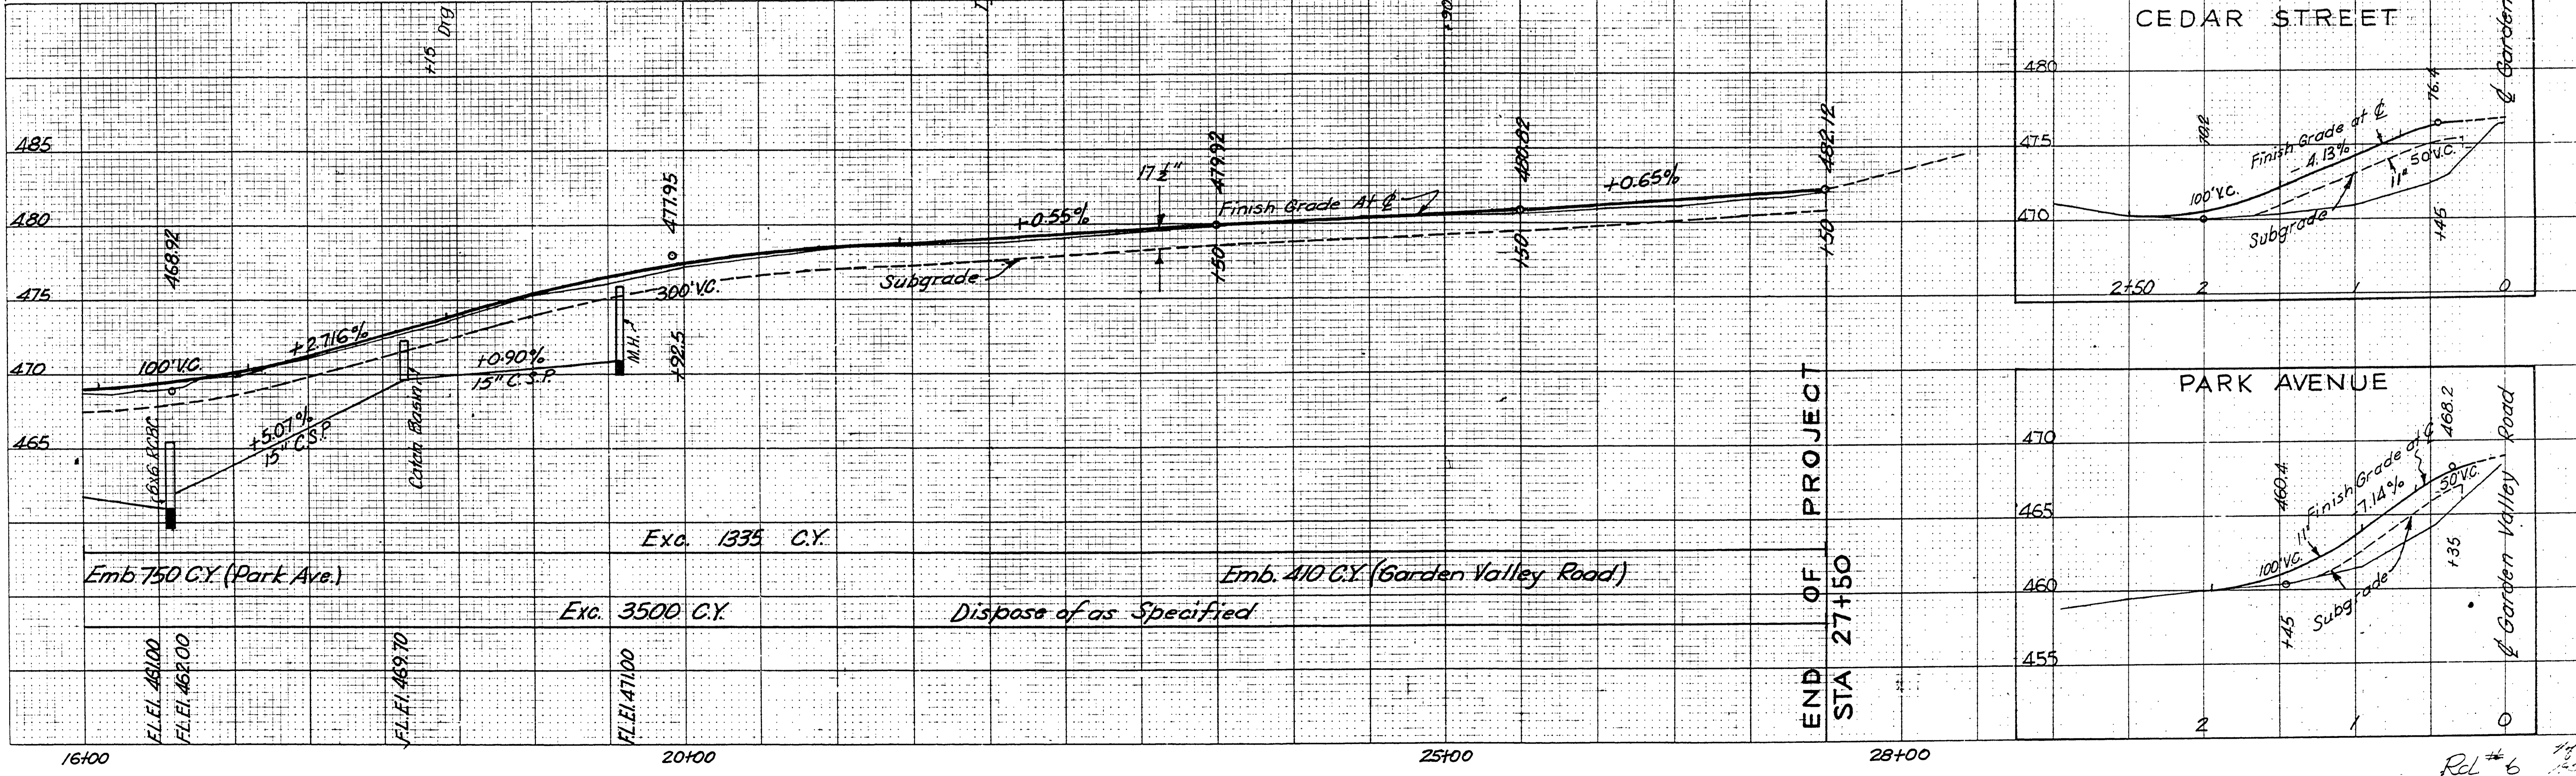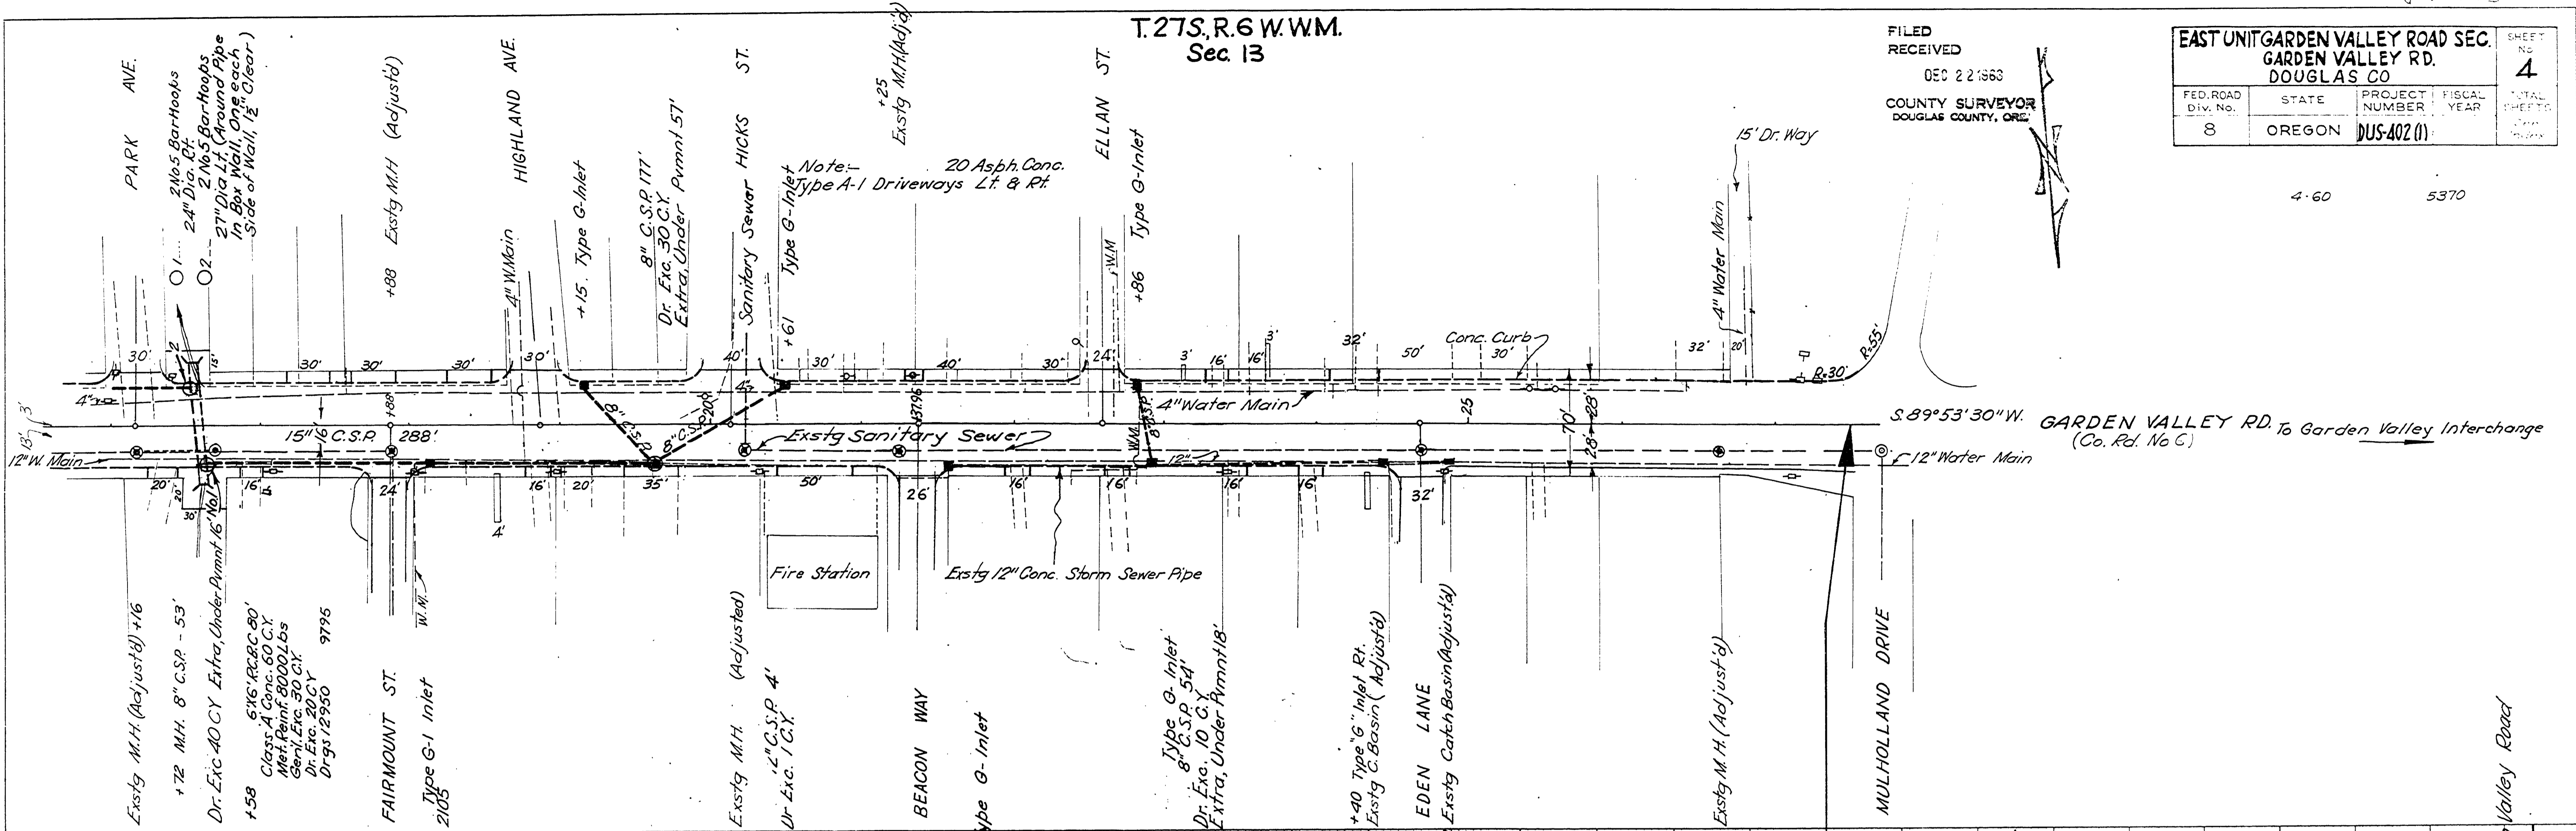

FINAL SURVEY NOTE BOOK NO.

ORIGINAL SURVEY NOTE BOOK NO. AREAS CHECKED

00300052