



**CURB PROFILE 28' LT**

1" = 5' VERT. 1" = 20' HORIZ.

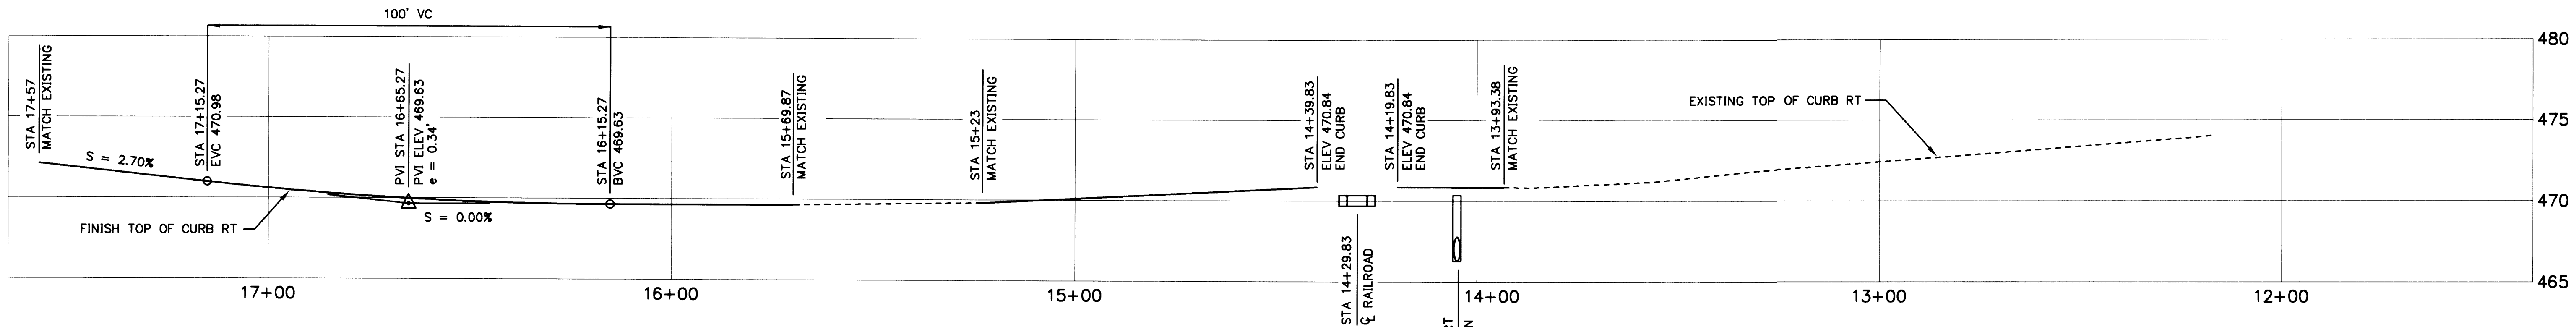

**CURB PROFILE 28' RT**

1" = 5' VERT. 1" = 20' HORIZ.

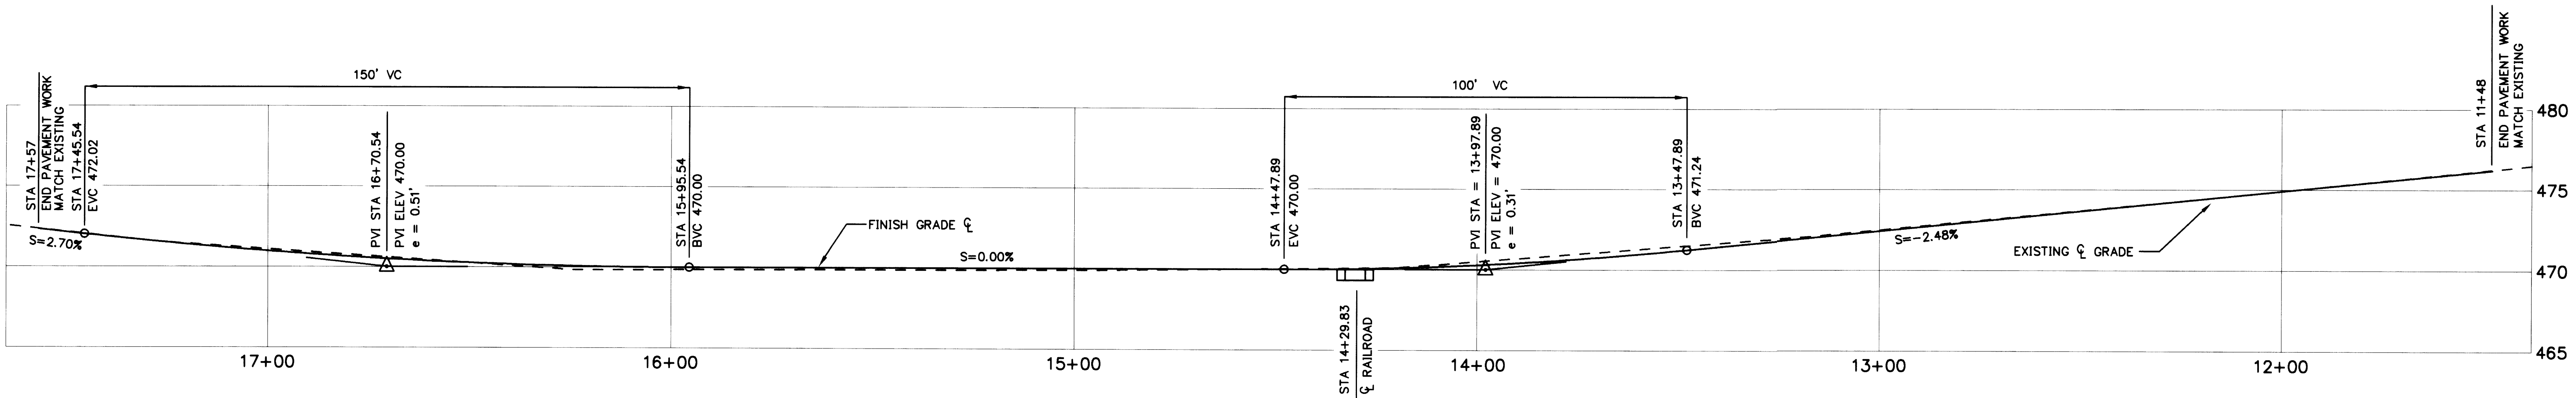

**CENTERLINE PROFILE**

1" = 5' VERT. 1" = 20' HORIZ.

DATE	NO.	REVISION	BY	DES.
FEB 2003	Δ	DRAWING OF RECORD	MJG	JDE
				JDE
				DAL

FILENAME: 2784C1.4D  
 PROJECT: CITY OF ROSEBURG  
 GARDEN VALLEY BLVD IMPROVEMENTS  
 PROJECT NO. 02UR03

SHEET TITLE: PROFILES  
 STA 11+48 TO STA 17+57

LEE ENGINEERING, INC.  
 CONSULTING ENGINEERS  
 OREGON CITY, OREGON

JOB NO. 2784  
 SHEET NO. C1.4  
 5