


DOUGLAS COUNTY OREGON






AS CONSTRUCTED

GRADING & PAVING GARDEN VALLEY ROAD

COUNTY ROAD NO. 6

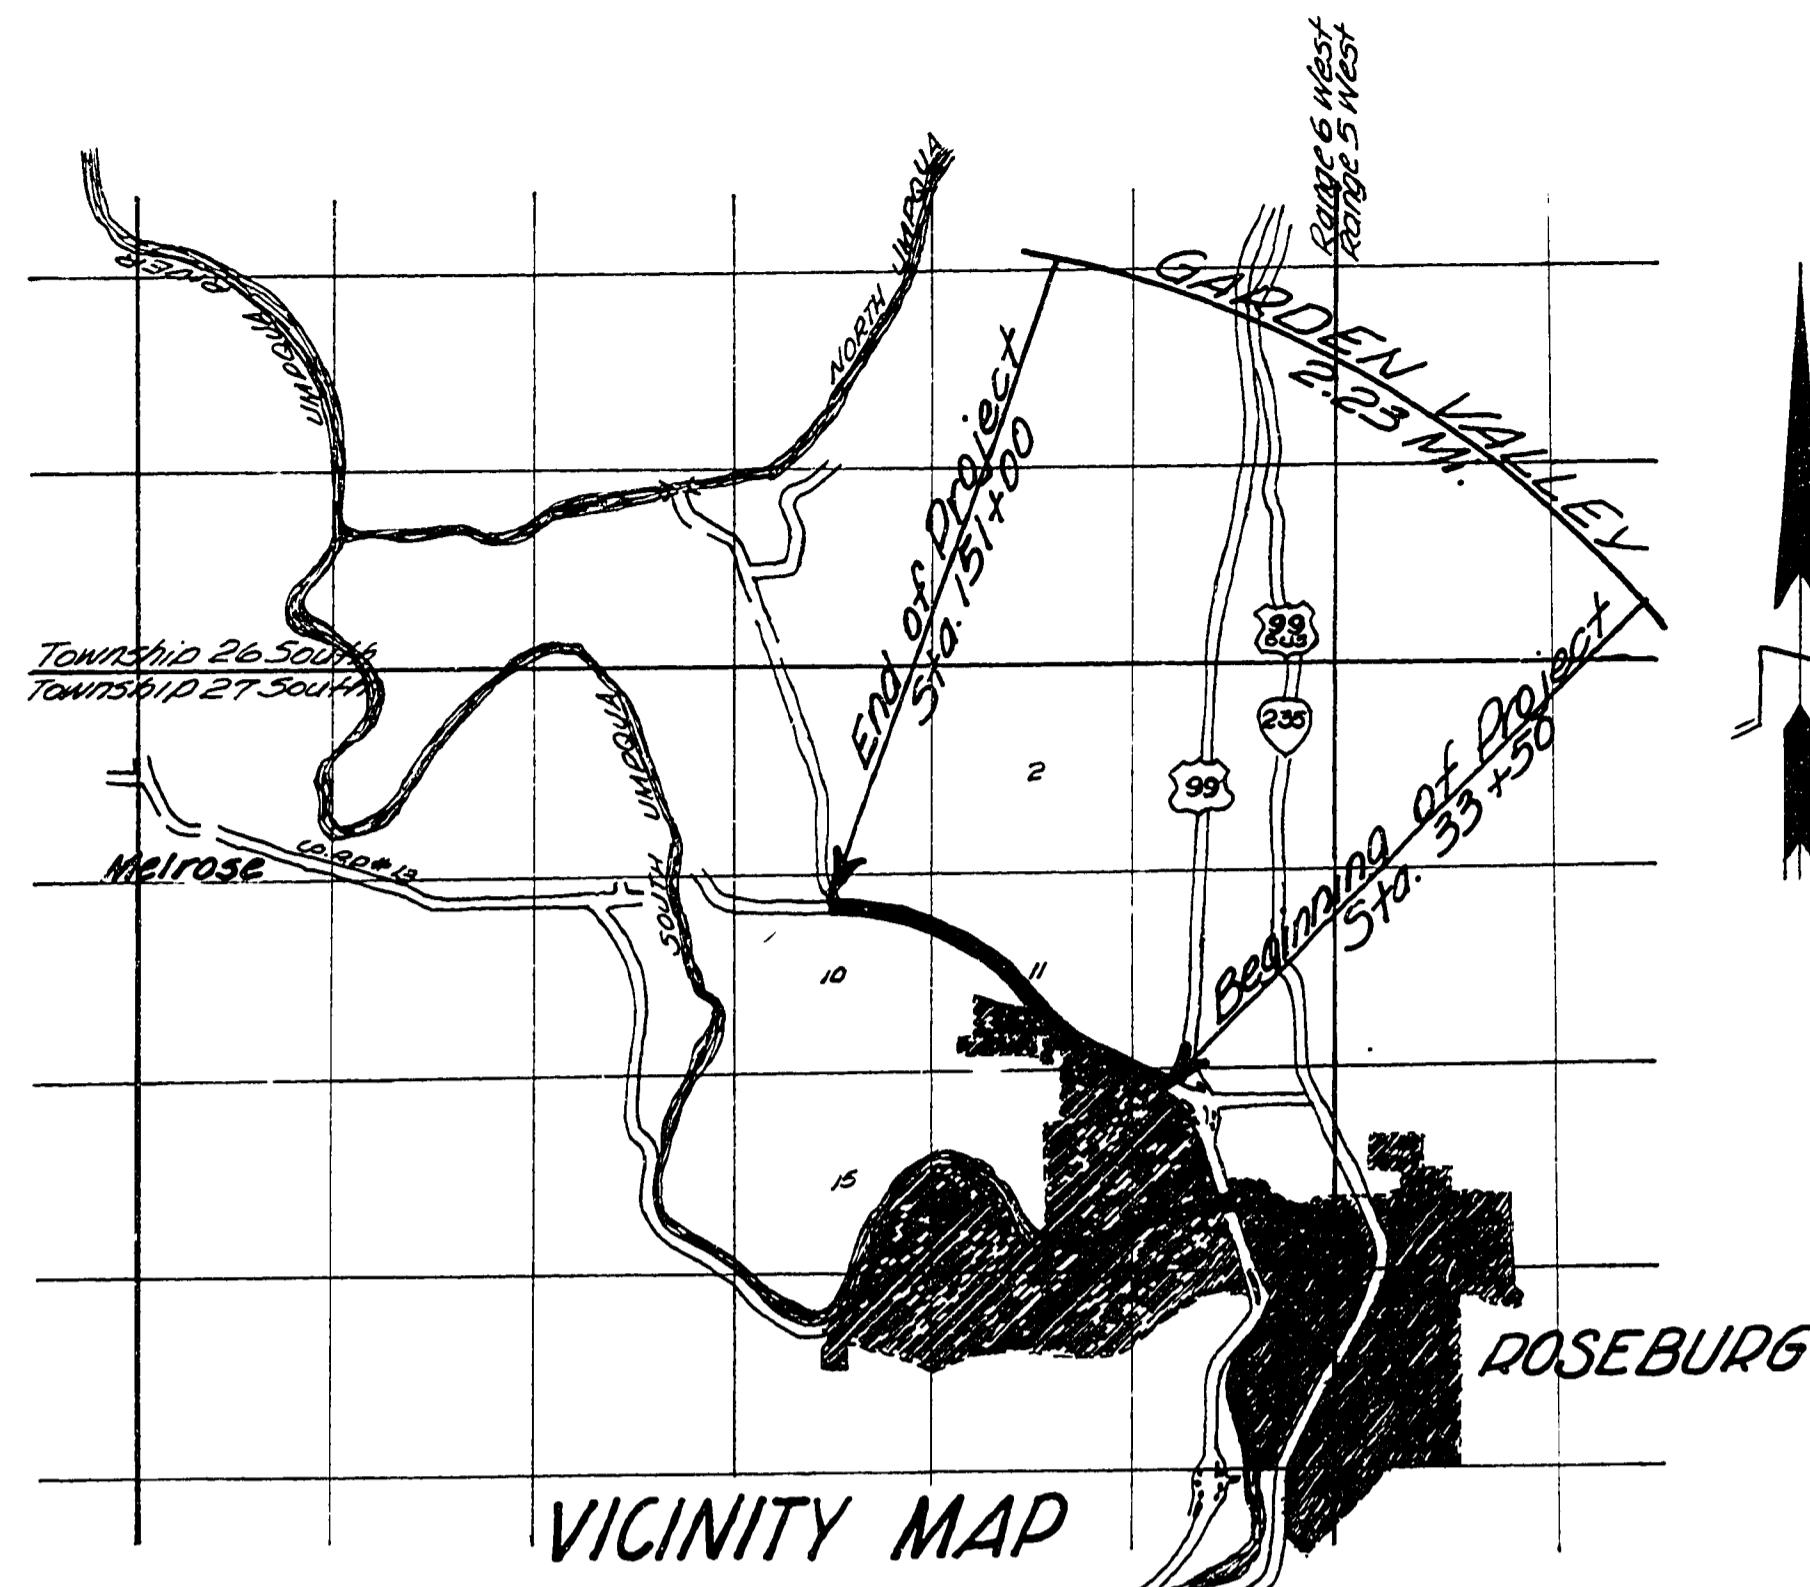

TYPICAL SECTIONS

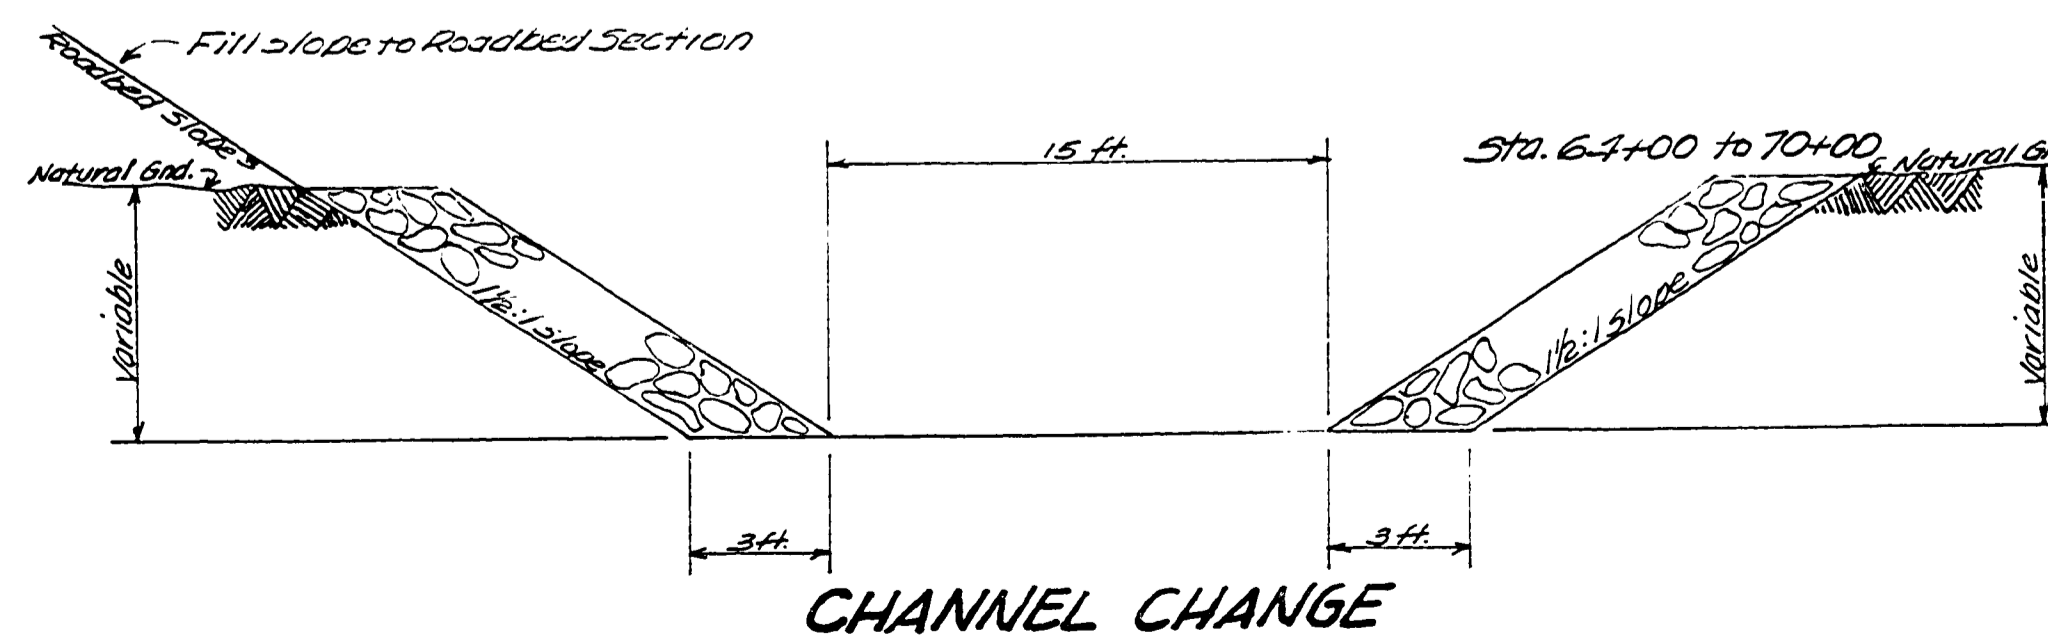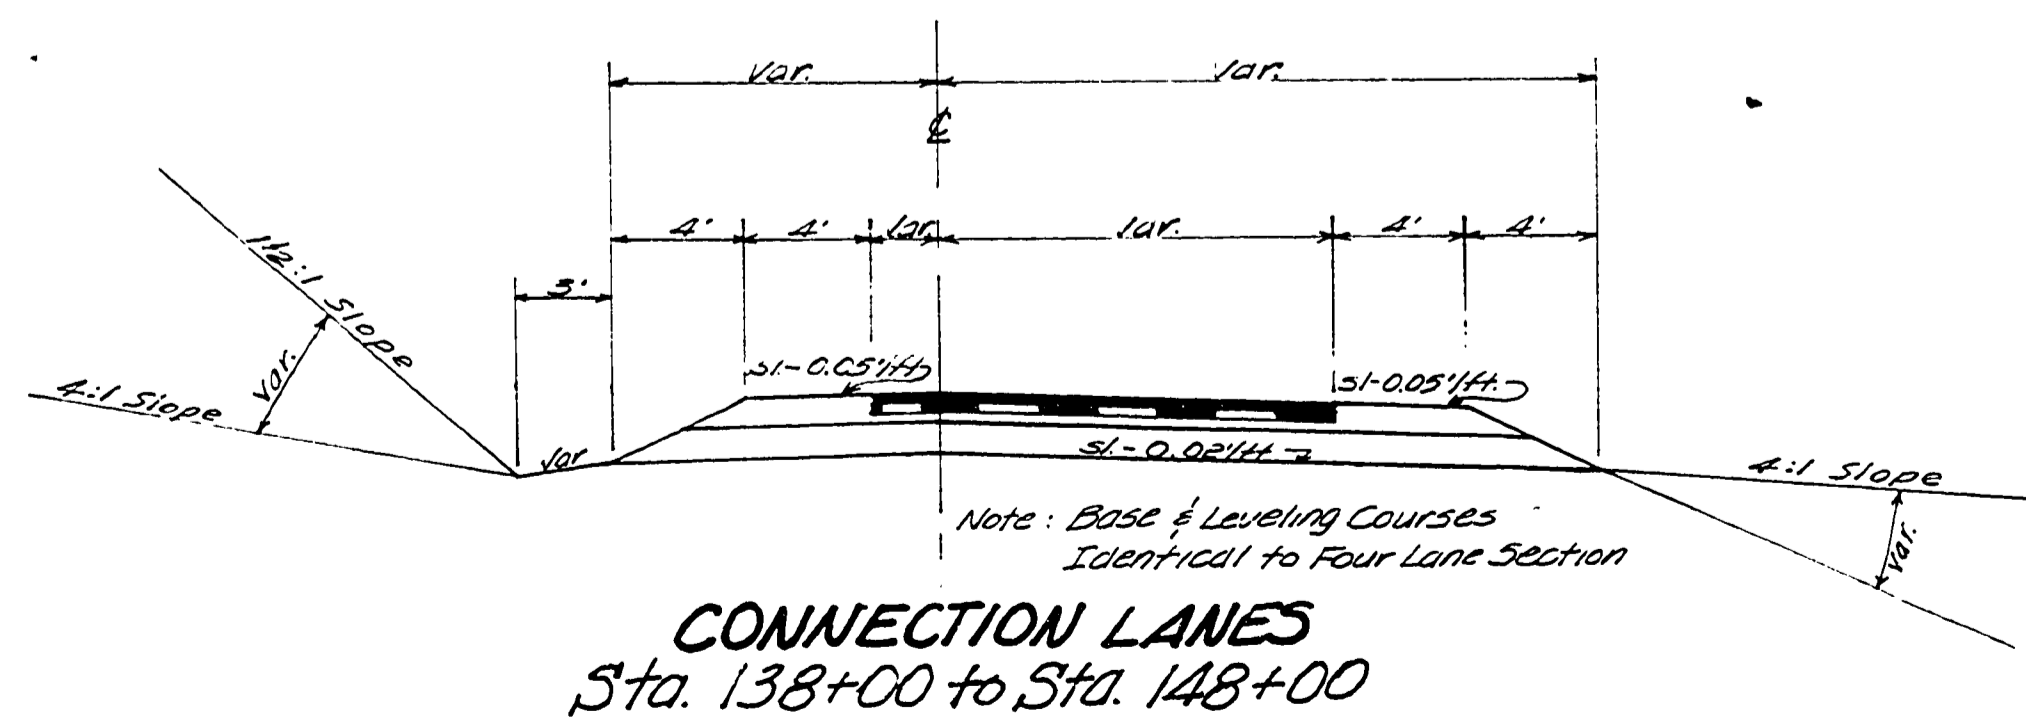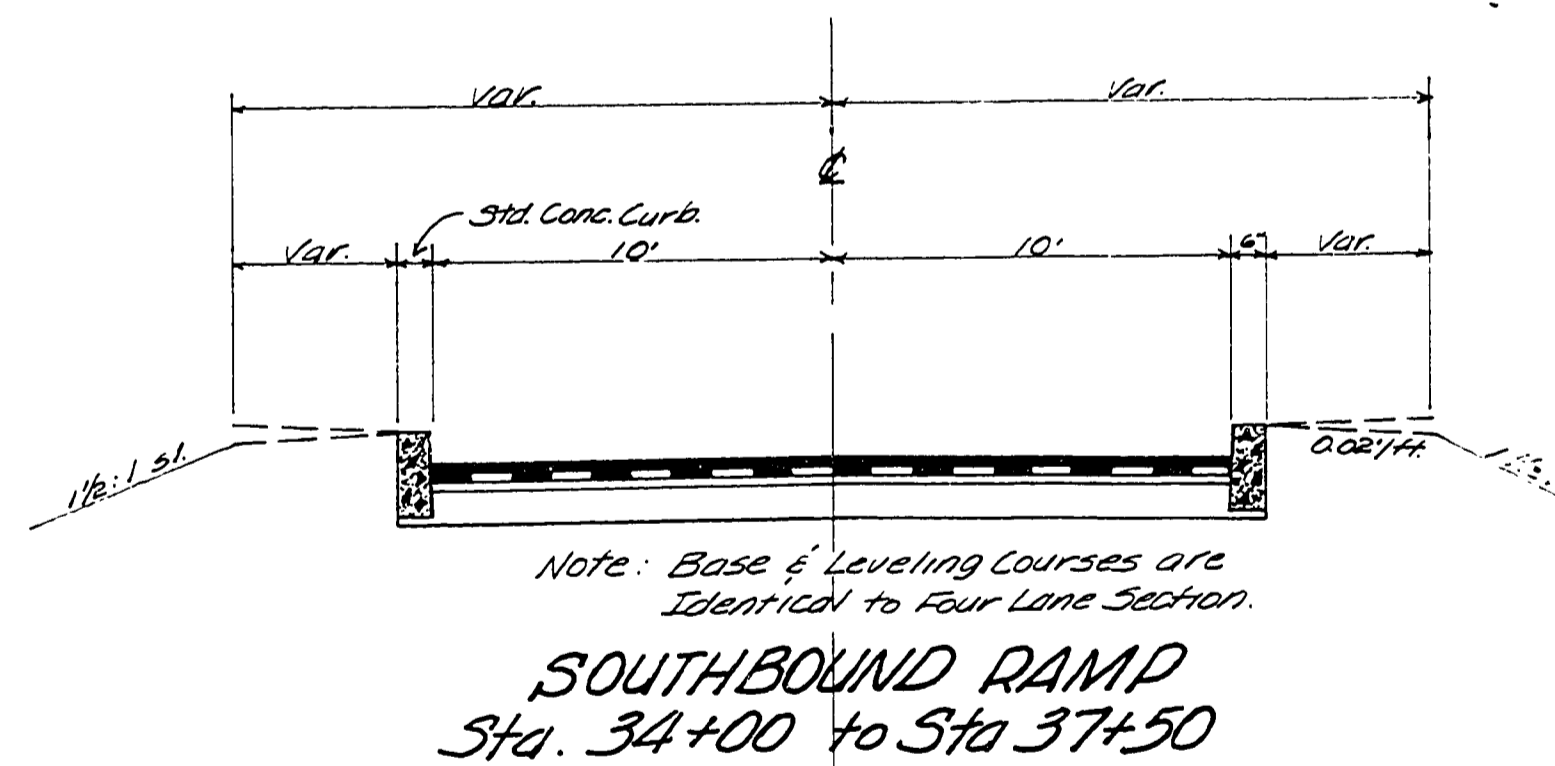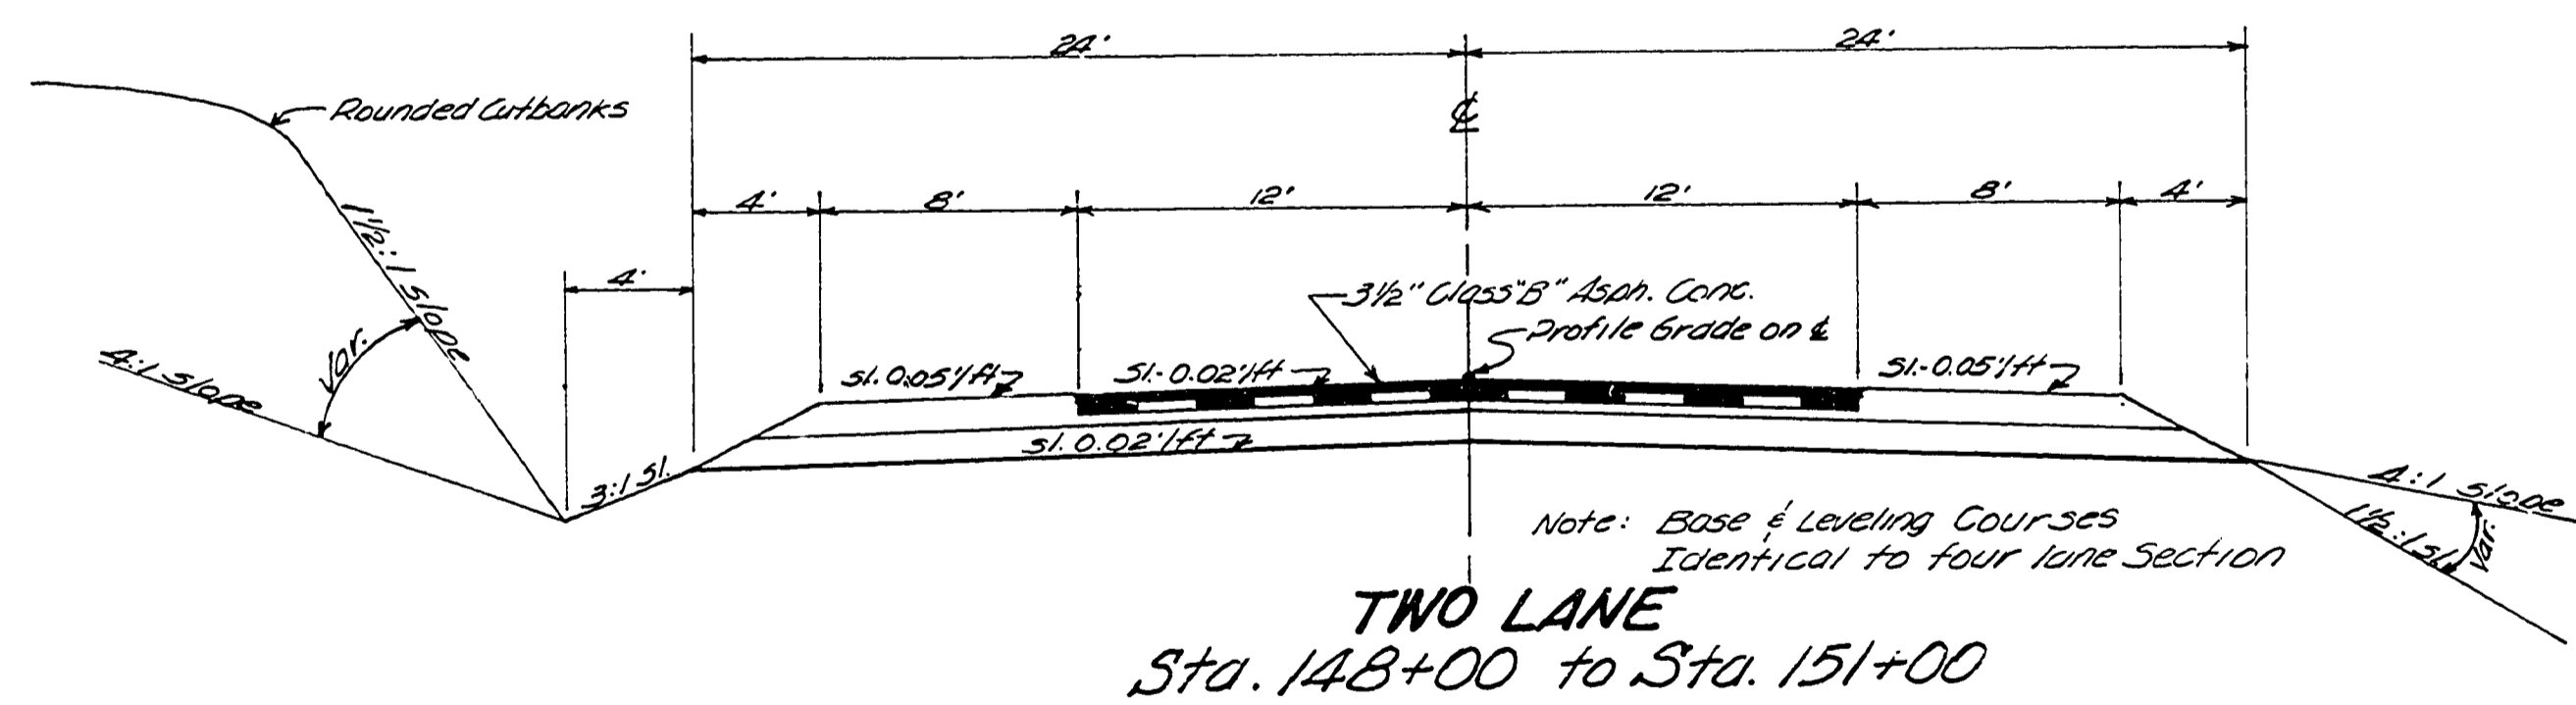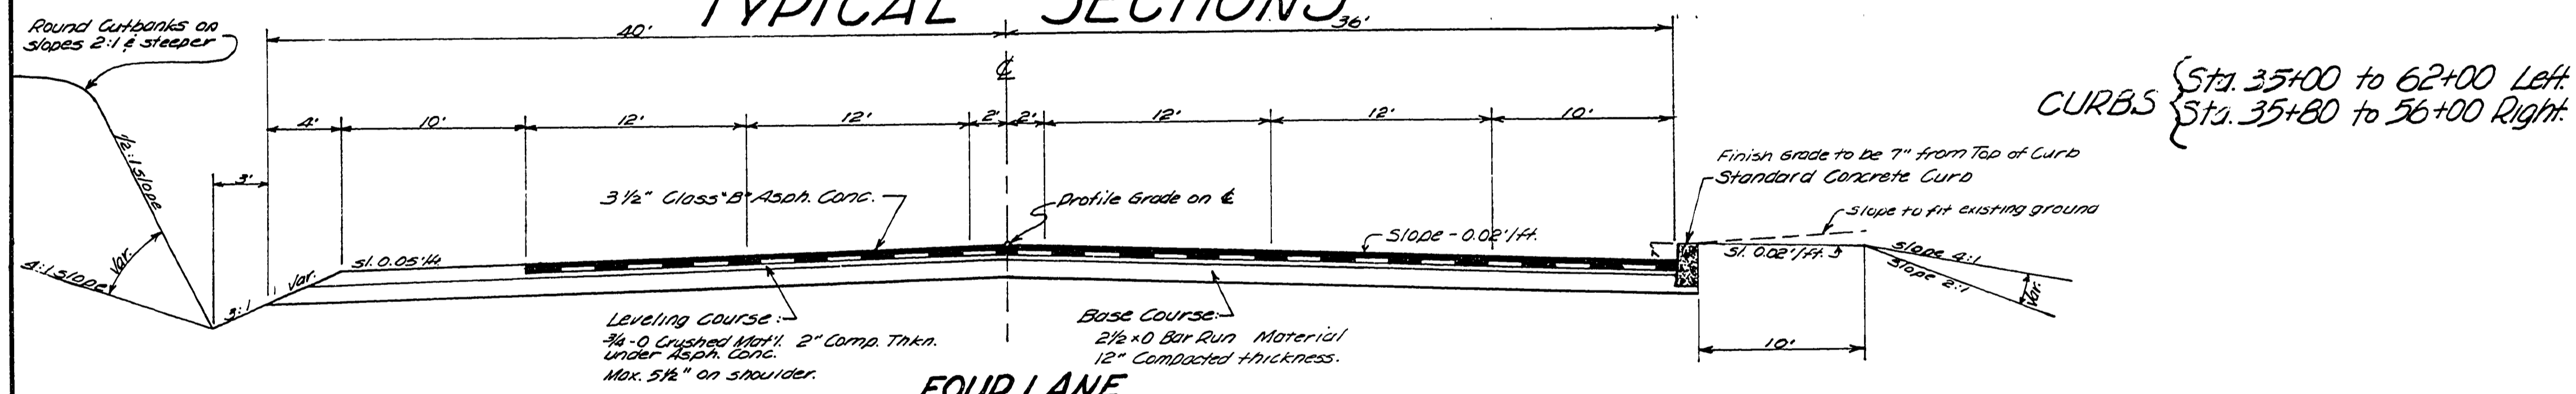

APPROVED George E. Smith Date May 29, 1962

0062TYPE

