



TYPICAL SECTION STA. 100+00 - 165+00 LT.
§ 100+00 - 171+00 RT.


TRANSITION SECTION STA. 165+00 - 166+00
23' TO 19' SUBGRADE WIDTH LEFT SIDE §
STA. 171+00 - 173+00 23' TO 19' SUBGRADE
WIDTH RT. SIDE.

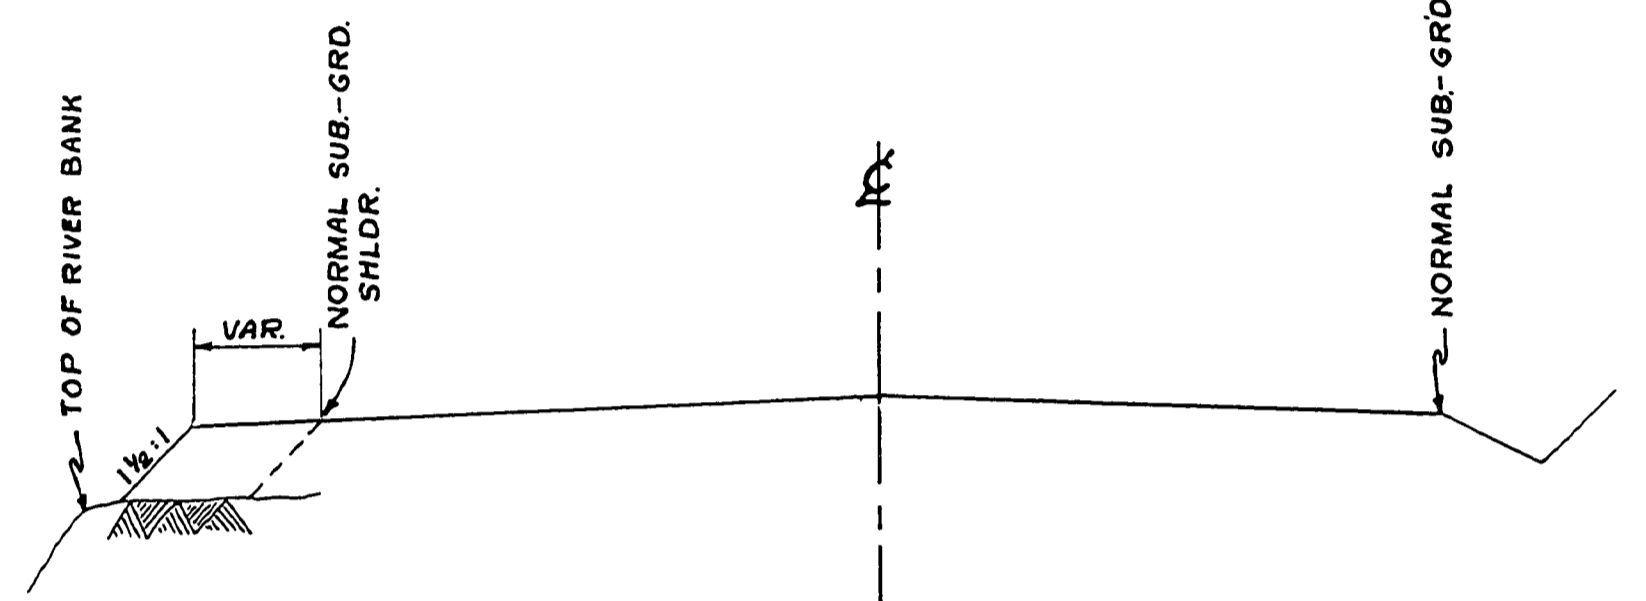


TYPICAL FILL WIDENING
STA. 285+00 TO 300+00

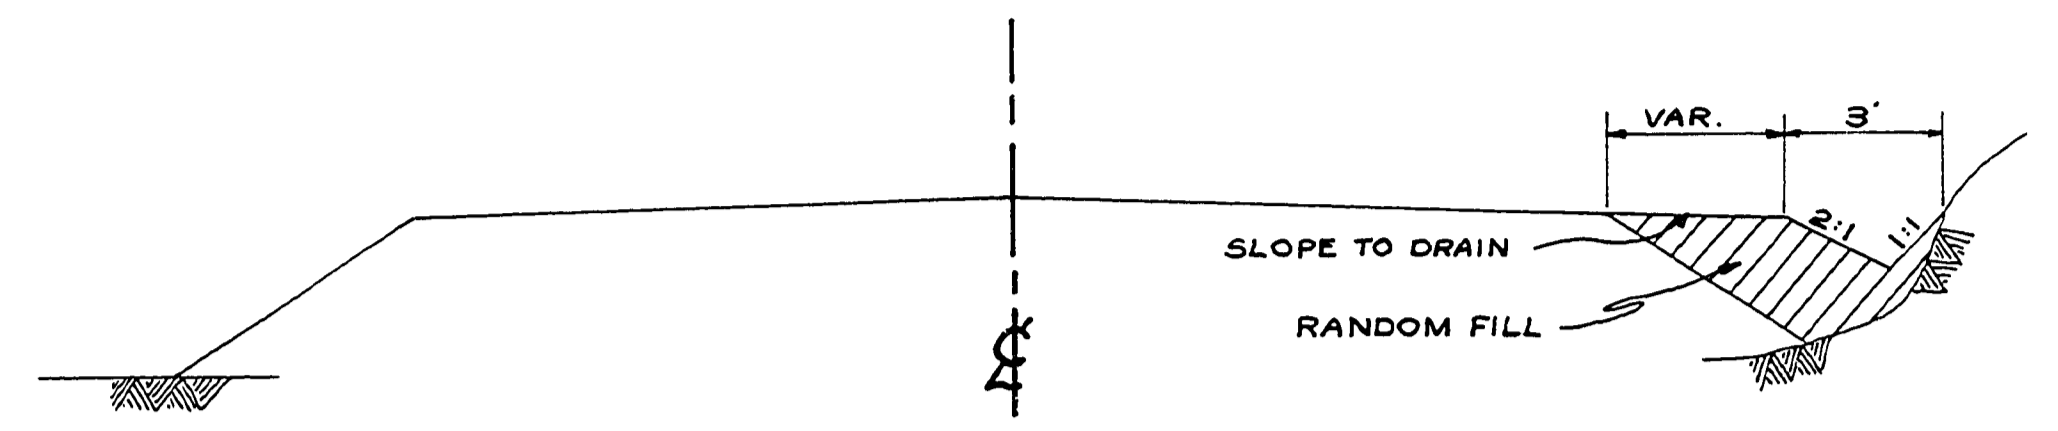


TYPICAL RANDOM FILL §
CUT OFF DITCH SECTION

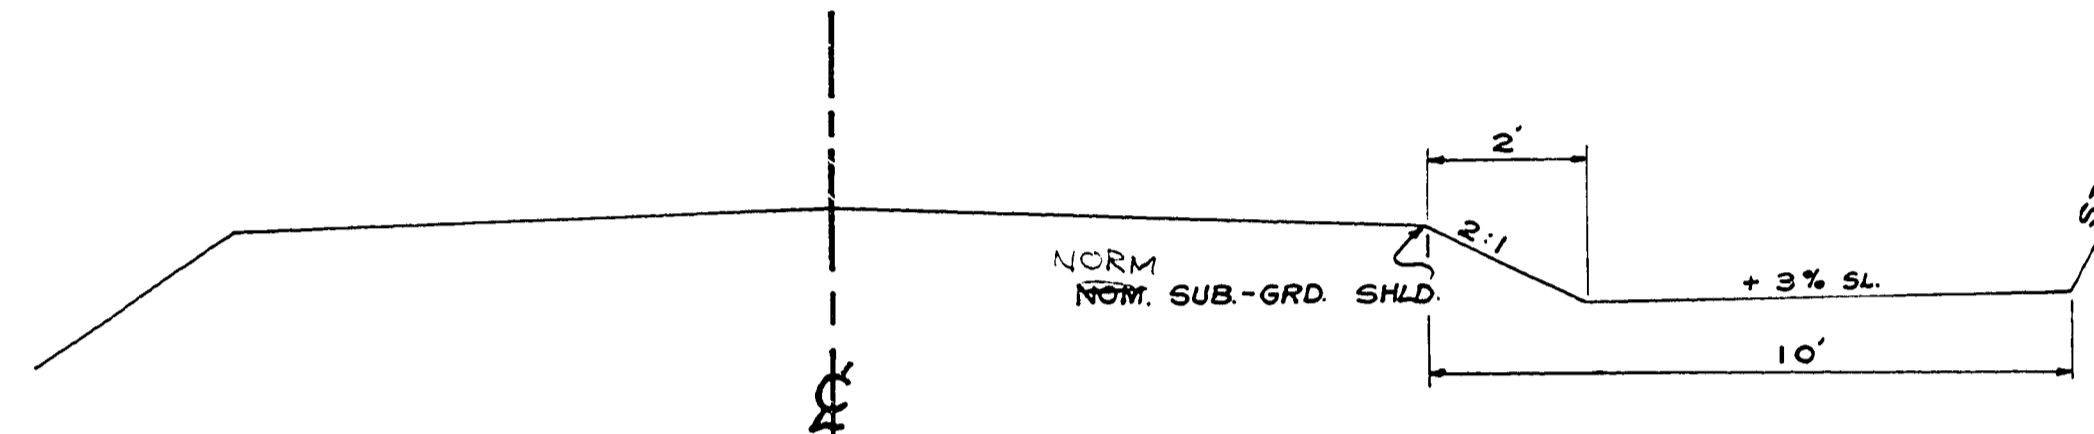


TYPICAL FALL OUT SECTION
STA. 171+50 - 186+00
STA. 281+00 - 313+00

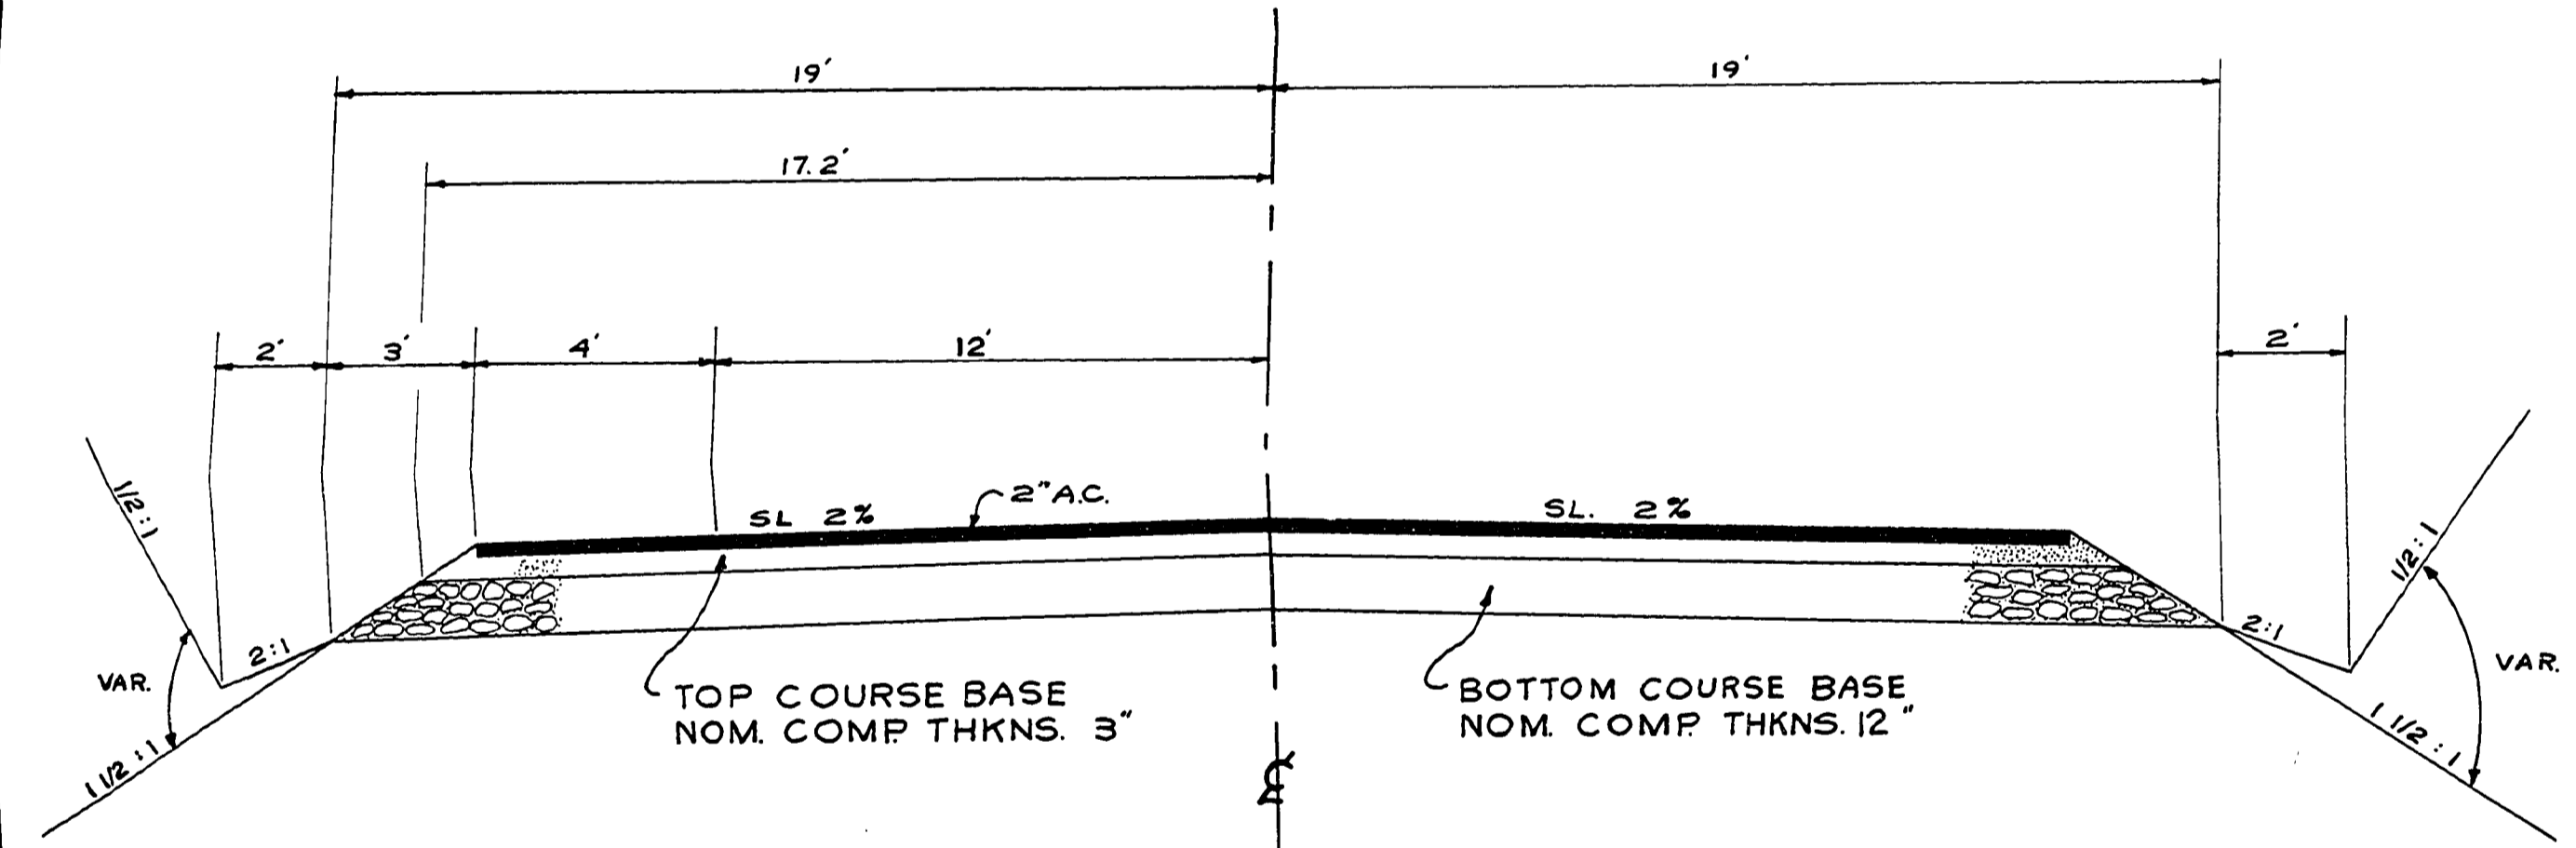


TYPICAL SECTION STA. 166+00 - 313+00 LT SIDE
§ STA. 173+00 - 313+00 RT. SIDE

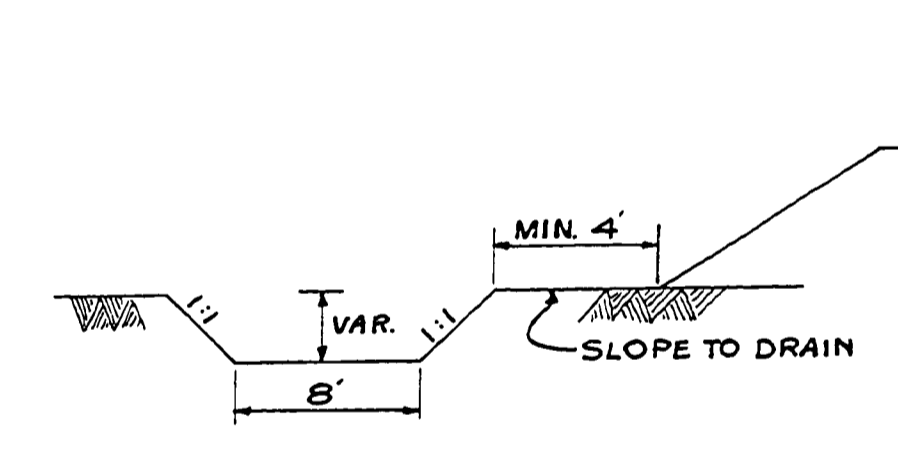

TYPICAL CHANNEL CHANGE
STA. 165+00 - 175+00

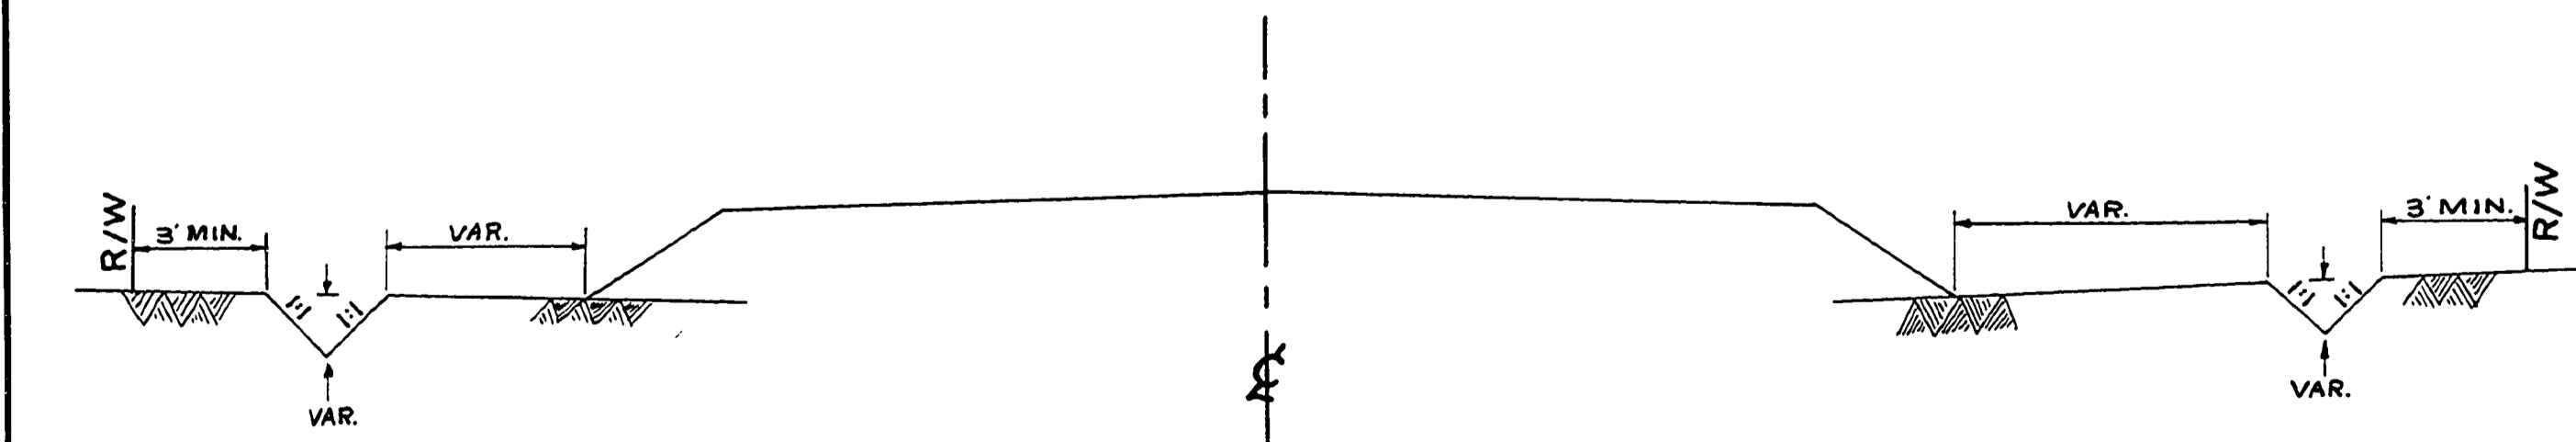

TYPICAL CUT OFF DITCH SECTION

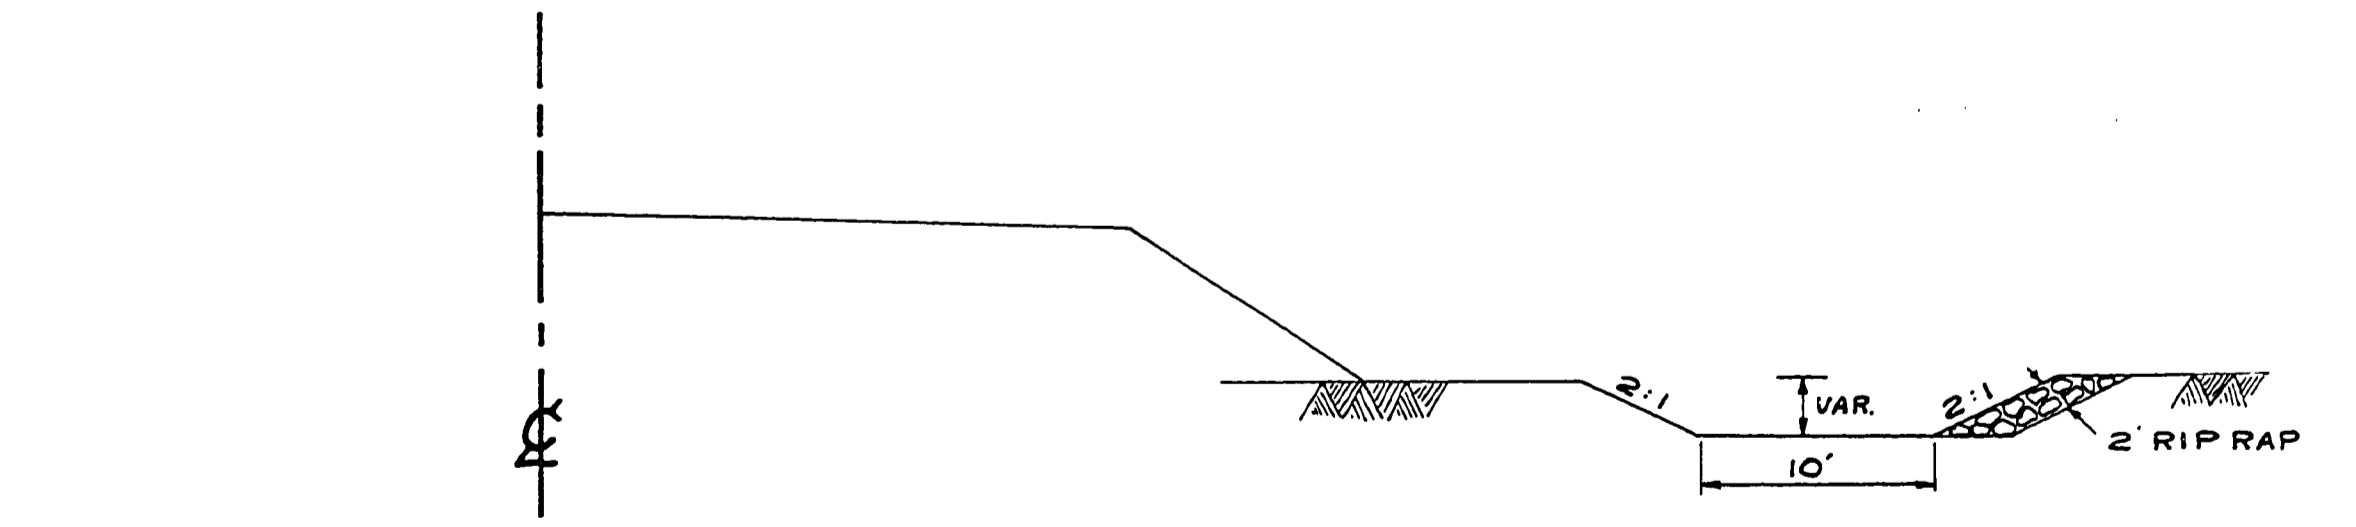

TYPICAL CHANNEL CHANGE
STA. 224+00 - 228+00

NOT REISED
AS CONSTRUCTED

DOUGLAS COUNTY ROAD DEPT.
EDENBOWER MILLWOOD RD. 6
1973 SHT. 3
GEORGE E. GRUBB, COUNTY ENG.

0766TYPL