
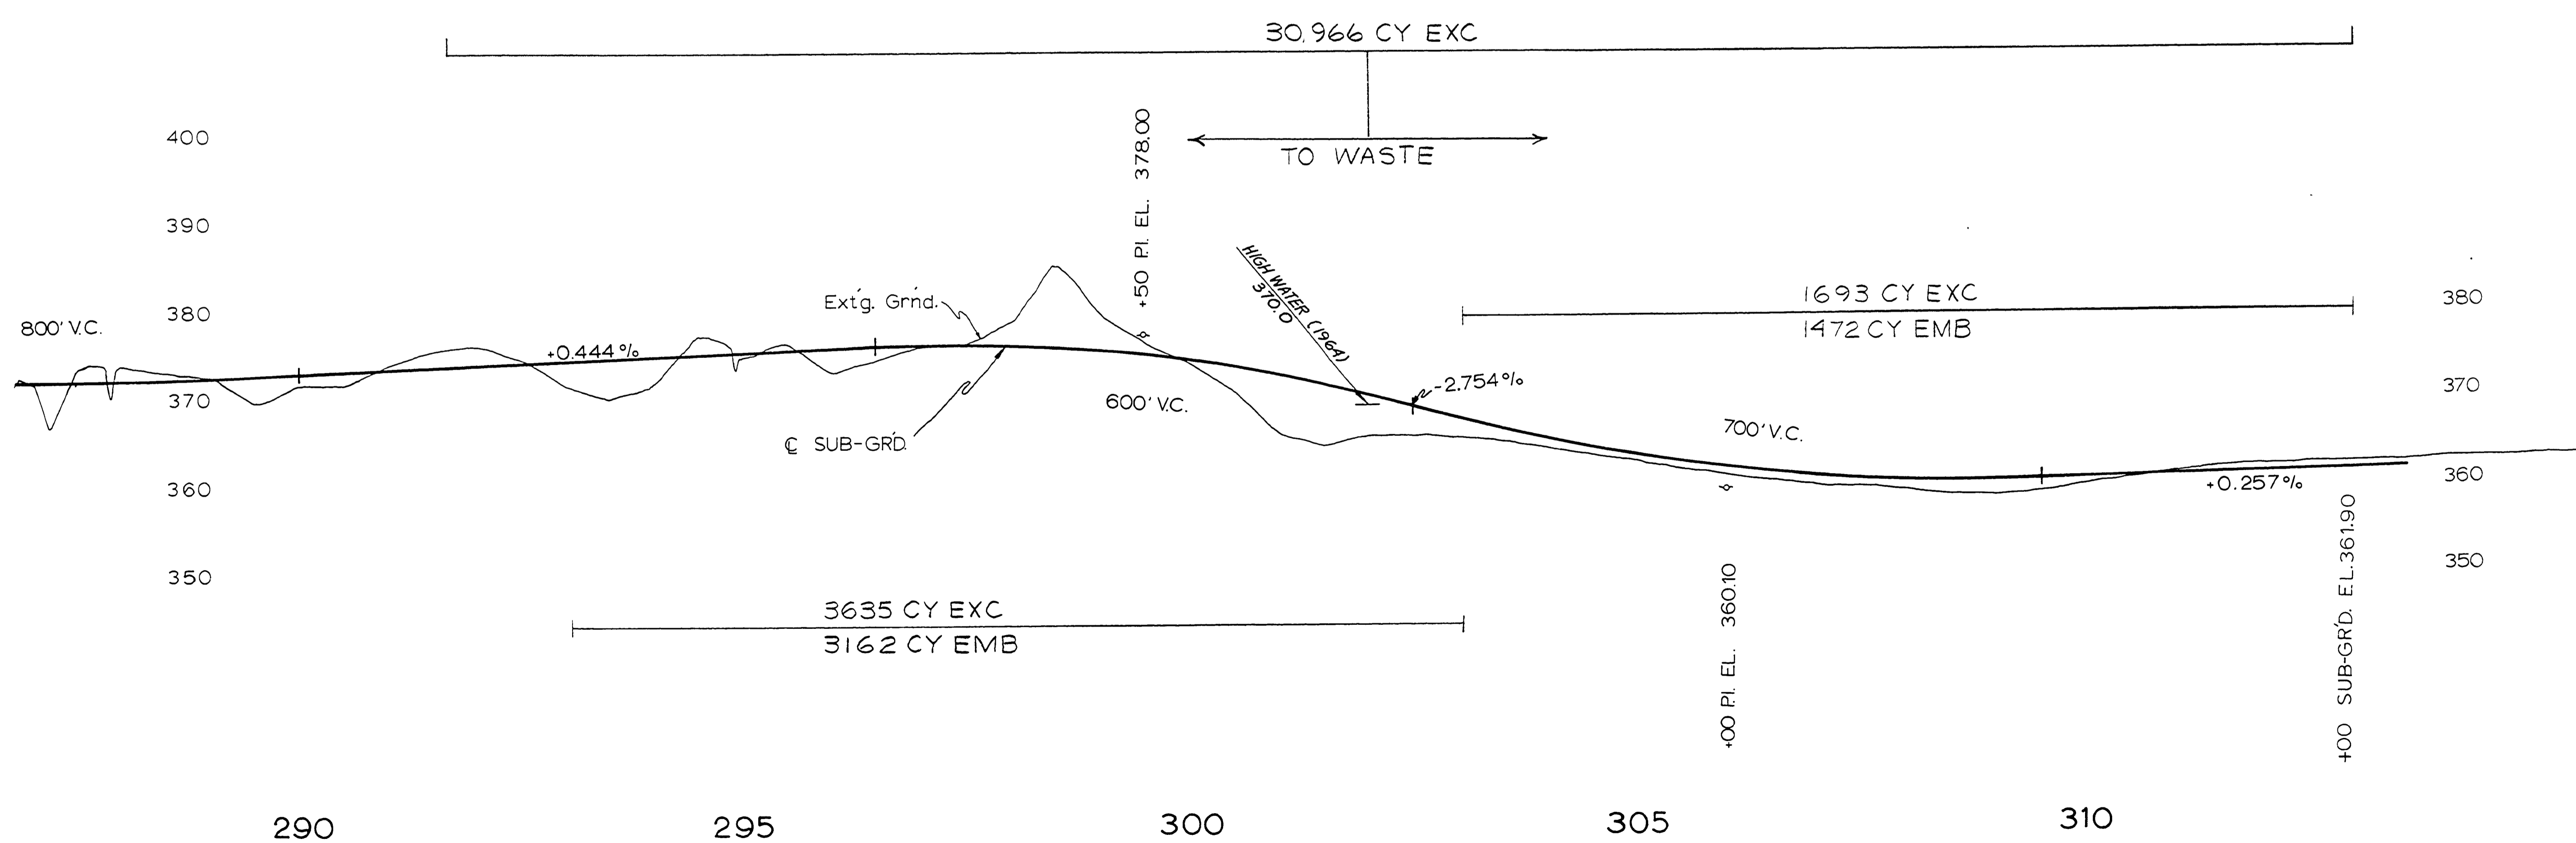


SEC 5&8 T26S R6W WM

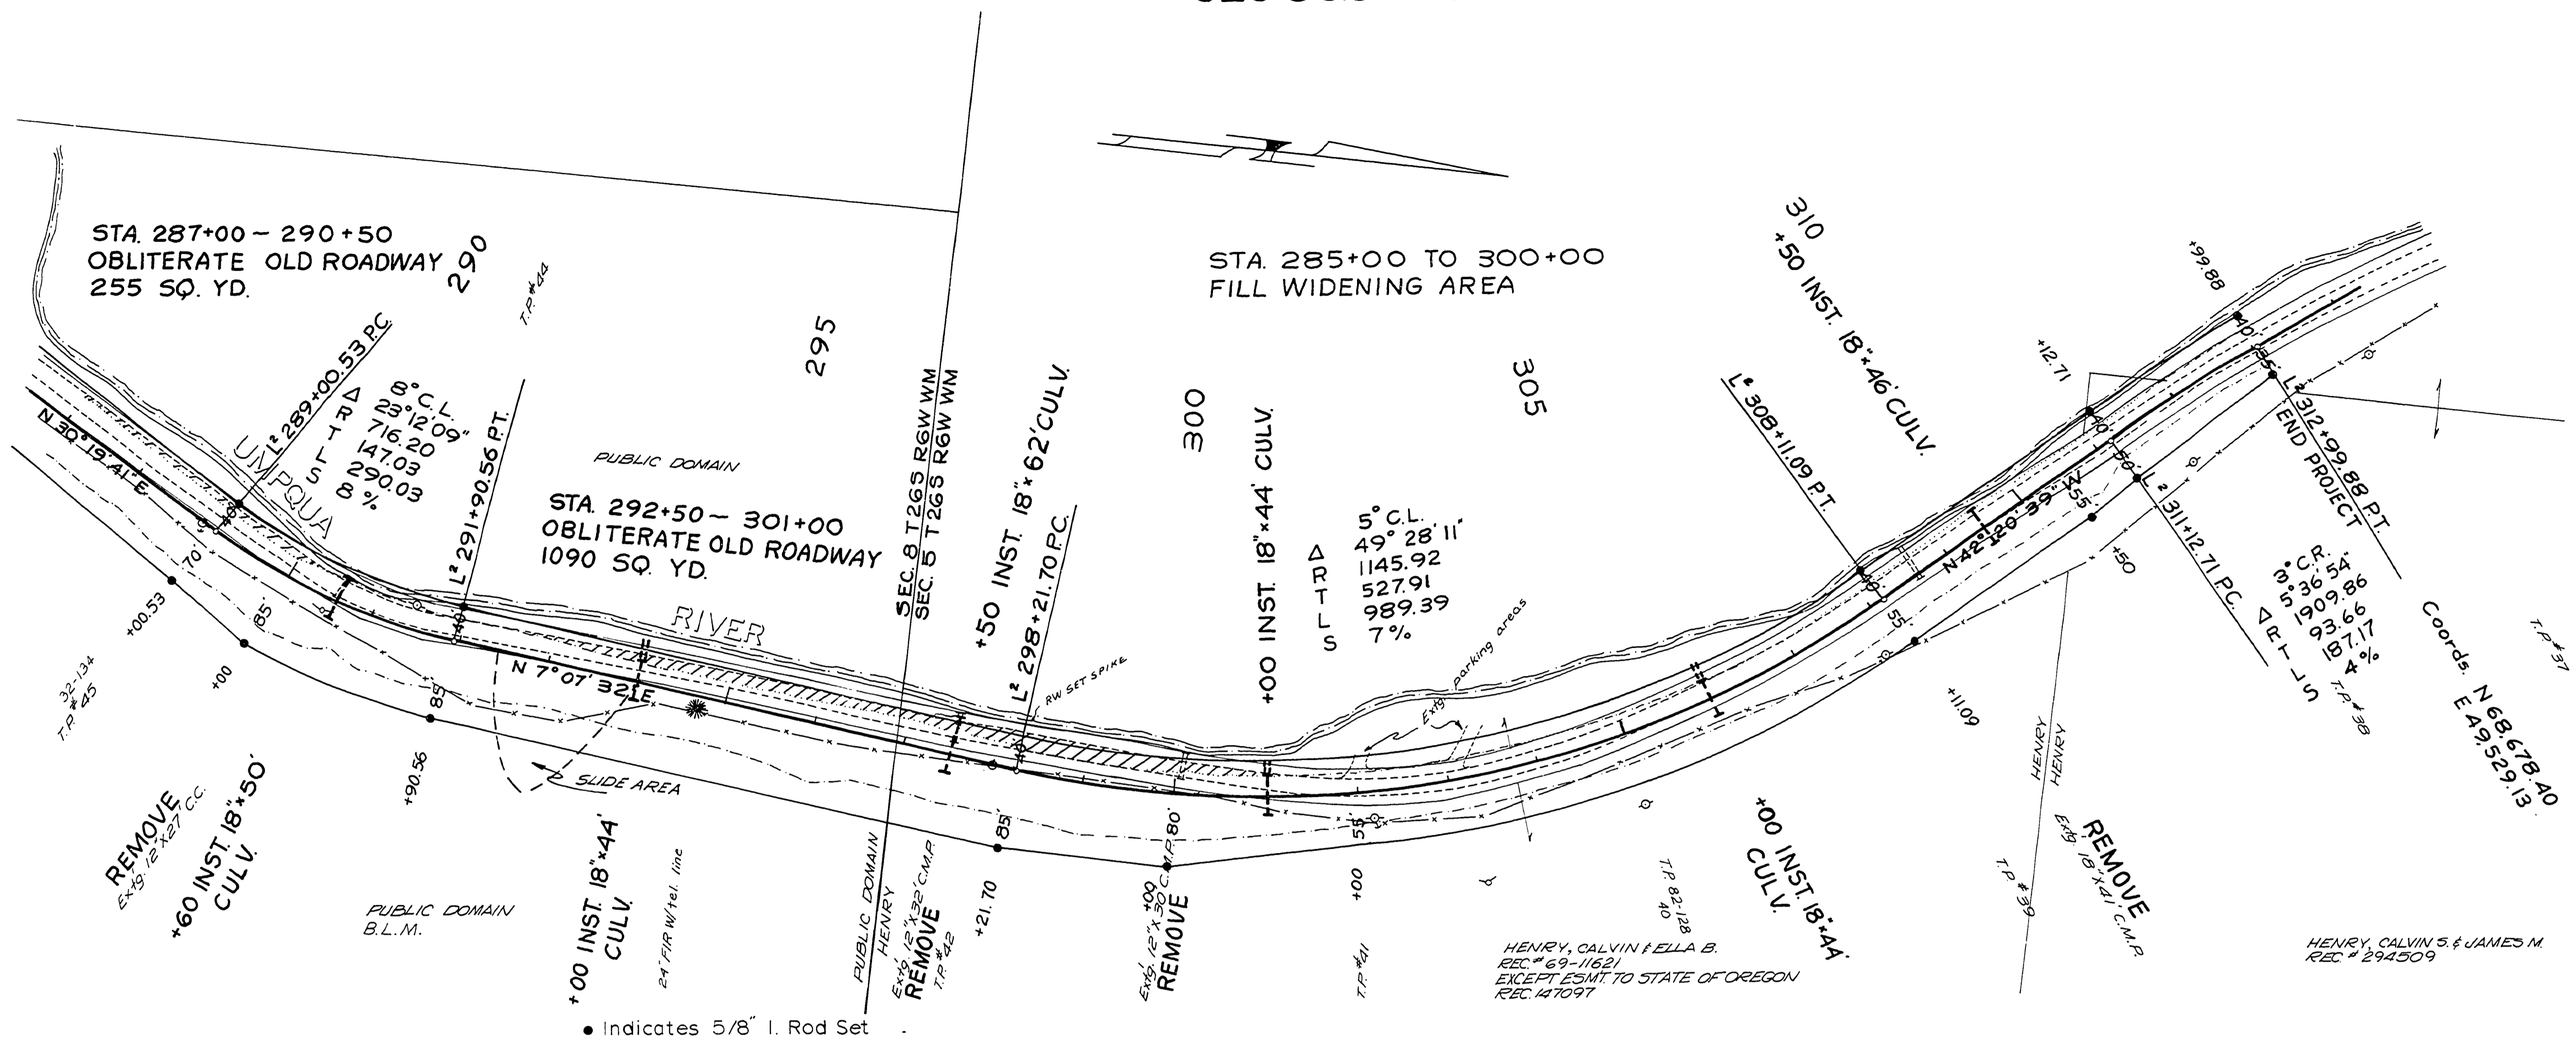

NOT REVISED
AS CONSTRUCTED

DOUGLAS COUNTY ROAD DEPT
EDENBOWER MILLWOOD RD #6
1973 SHT 13
GEORGE E. GRUBB COUNTY ENGR.

11241169