
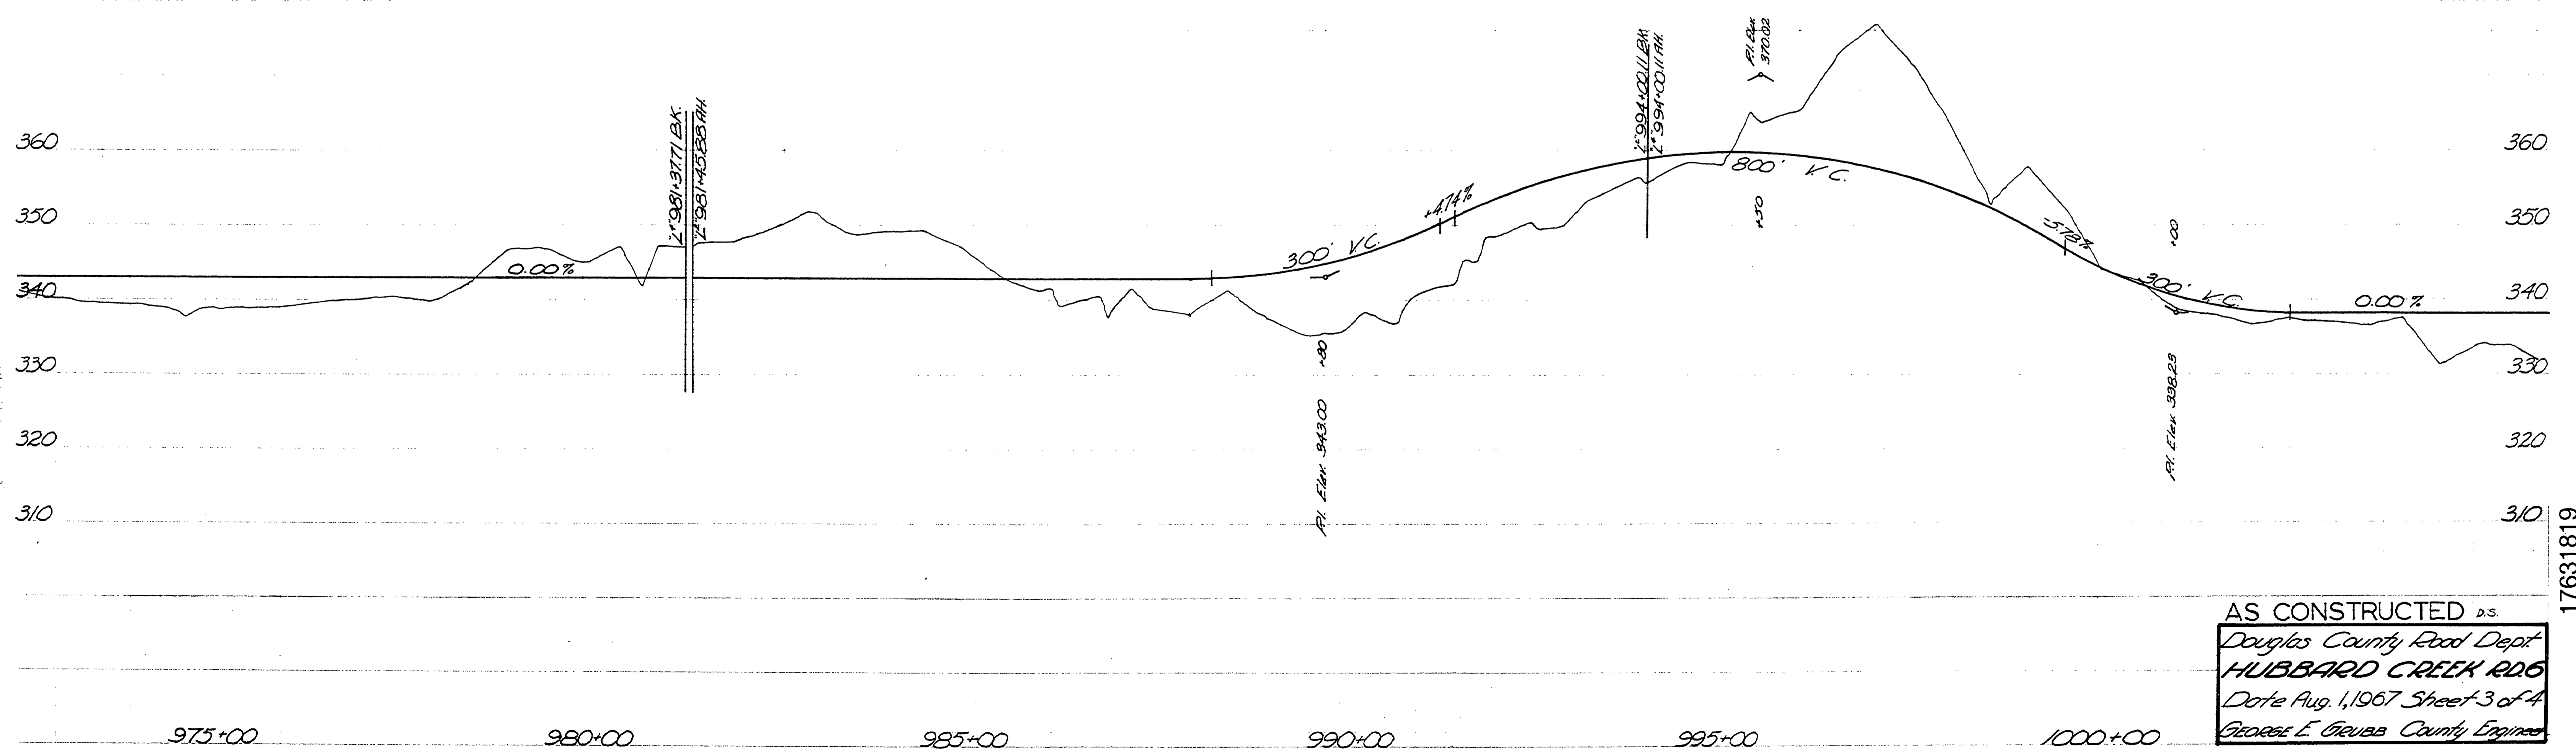


MP18

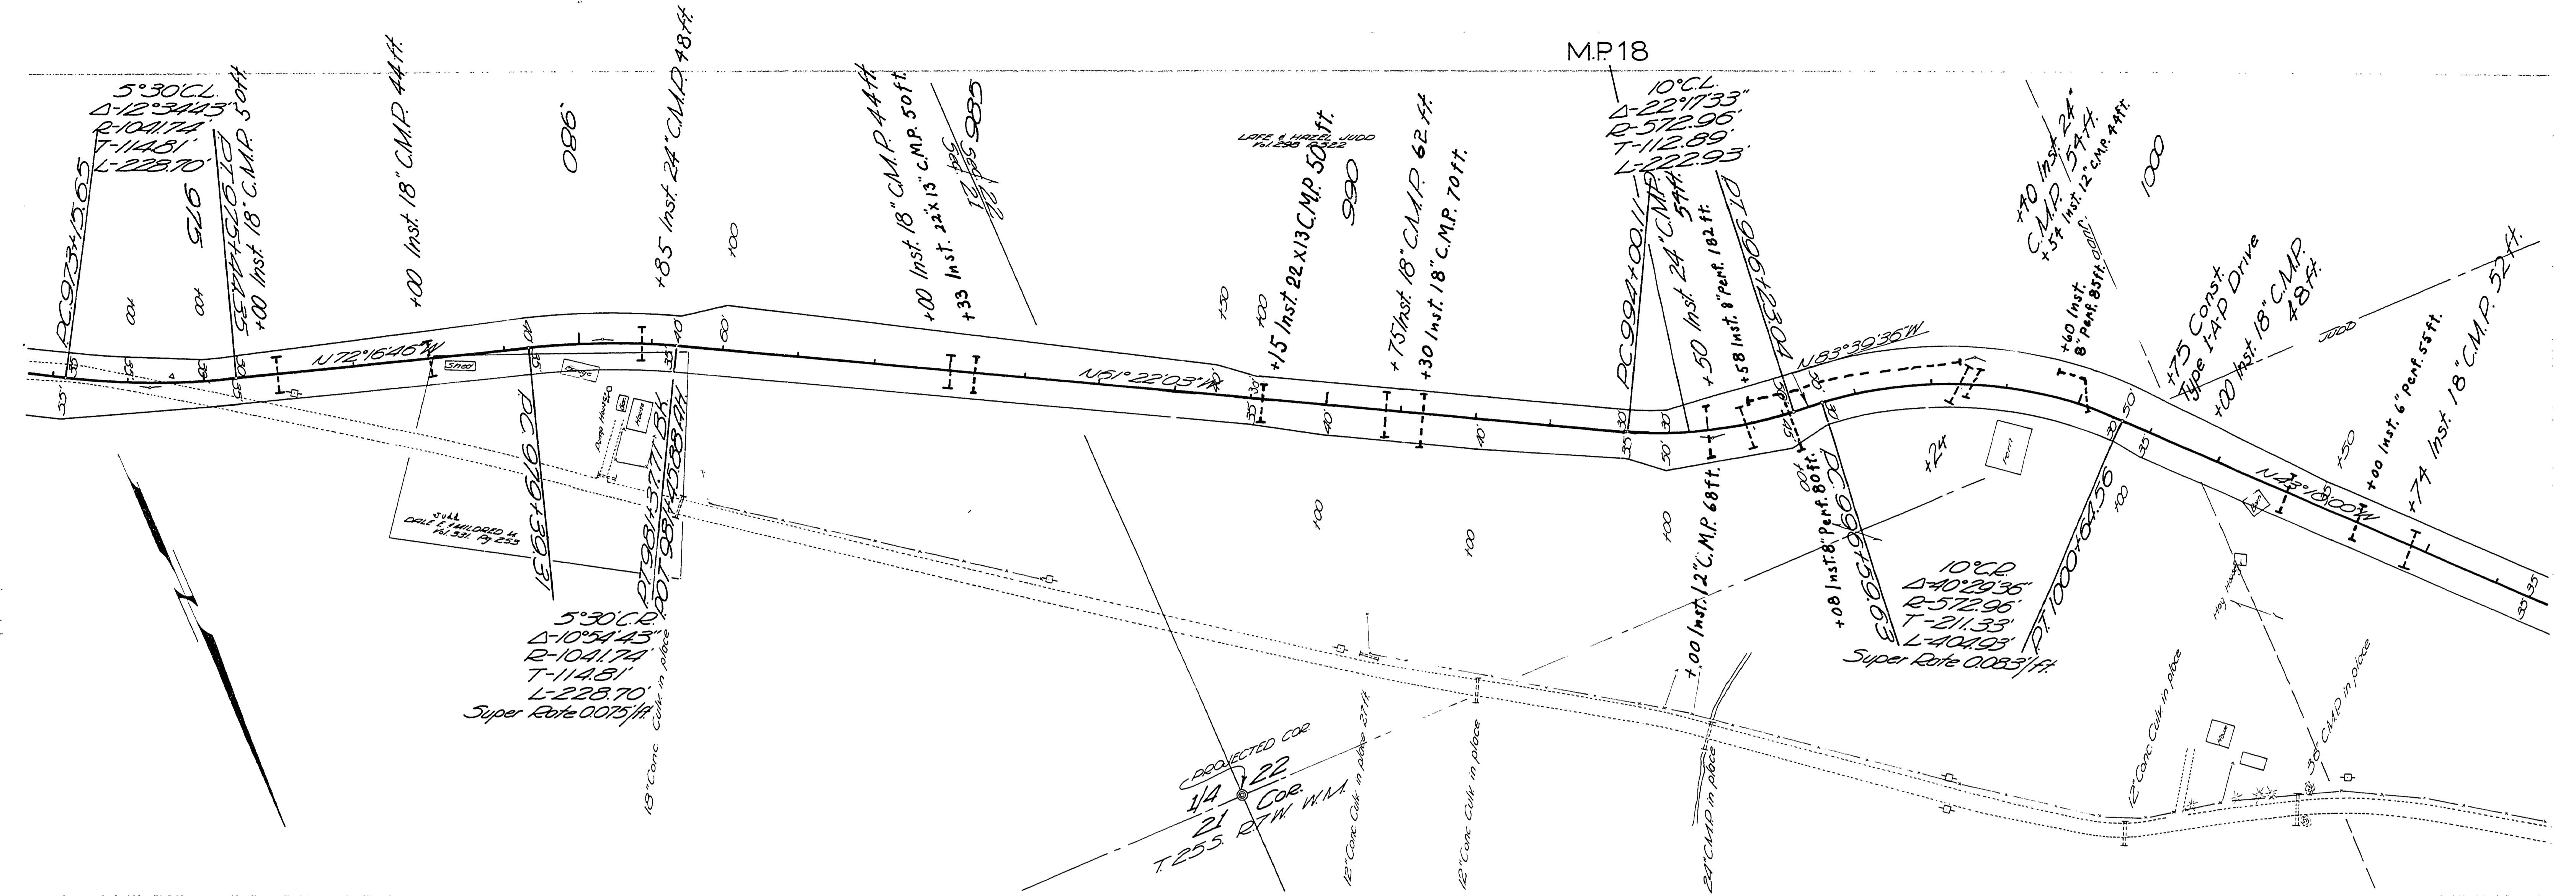

AS CONSTRUCTED D.S.
 Douglas County Road Dept
HUBBARD CREEK RD6
 Date Aug. 1, 1967 Sheet 3 of 4
 George E. Greubb County Engineer