



SEC. 21 T255 RTW W/M

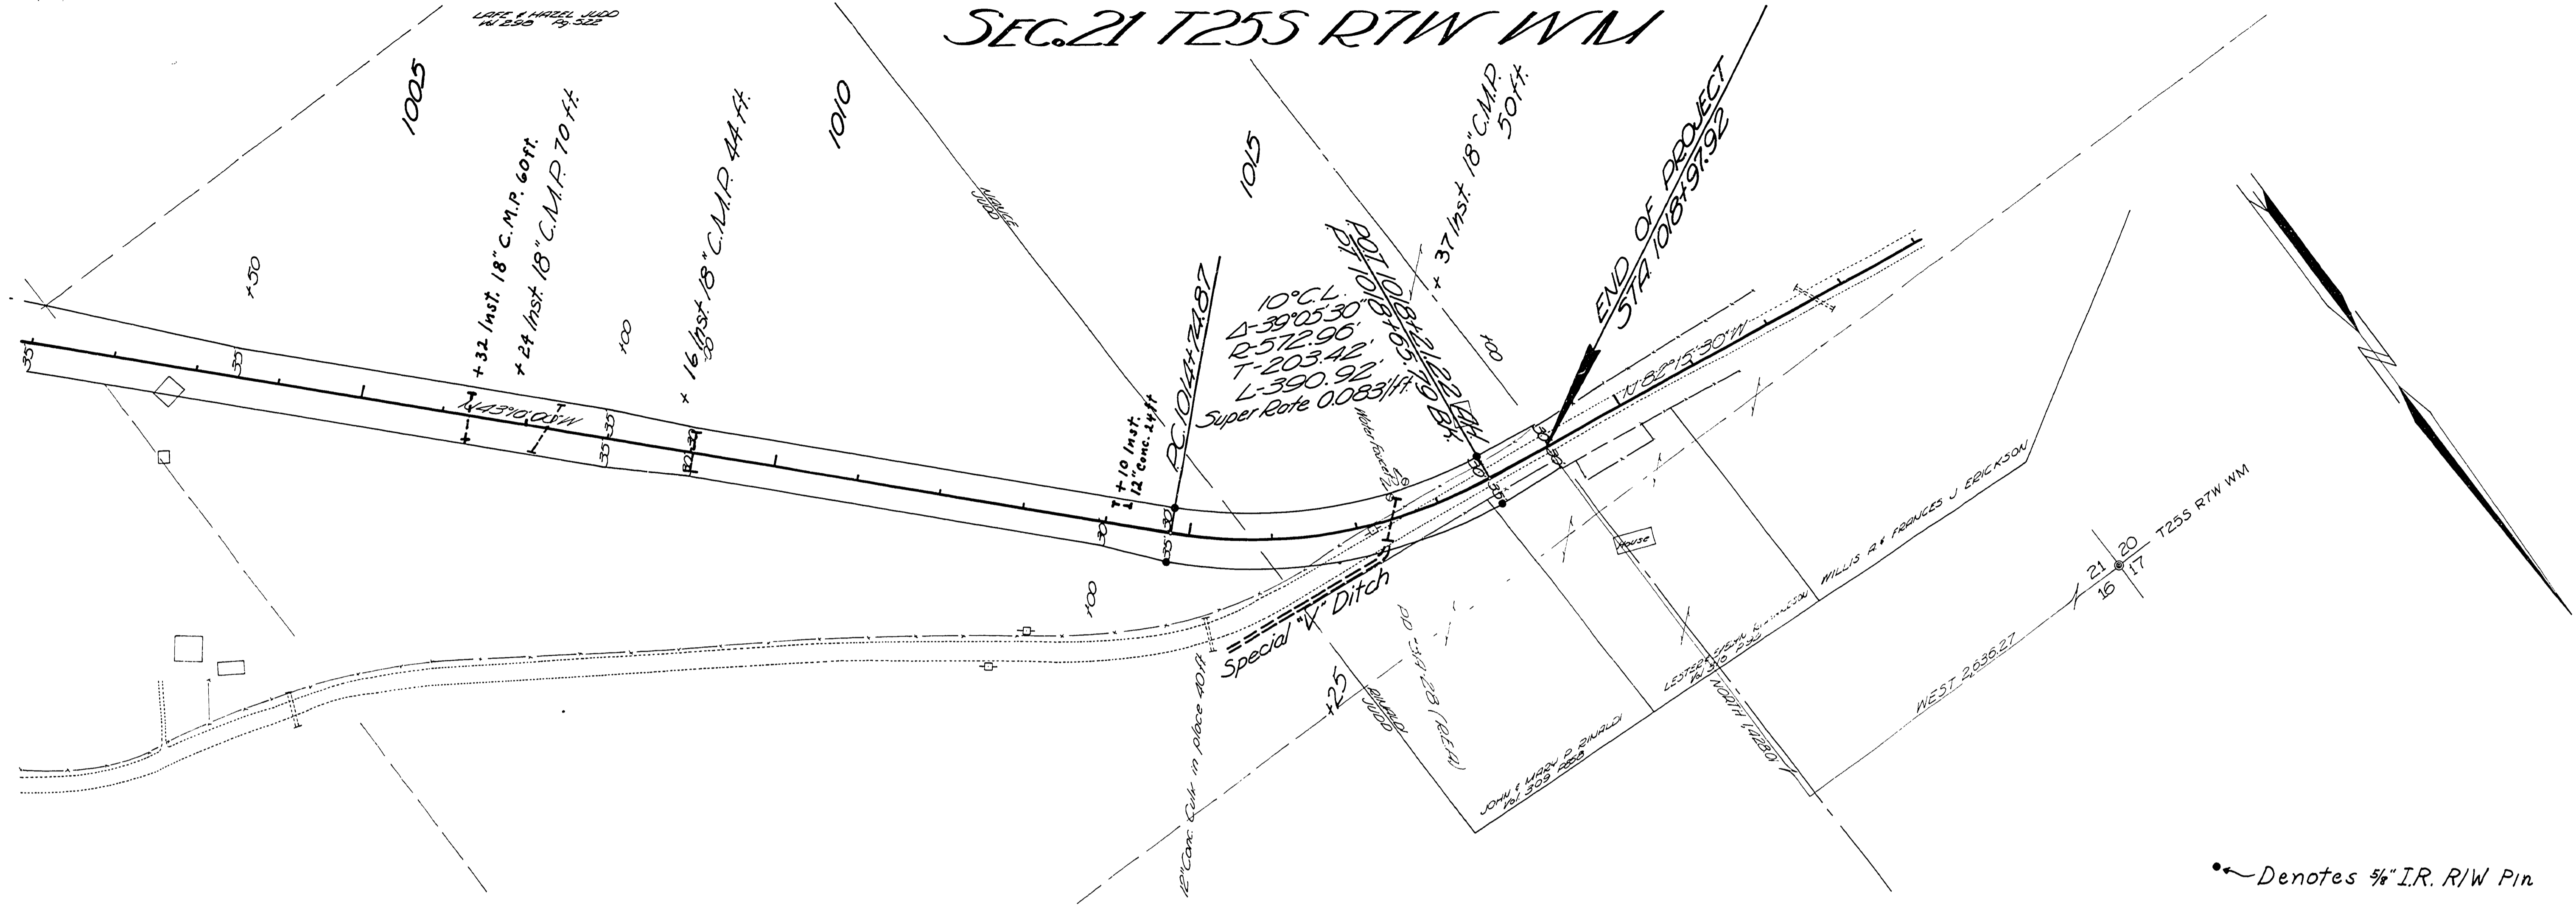

• Denotes 5/8" I.R. R/W Pin

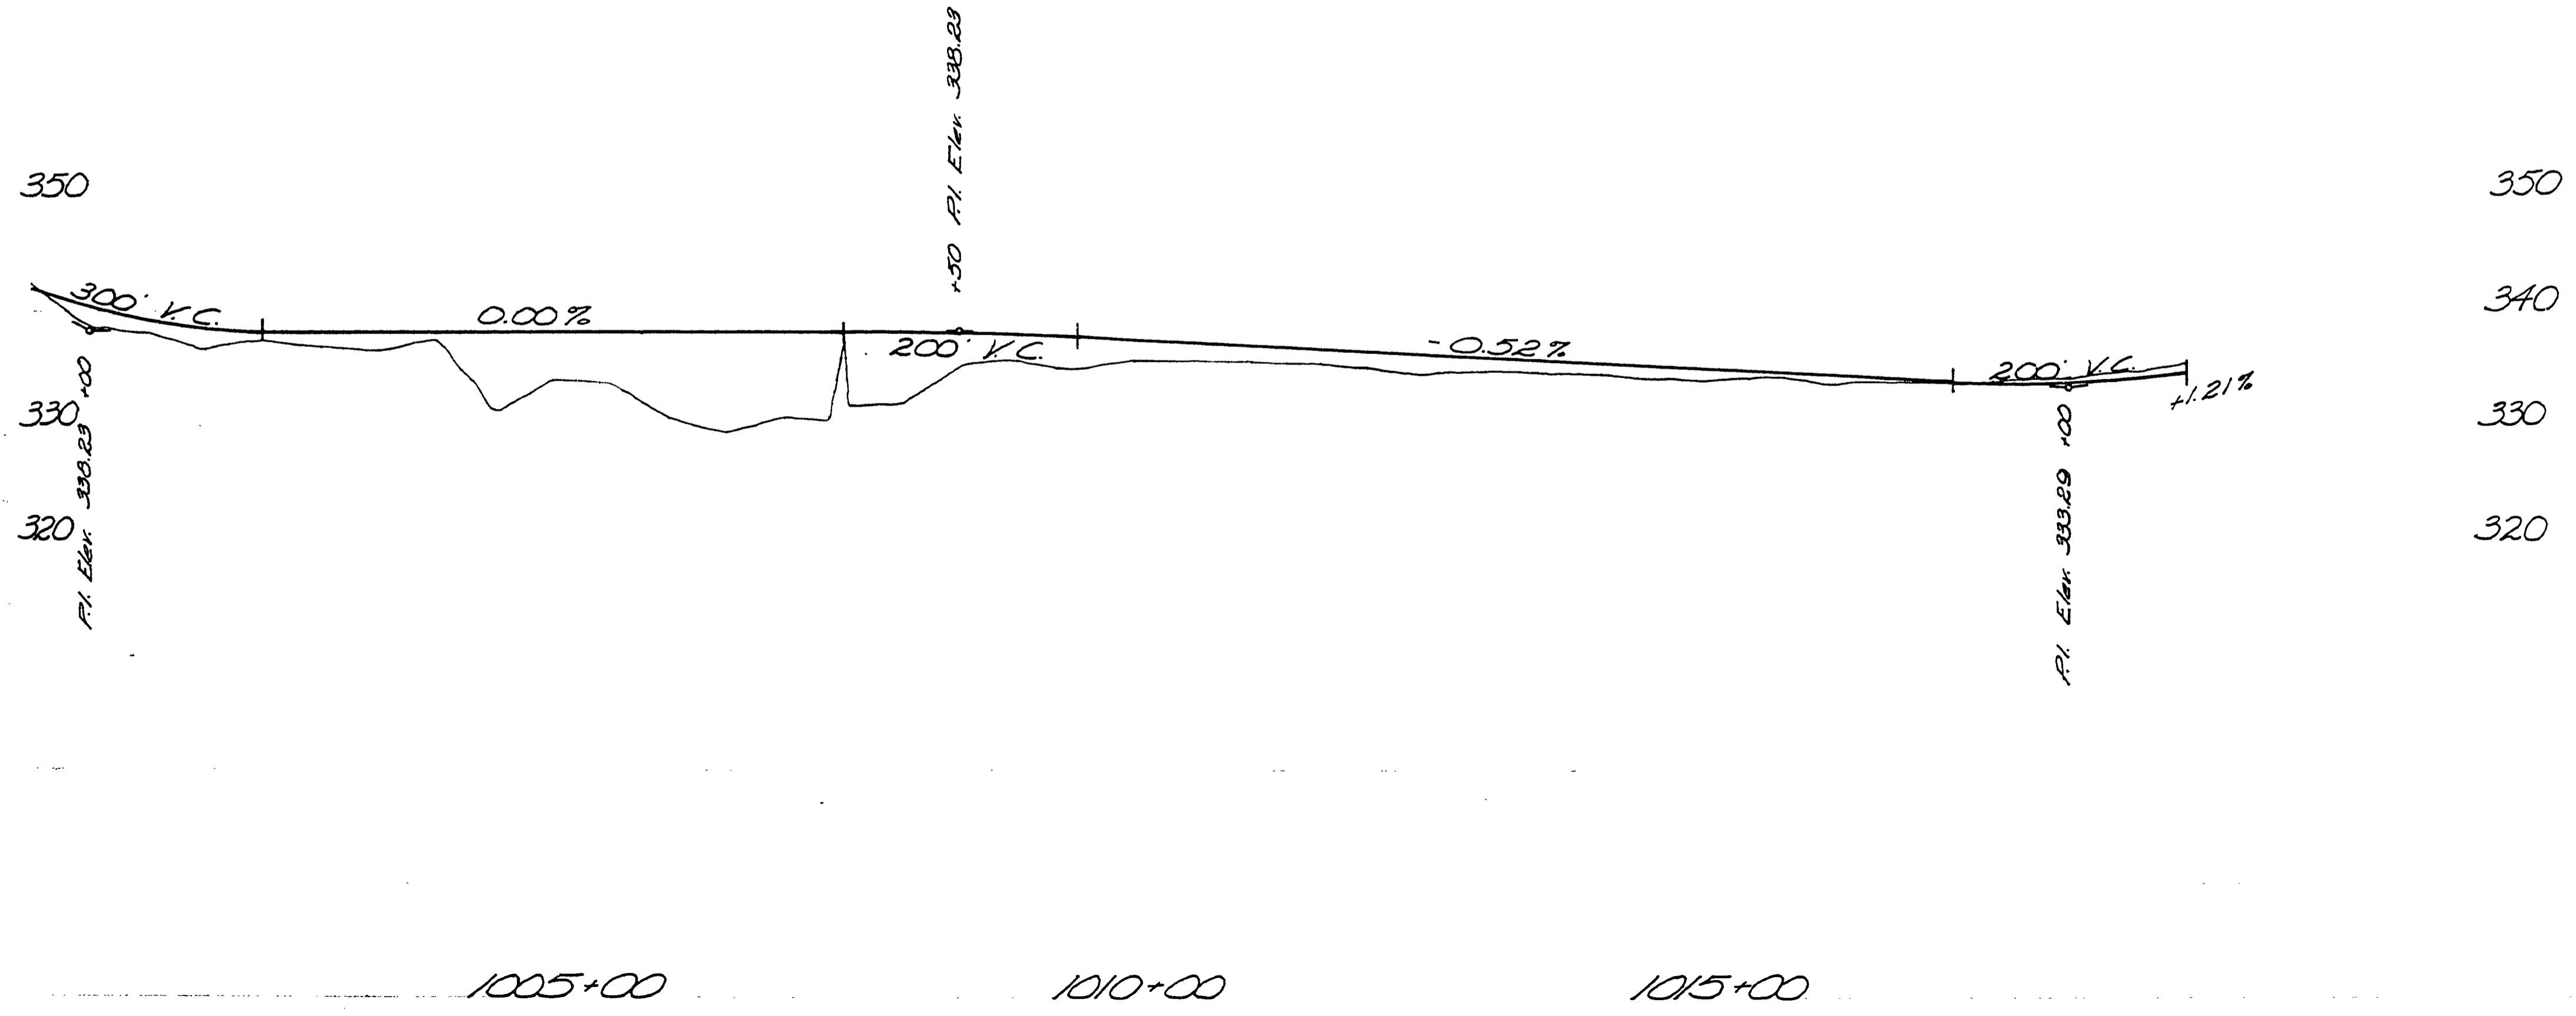

AS CONSTRUCTED D.S.  
 Douglas County Road Dept.  
 HUBBARD CREEK RD'S  
 Date Aug. 1, 1967 Sheet 4 of 4  
 George E. Greub County Engineer