



SECTION 12, TWP. 27S., RANGE 6 W.W.M.
SECTION 13, TWP. 27S., RANGE 6 W.W.M.

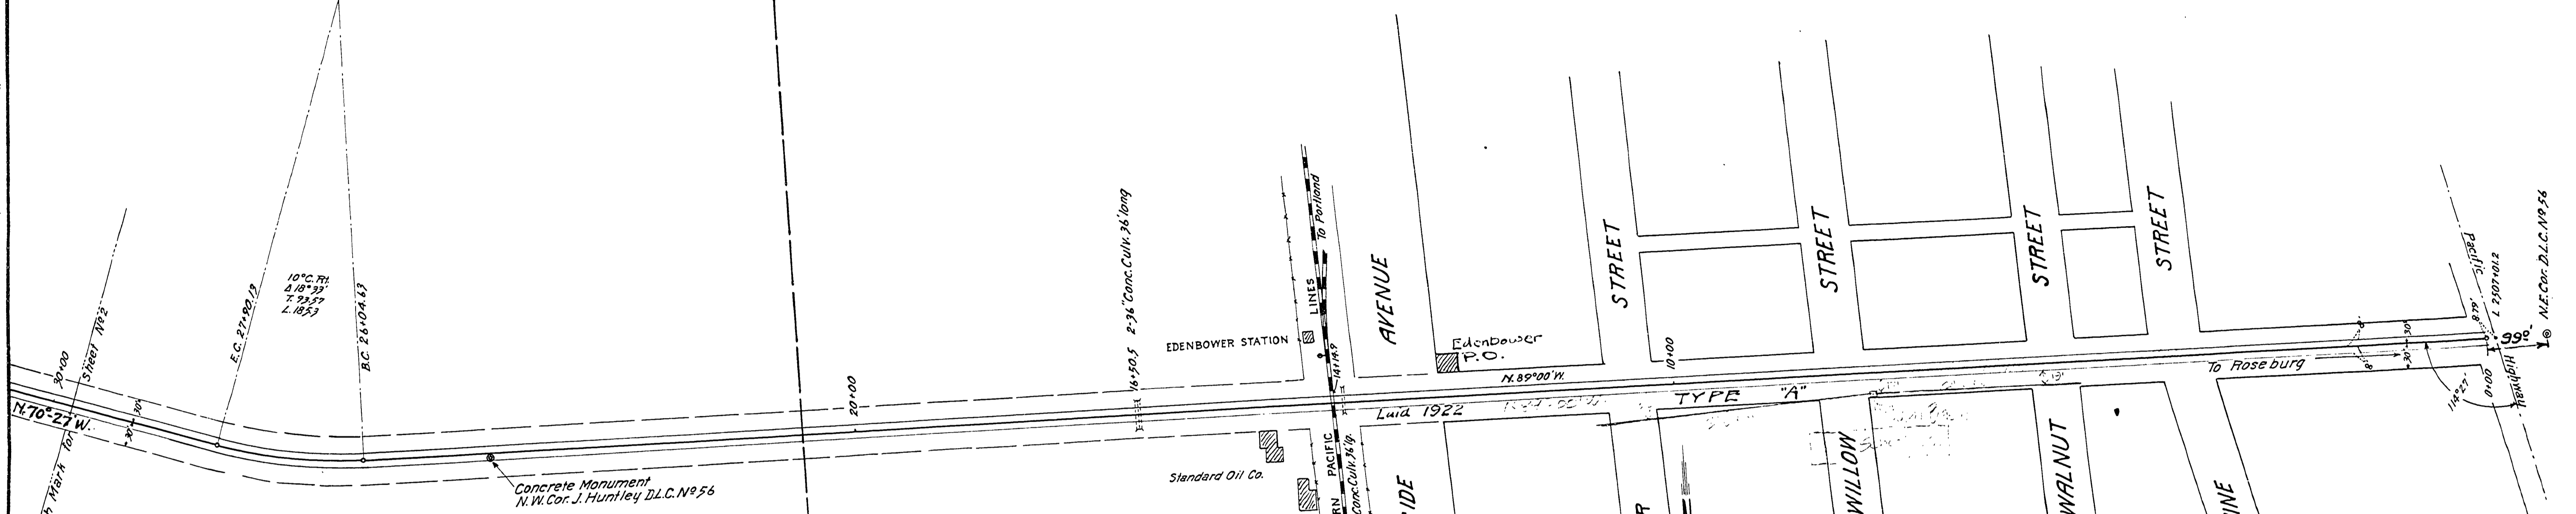

**DOUGLAS COUNTY HIGHWAY
IMPROVEMENT
PROFILE AND ALIGNMENT
EDENBOWER - UMPQUA ROAD
EDENBOWER PAVEMENT SECTION
SHEET No 1**

STA. 0+00 TO STA. 69+29.4
OFFICE OF
F.C. FREAR
COUNTY ROADMASTER
SCALE: HOR. 1"=100' VERTICAL 1"=10'

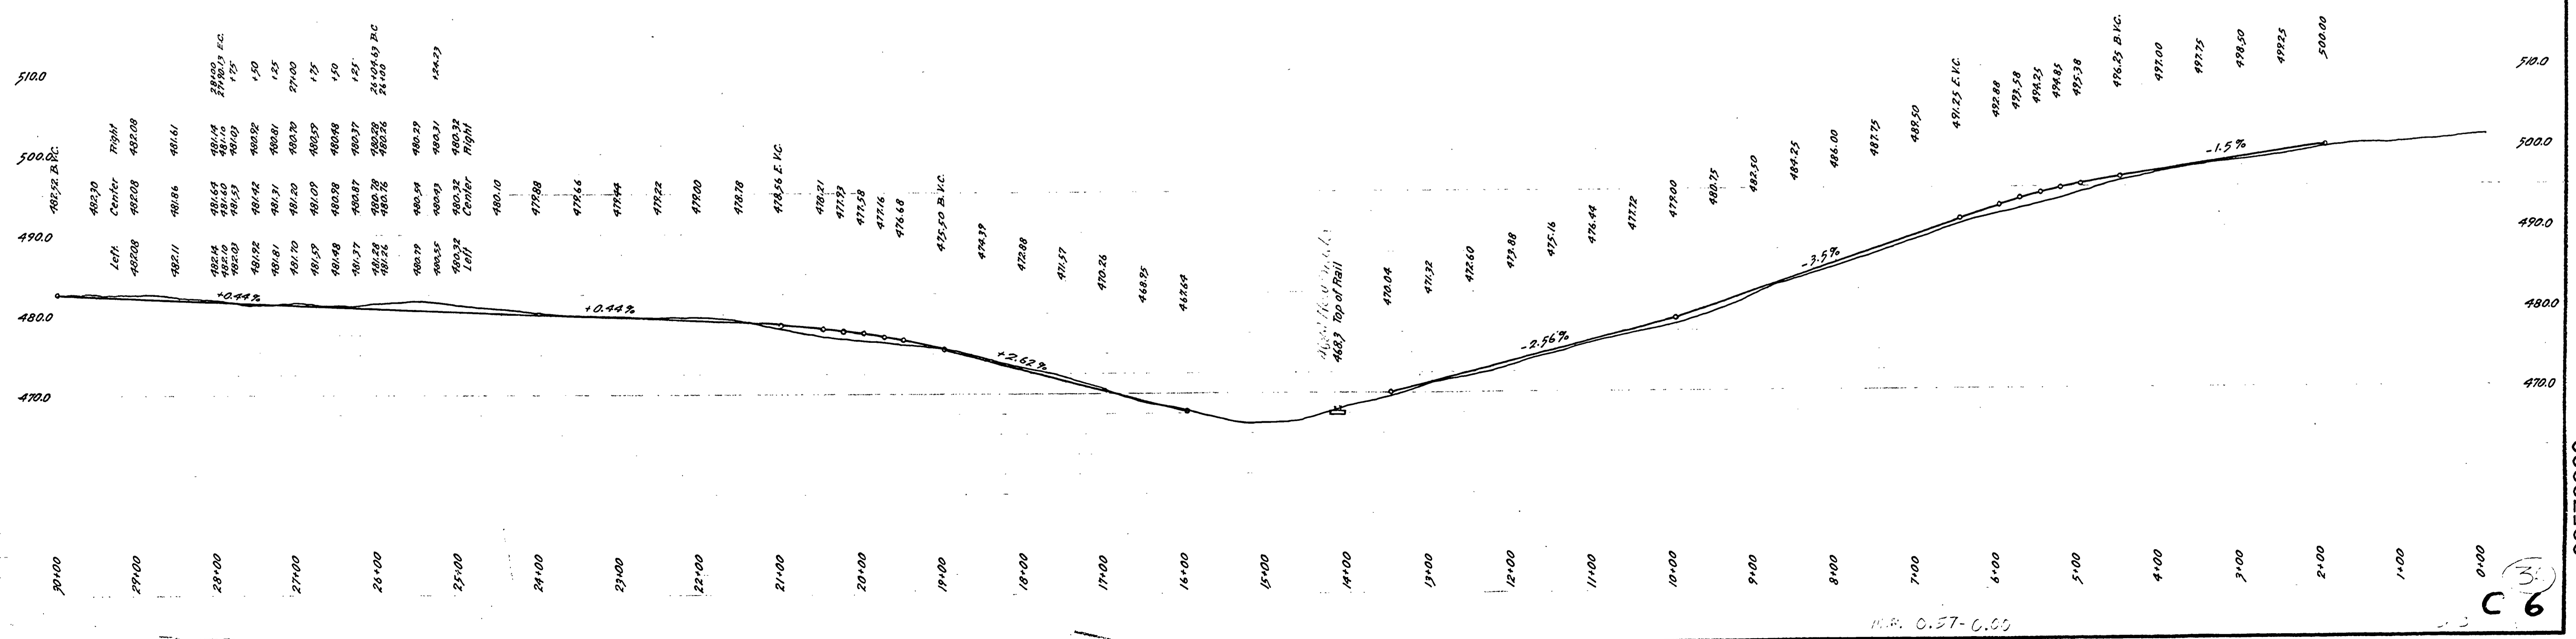

00570000

M.R. 0-27-0-00

6