
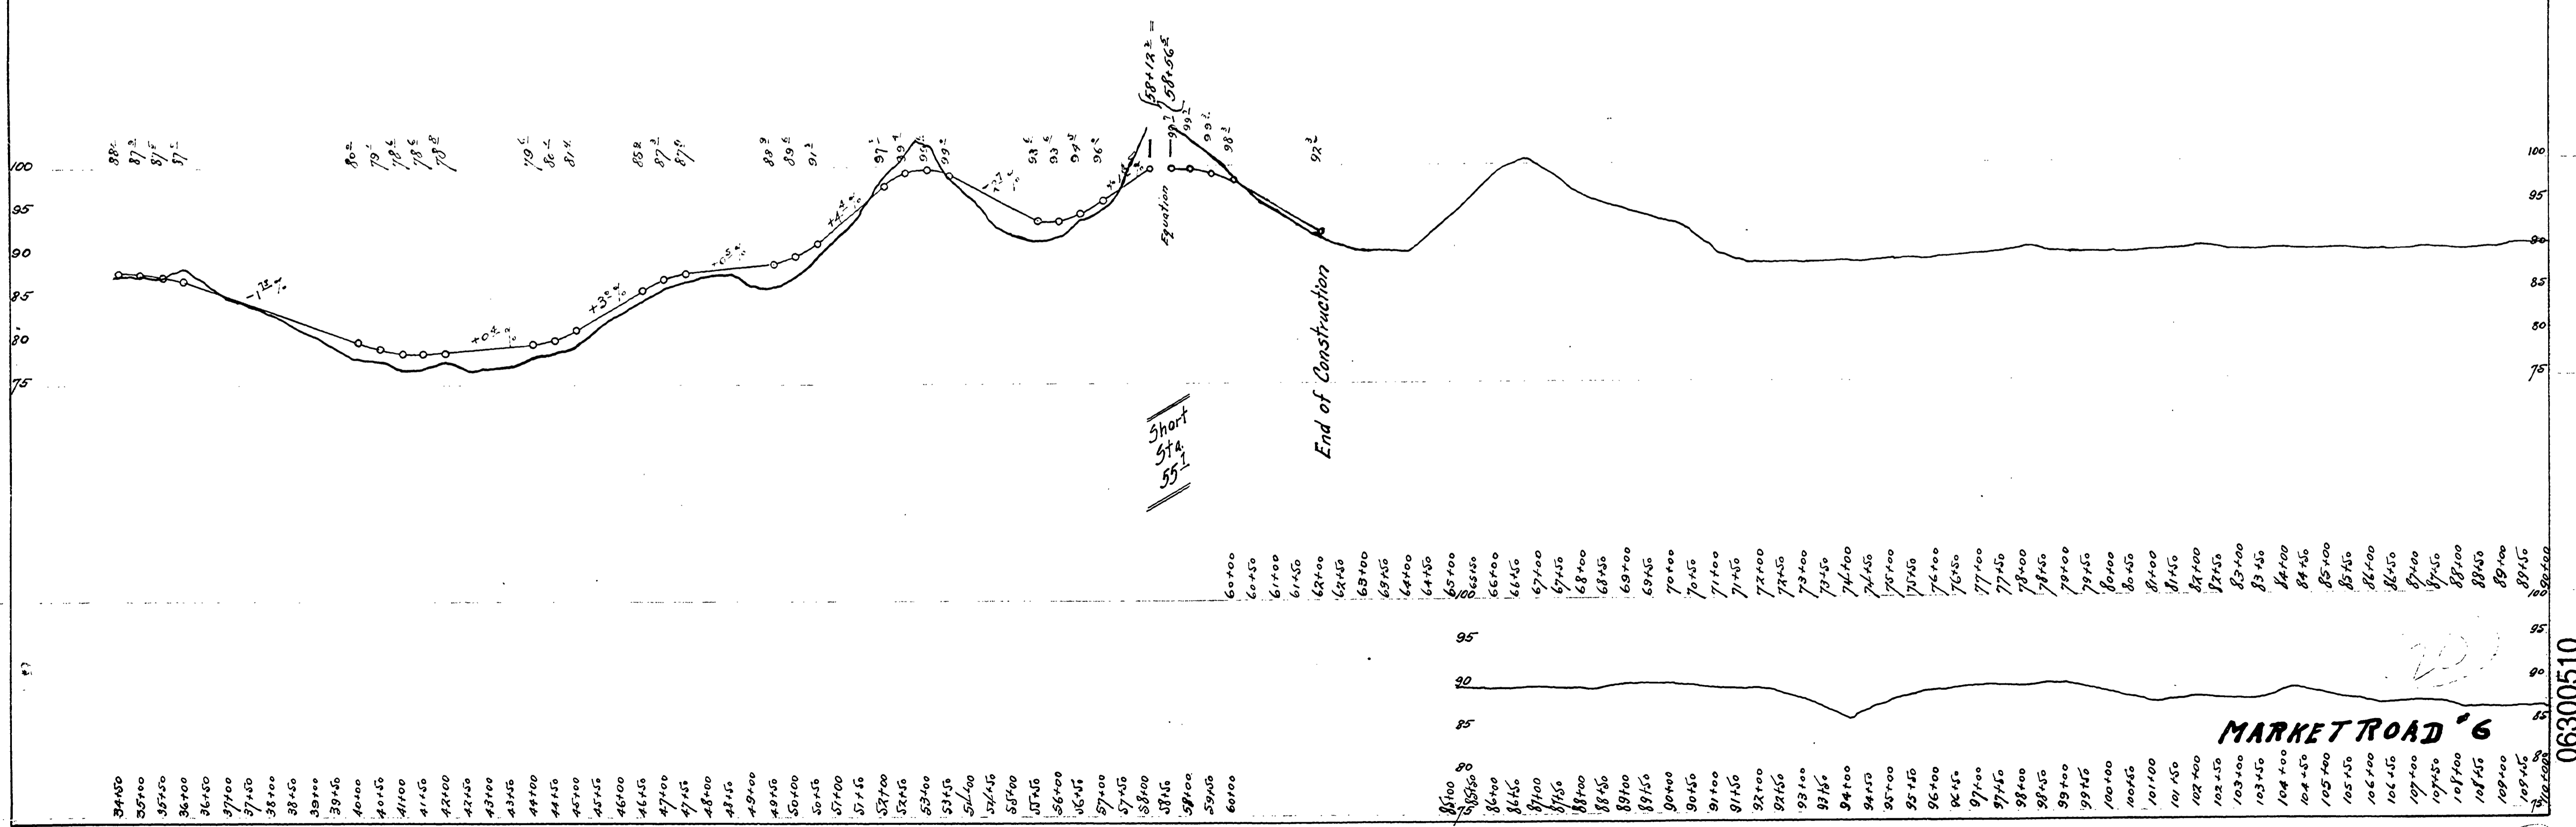
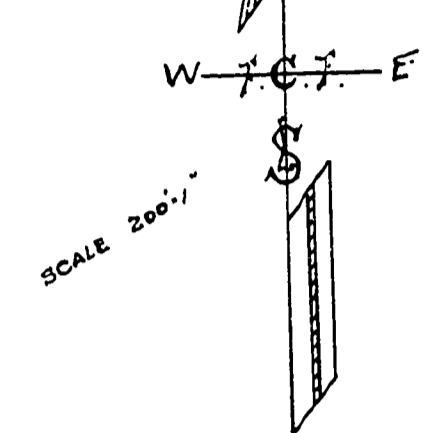


DOUGLAS COUNTY HIGHWAY IMPROVEMENT

PROFILE AND ALIGNMENT EDENBOWER-MILLWOOD ROAD

GARDEN VALLEY SEC.
 IN SECTIONS 29-32-33-Twp 26 5R 6 W.M.
 STA 34+50 to STA 110+72.1
 F.C. Frear County Surveyor & Roadmaster
JUNE 1920
 Sheet No 2

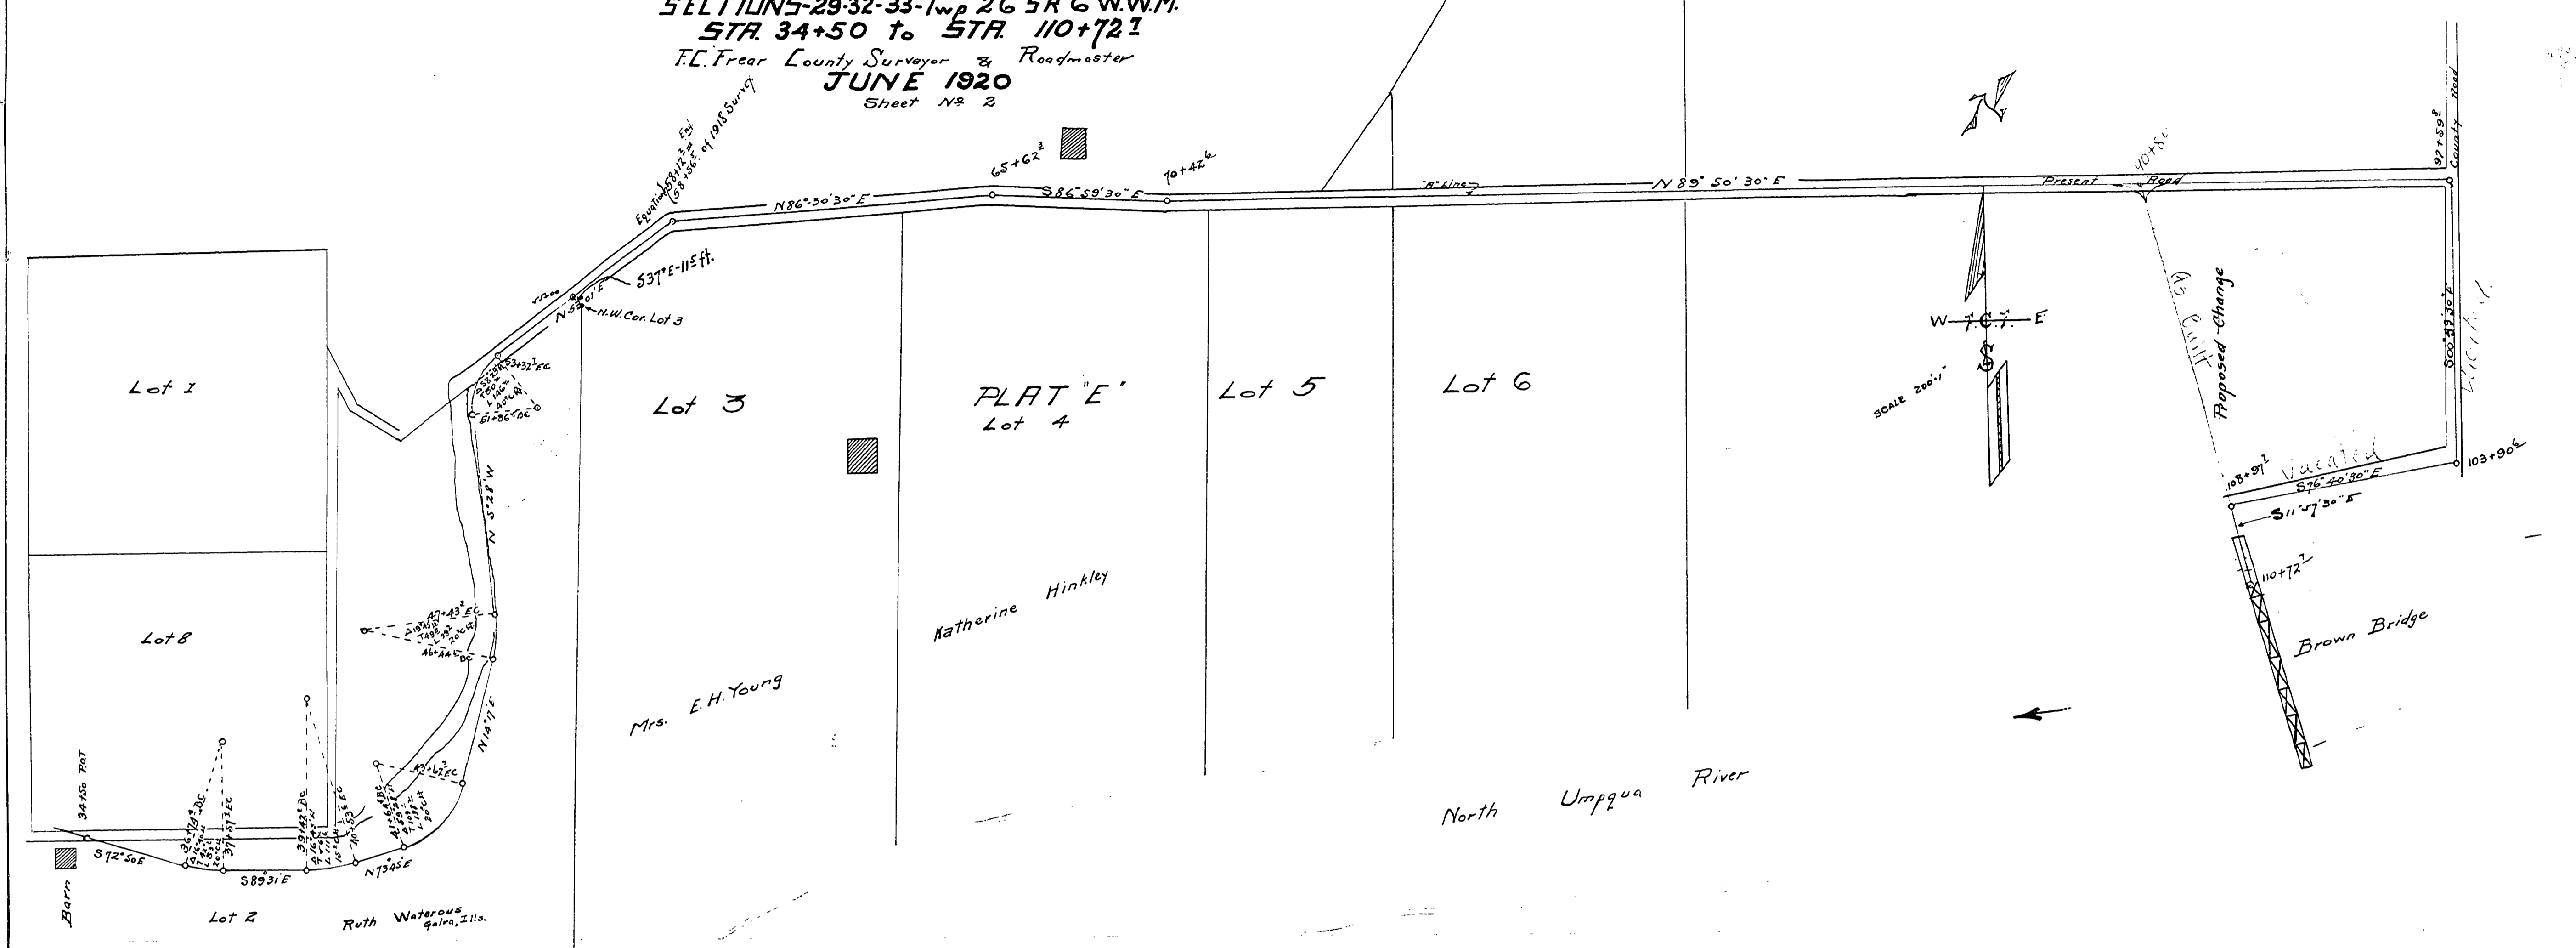

06300510

Rd. No. 6

M.P. 5.30-5.10