
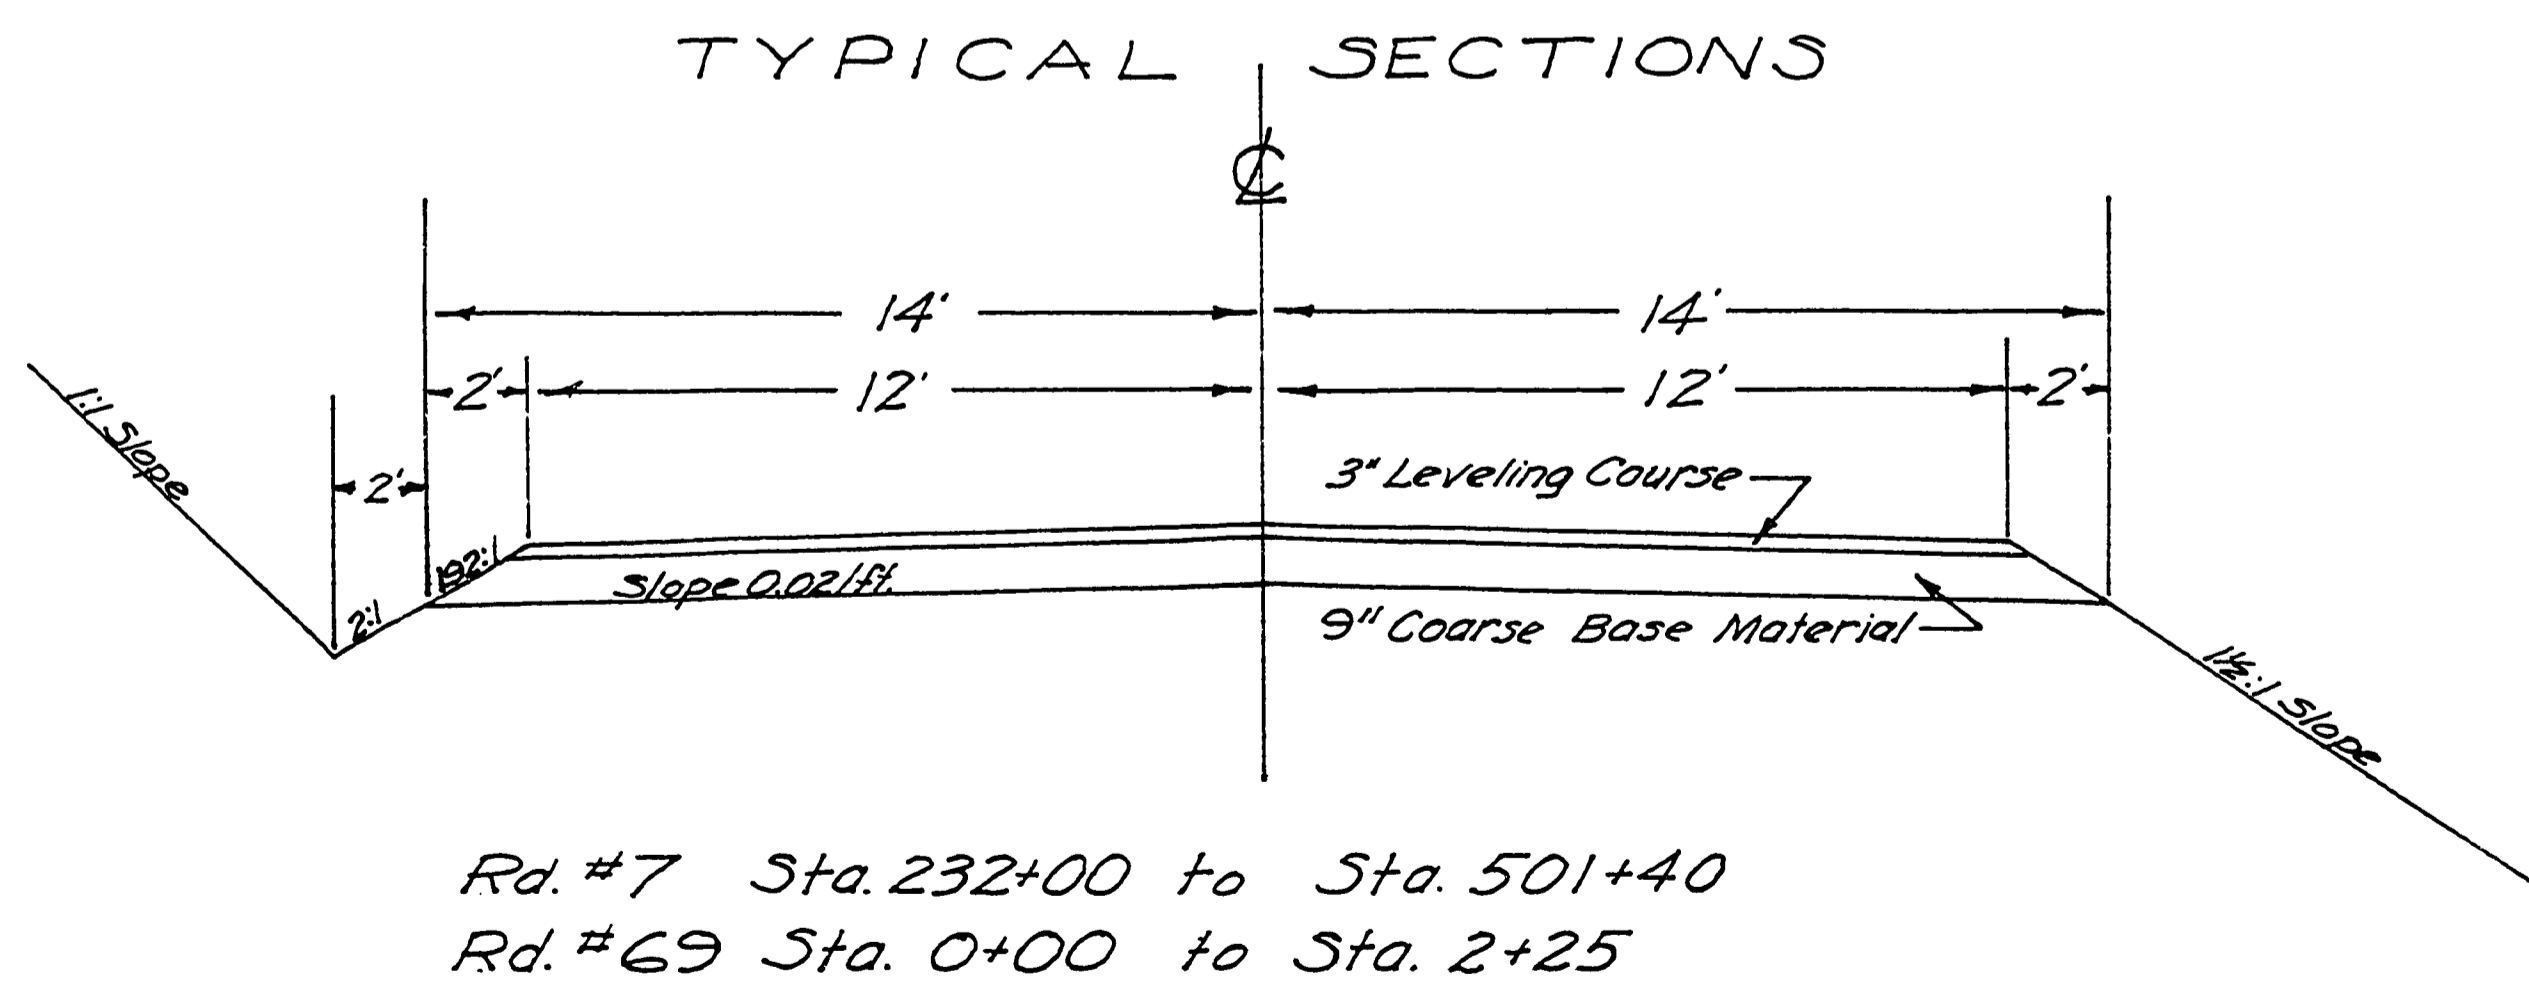


DOUGLAS COUNTY - OREGON
 PLANS FOR PROPOSED PROJECT
 AS CONSTRUCTED
 YONCALLA-ELKHEAD RD. No. 7
 COUNTY ROAD No. 7
 July 1960

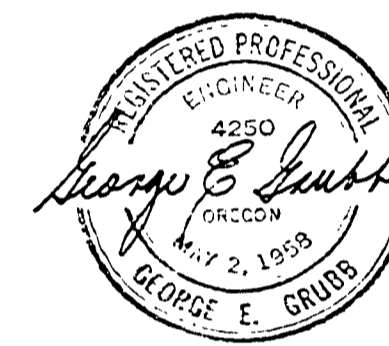

SHEET 1 of 11

L.L.

0473099C

①