


**DOUGLAS COUNTY**  
**OREGON**

**ELKHEAD-LONDON SPRINGS**  
**ROAD**

MARKET ROAD N° 8A

Sec. 35 T22 S R4 W  
 Sec. 2 T23 S R4 W  
 F.C. Frear County Engr  
 1928  
 Sheet N° 3

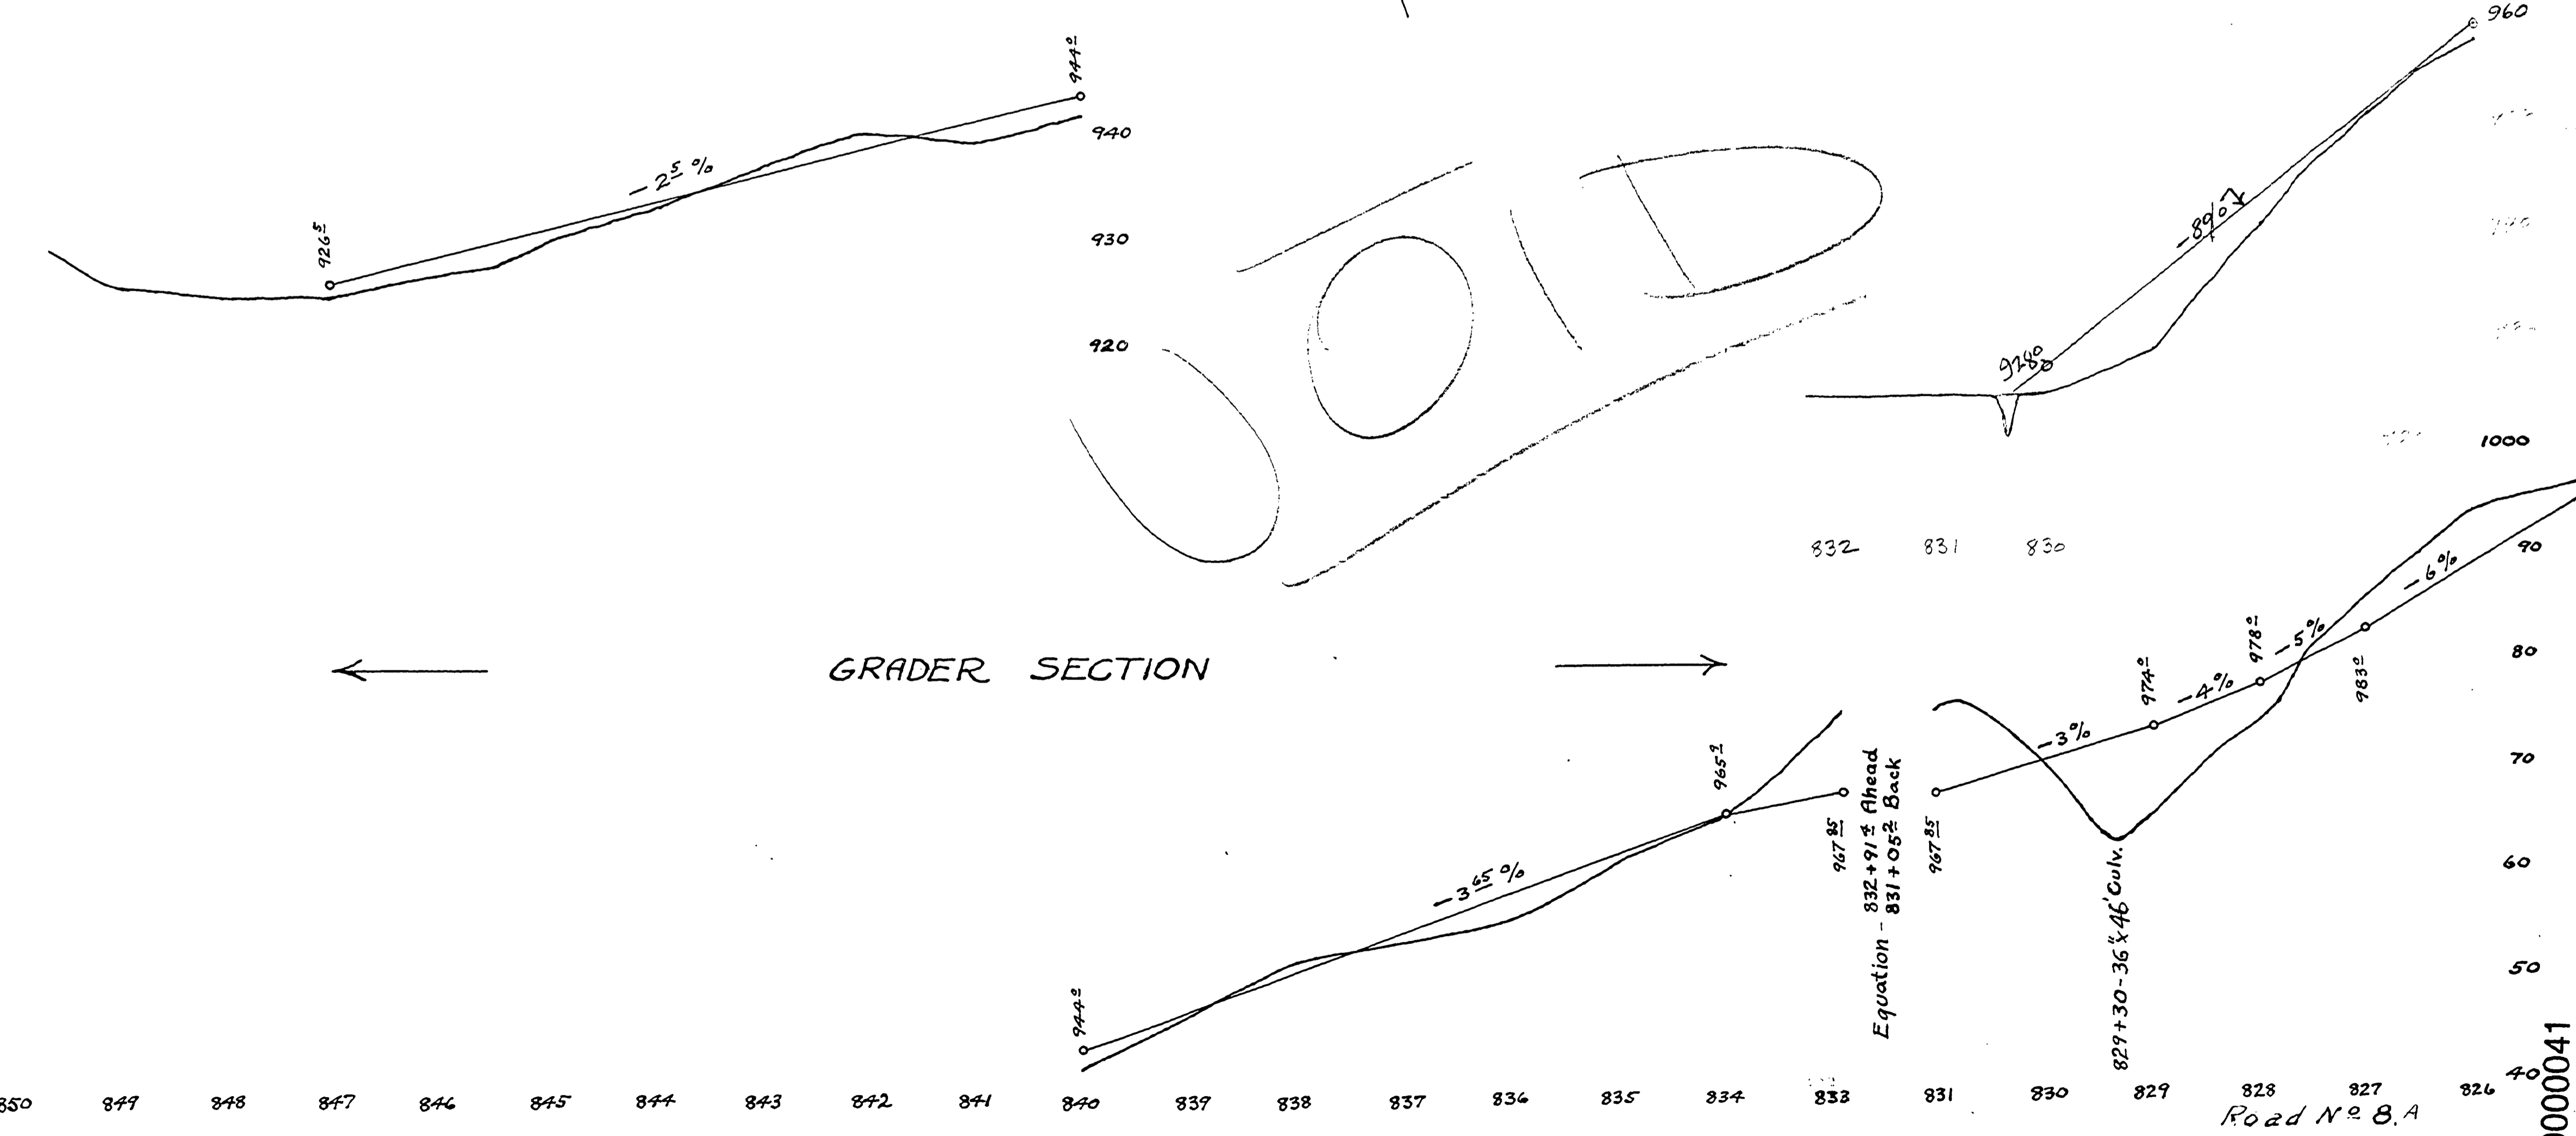

00000041