


DOUGLAS COUNTY HIGHWAY  
 IMPROVEMENT  
 PROFILE AND ALIGNMENT  
 ROCHESTER BRIDGE-ELKTON  
 YELLOW CREEK SECTION  
 SHEET No 9  
 SECTIONS 11, 12, 13, T. 24 S., R. 7 W. N. M.  
 STA. 30+80.3 TO STA. 60+18.7  
 OFFICE OF  
 F. C. FREAR  
 COUNTY ROADMASTER  
 MAY 1923  
 SCALE: HOR. 1 in. = 100 ft. VER. 1 in. = 10 ft.  
 SHEET 9



30 X

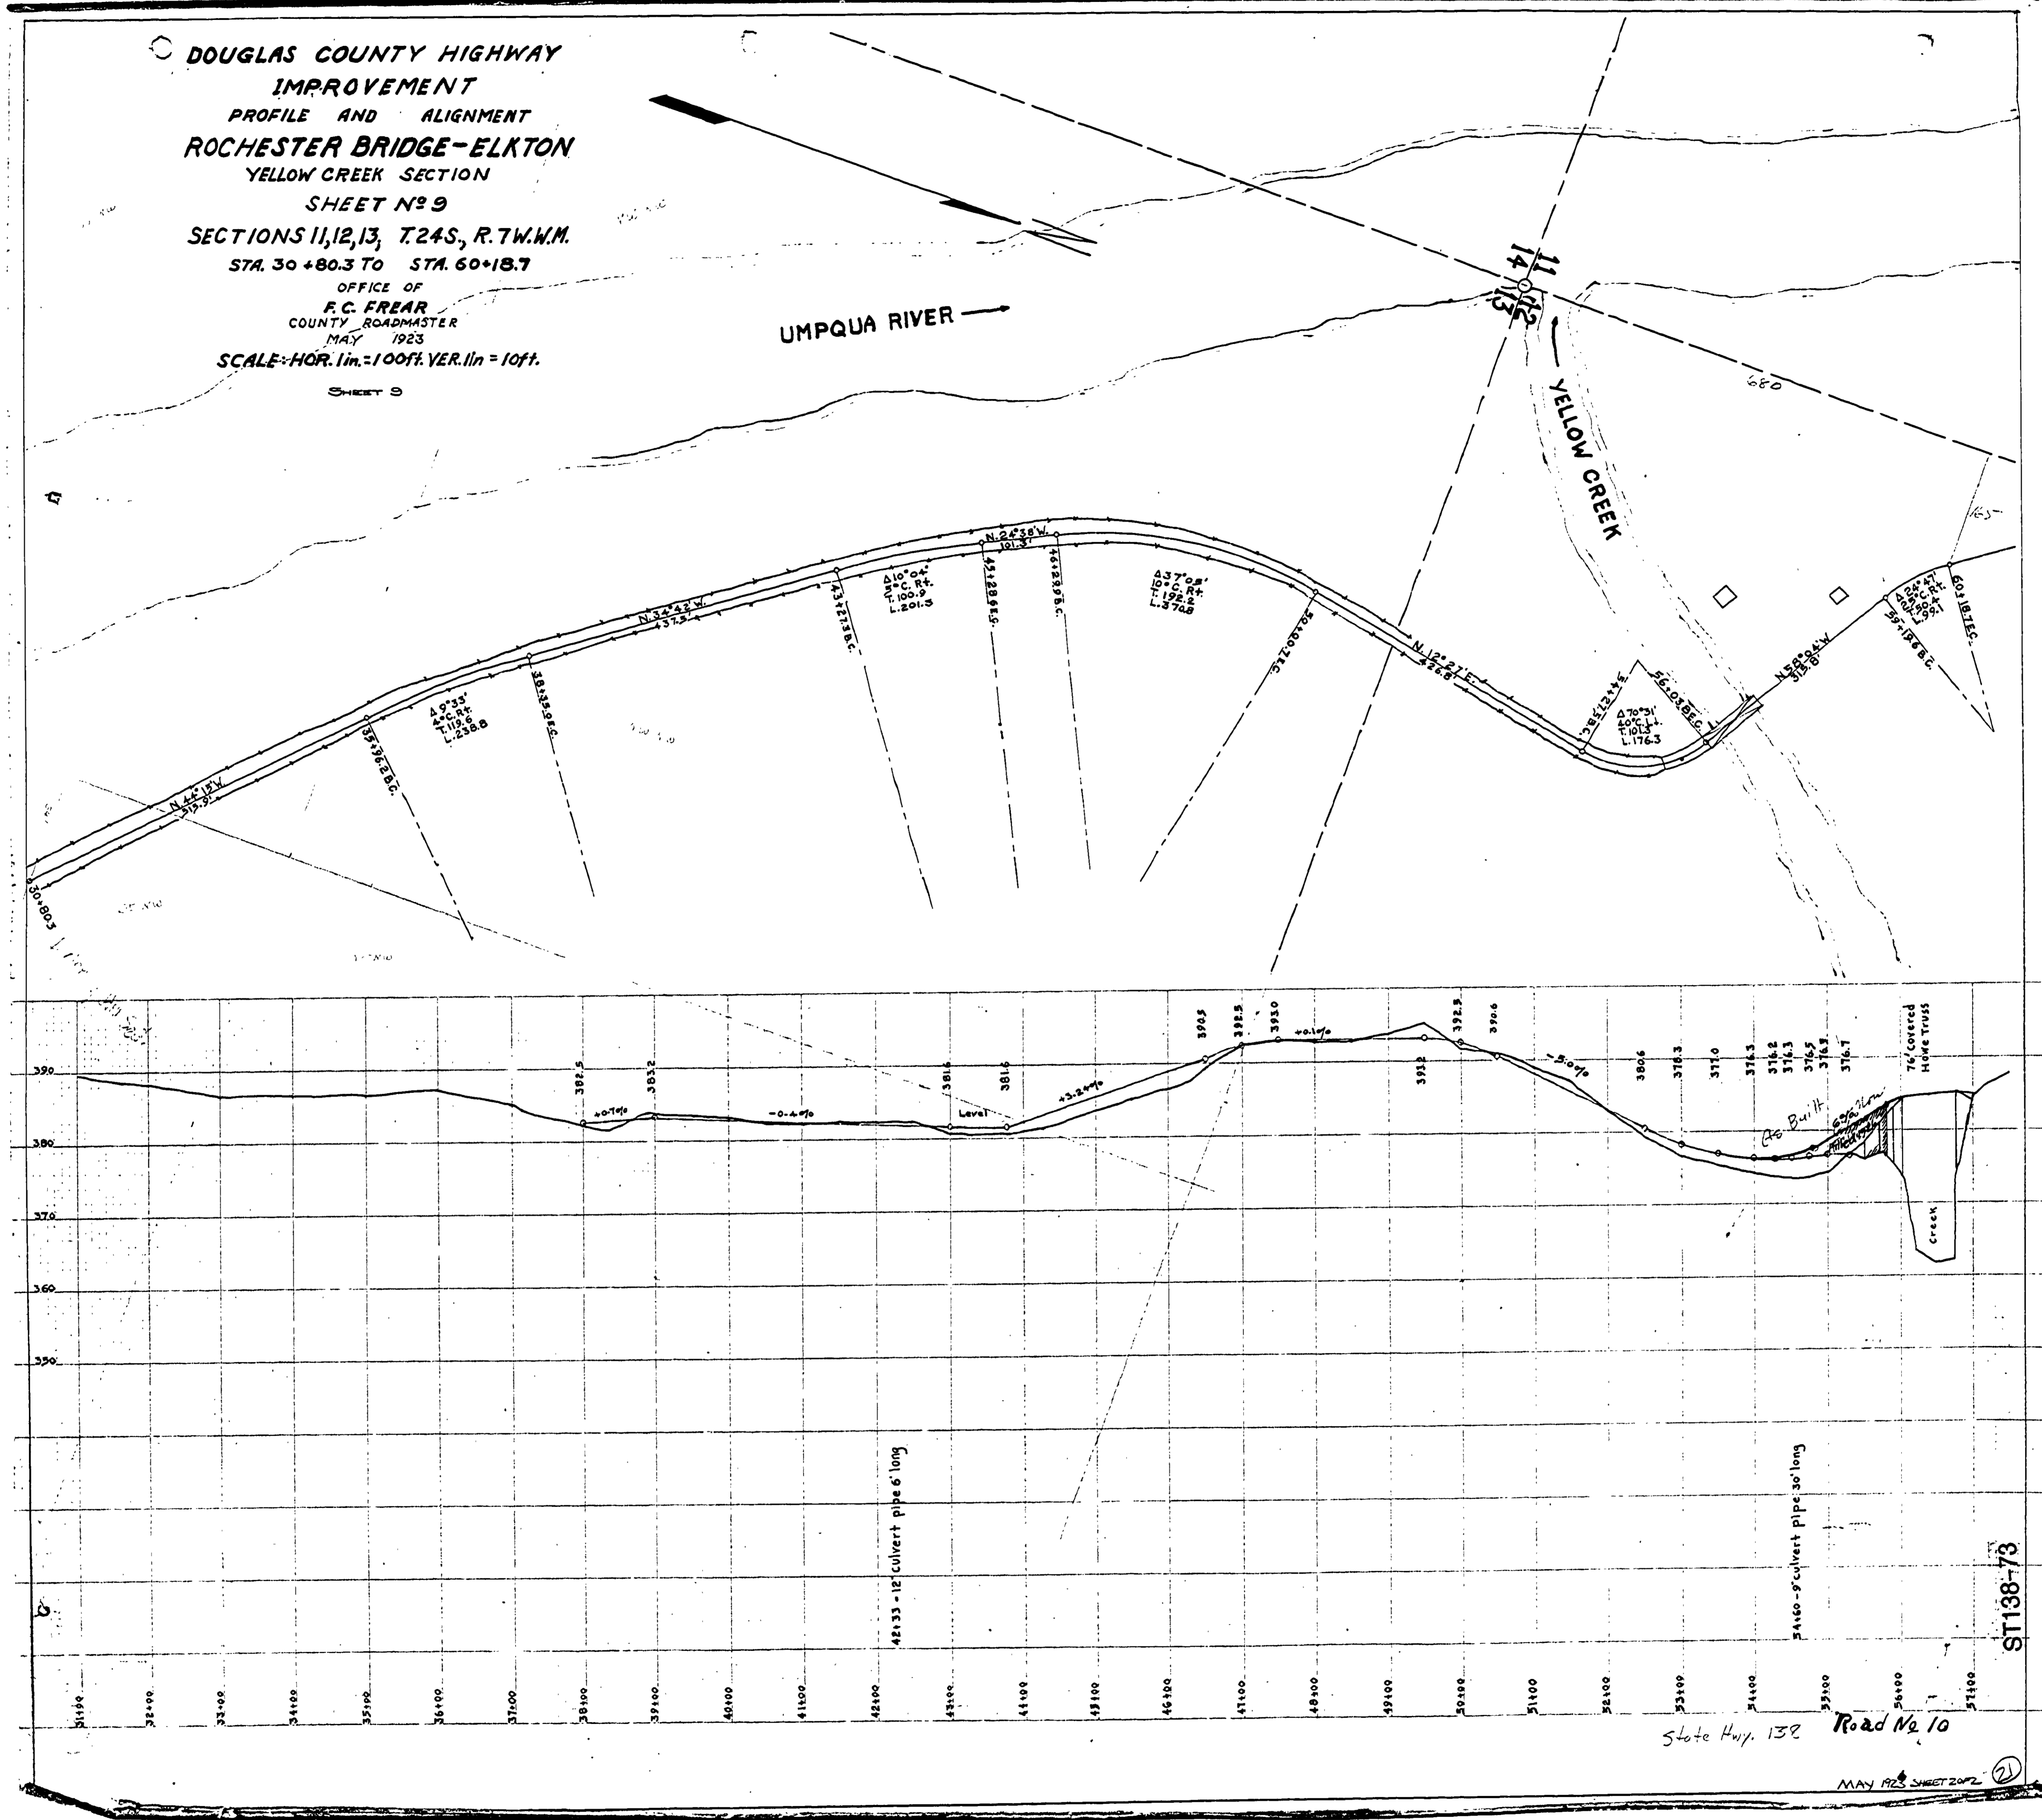