

**DOUGLAS COUNTY HIGHWAY
IMPROVEMENT
PROFILE AND ALIGNMENT
ELKTON PIAT "M" ROAD
MEHL CREEK HILL SECTION
SECTIONS 19 & 20, TWP 23S, R. 7W. W.M.**

STA. 0+00 TO STA. 66+01.5
OFFICE OF
F.C. FREAR
COUNTY ROADMASTER
JUNE 1921

SCALE: HOR. lin. = 200ft. VERTICAL lin. = 10ft.

MARKET ROAD No 11



CARLE HOWE TIMBER CO.

18 17
19 20

18

18
19 COR.

O.E.C. LAND

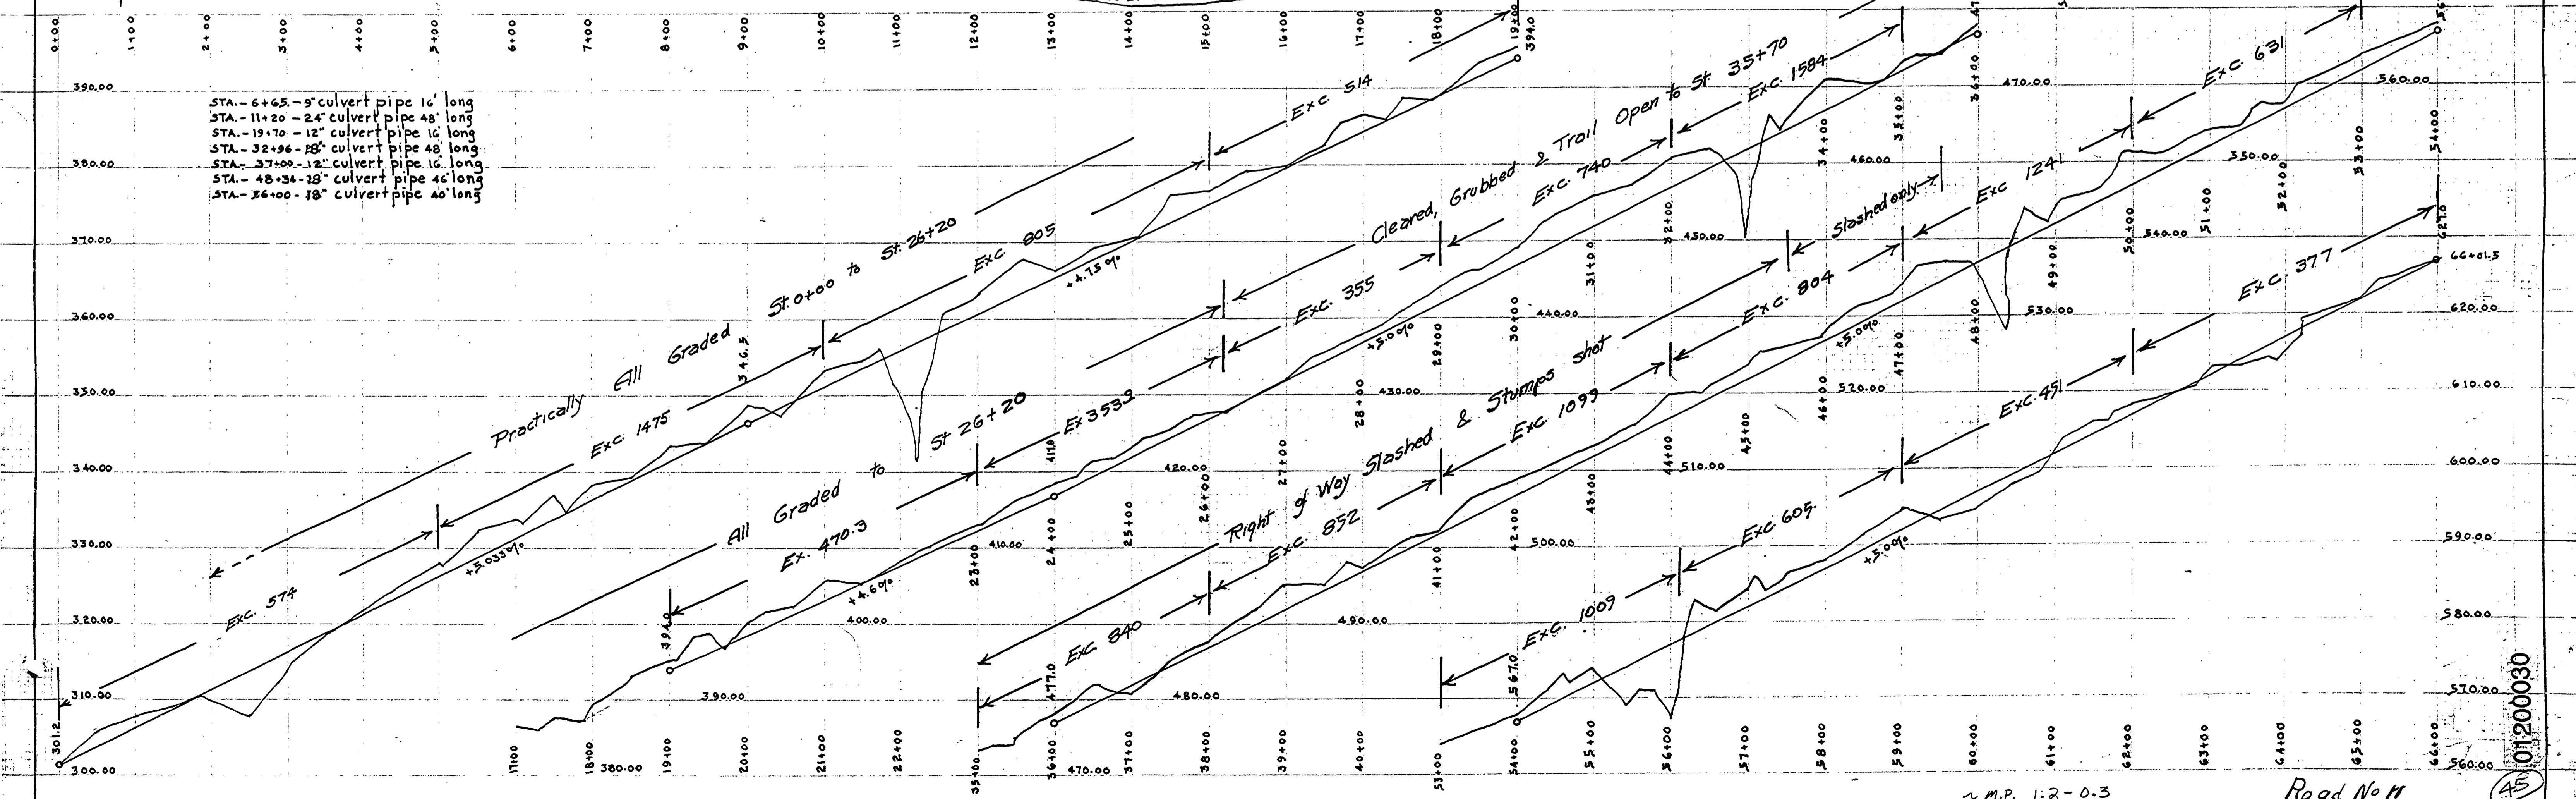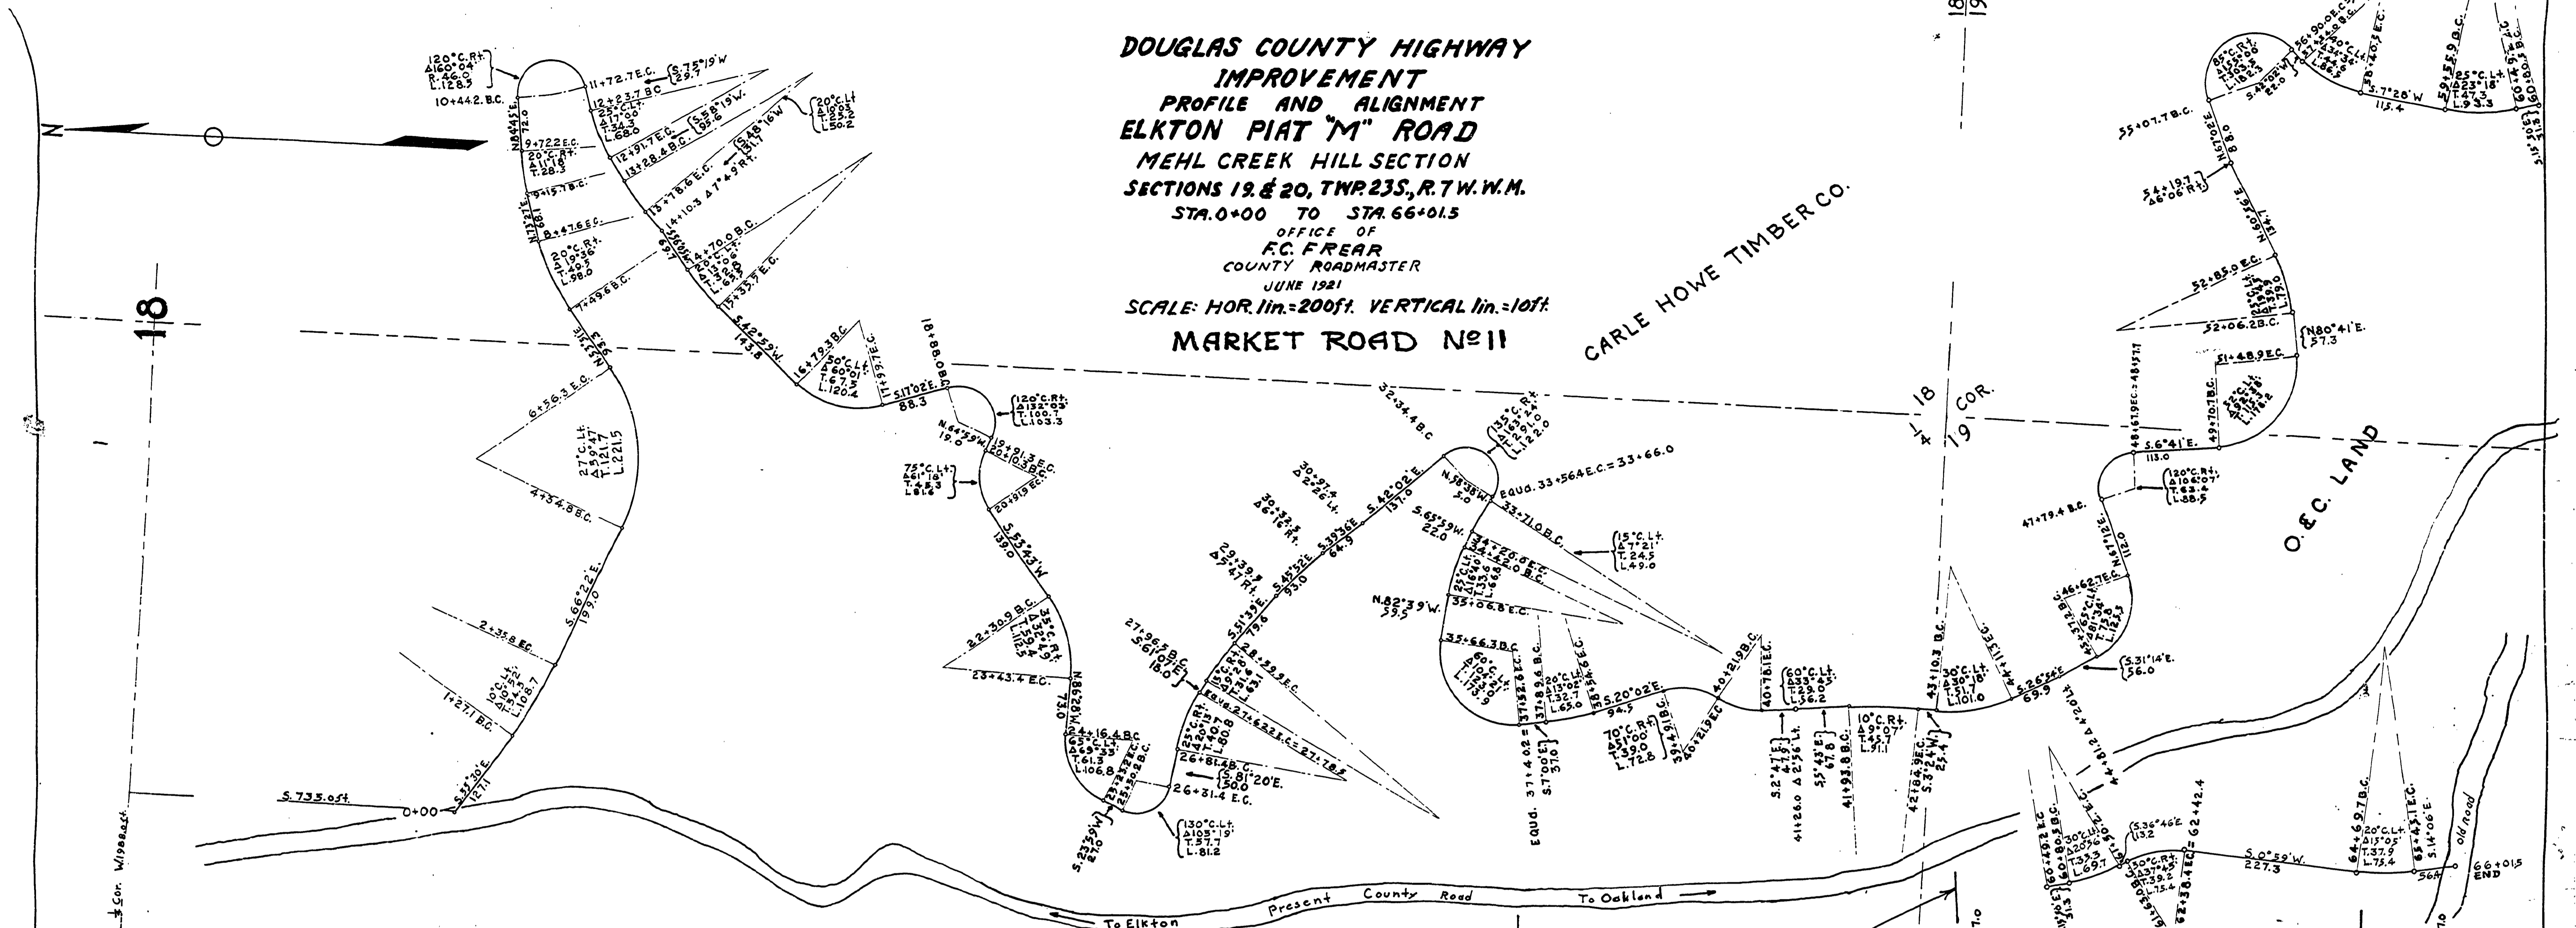

N.M.P. 1:2-0.3

Road No 11

T23-7 S. 12+19

JUNE 1921 1 SHEET

01200030