
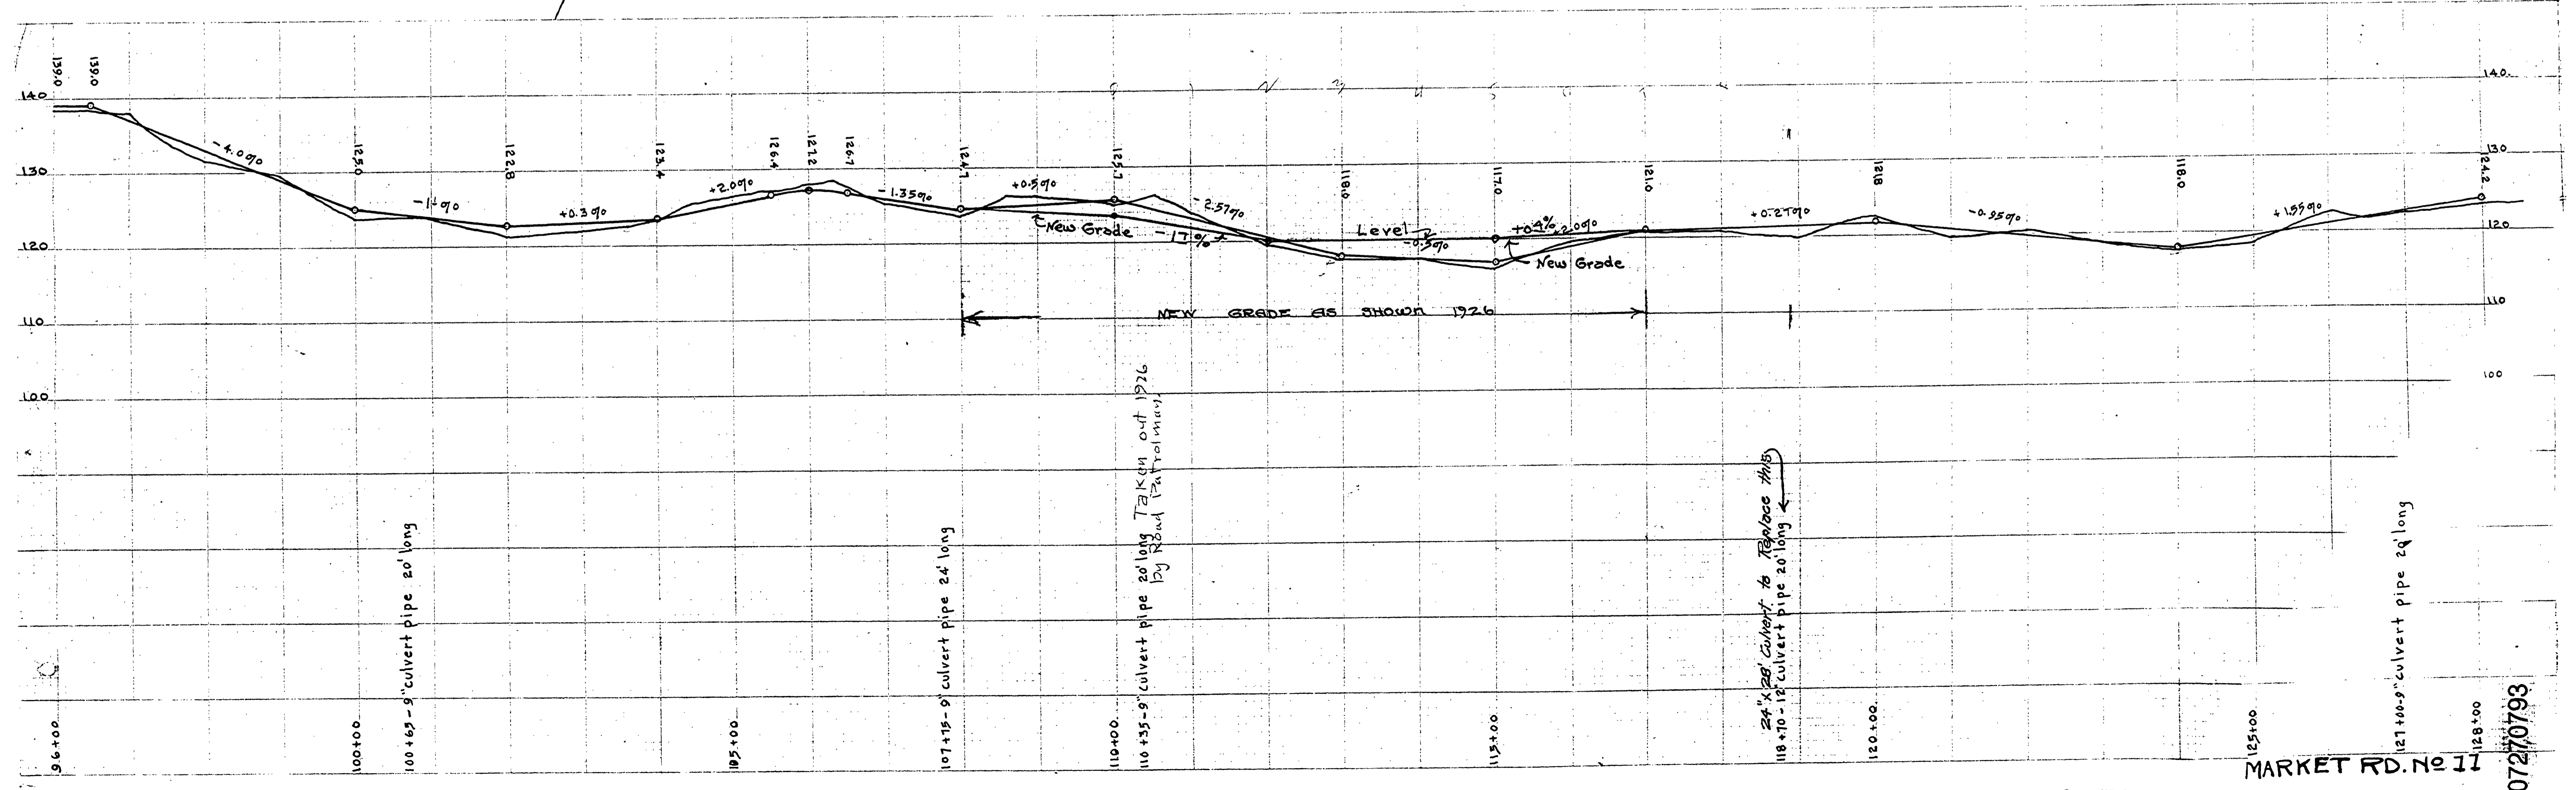


DOUGLAS COUNTY HIGHWAY
IMPROVEMENT
PROFILE AND ALIGNMENT
ELKTON PLAT M ROAD
BECKLEY SECTION
SECS. 35-36-31-30-19 & 29, TWP 22 S. R. 8-7 W.
STA. 101+50 TO STA. 136+16.5
OFFICE OF
F. C. FREAR
COUNTY ROADMASTER
SCALE: HOR. 1" = 100 FT. VER. 1" = 10 FT.
SHEET NO. 4

C. BECKLEY

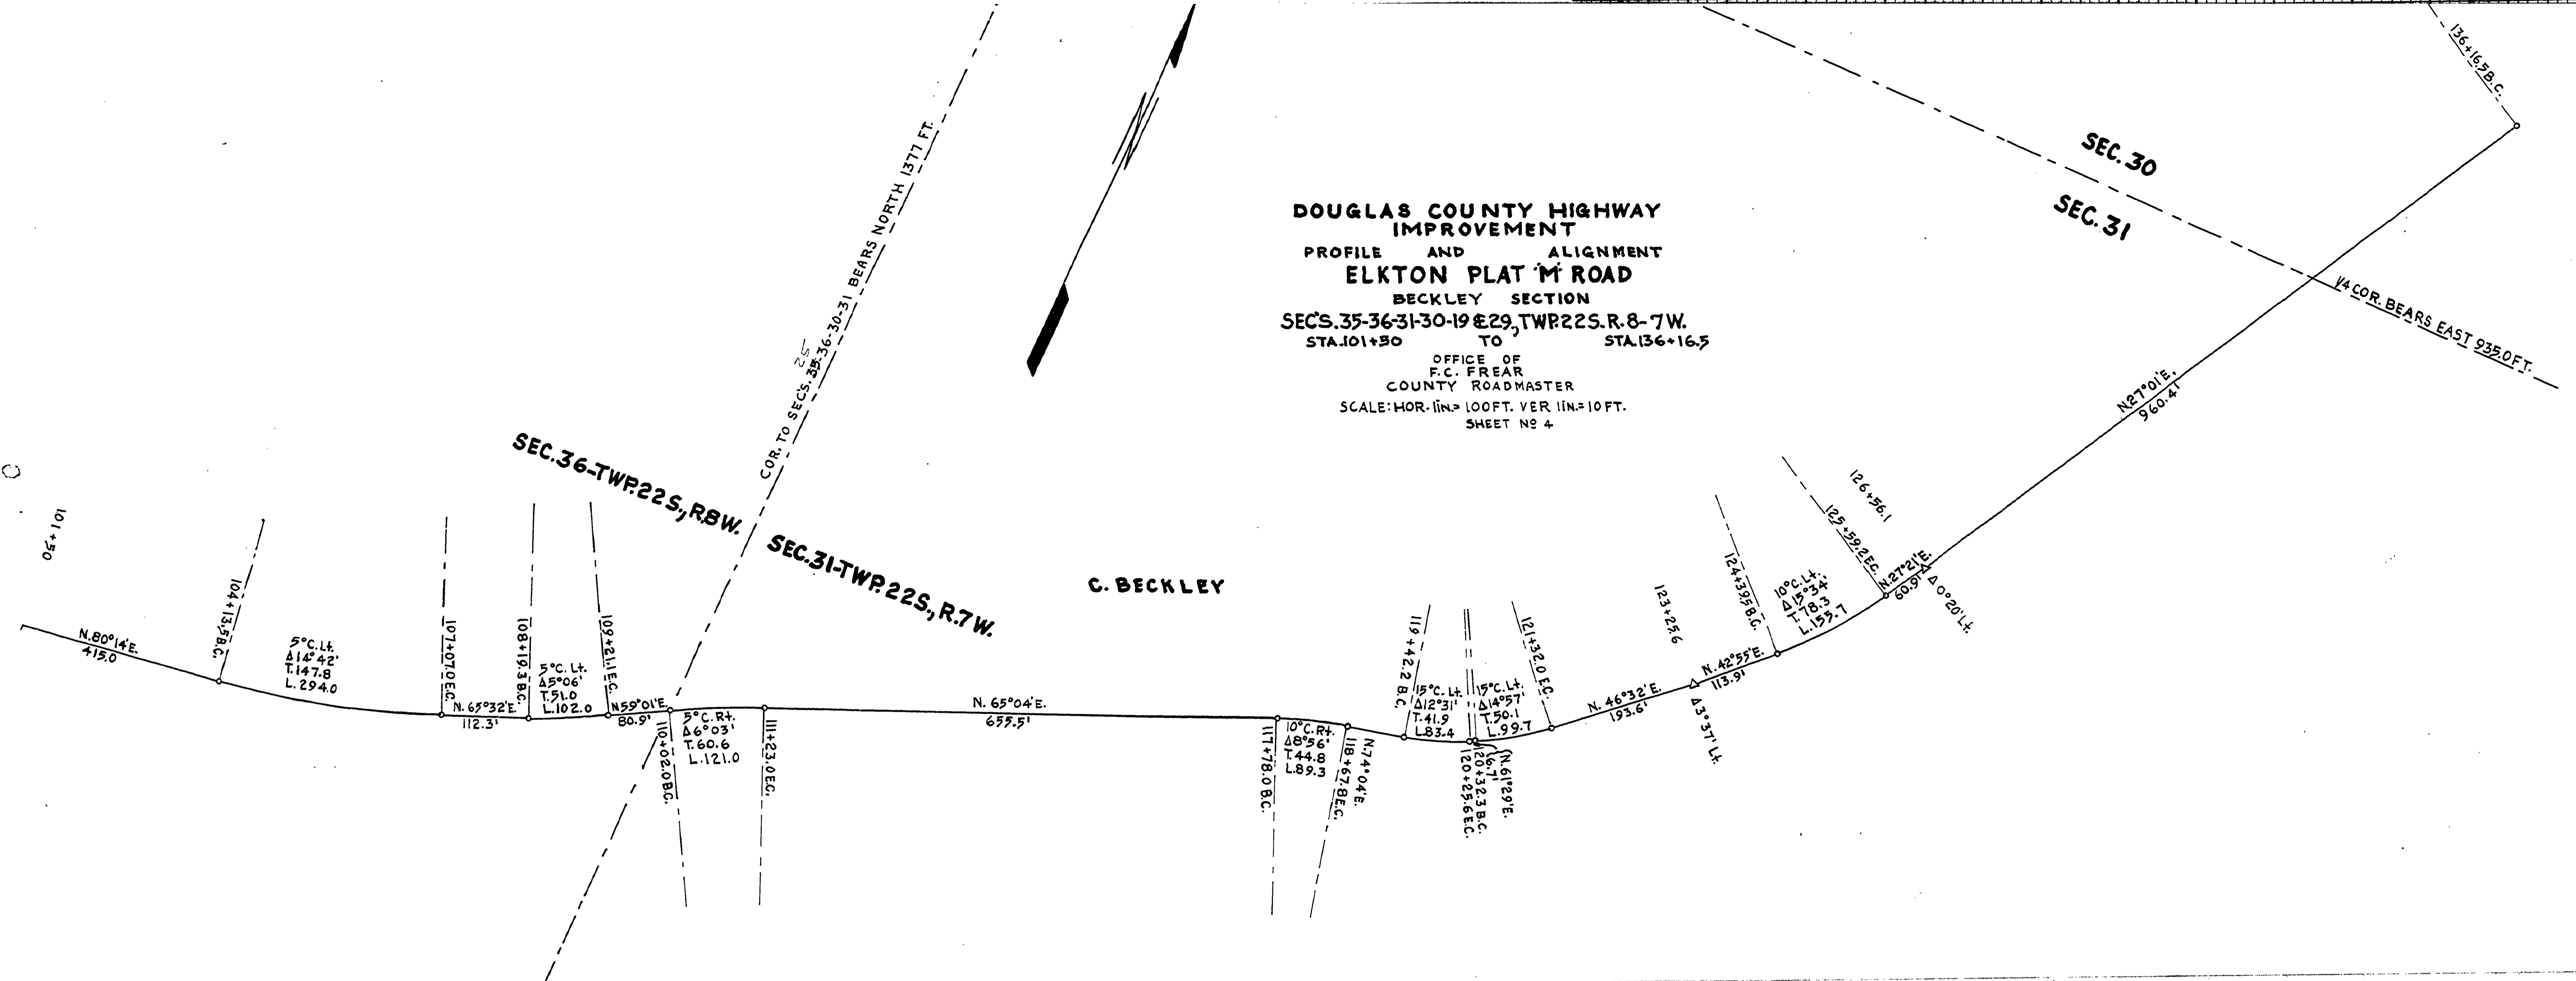

M.P. 7.27-7.93

MARKET RD. NO 11

T22-7 S. 30#31 NO DATE SHEET 4 OF 6

07210793