


DOUGLAS COUNTY HIGHWAY
IMPROVEMENT
 PROFILE AND ALIGNMENT
GLENDALE-PACIFIC HIGHWAY ROAD
MARKET ROAD NO. 12
 F.C. FREAR CO. ENGR.
 FEB 1926
 Garrett S.C.T.

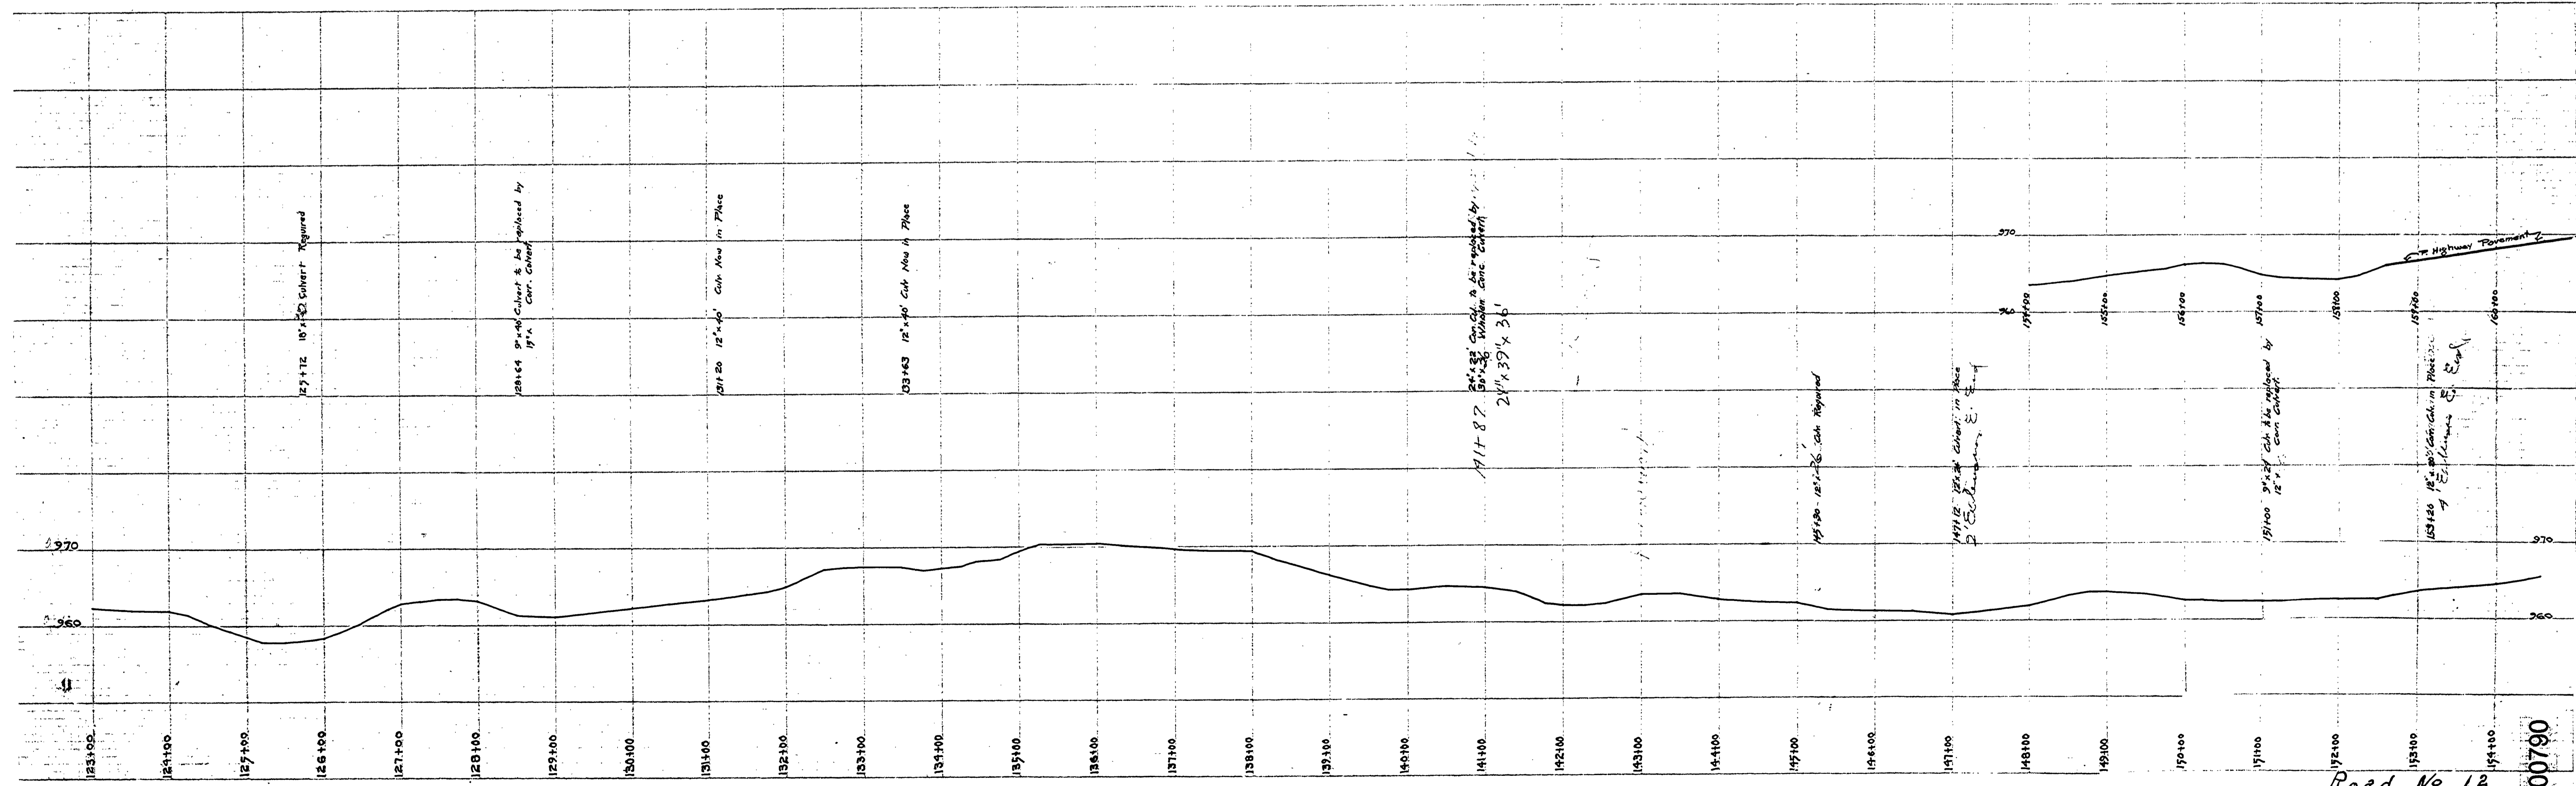

~M.P. 8.3-7.9

Road No 12

08300790
 108300790