

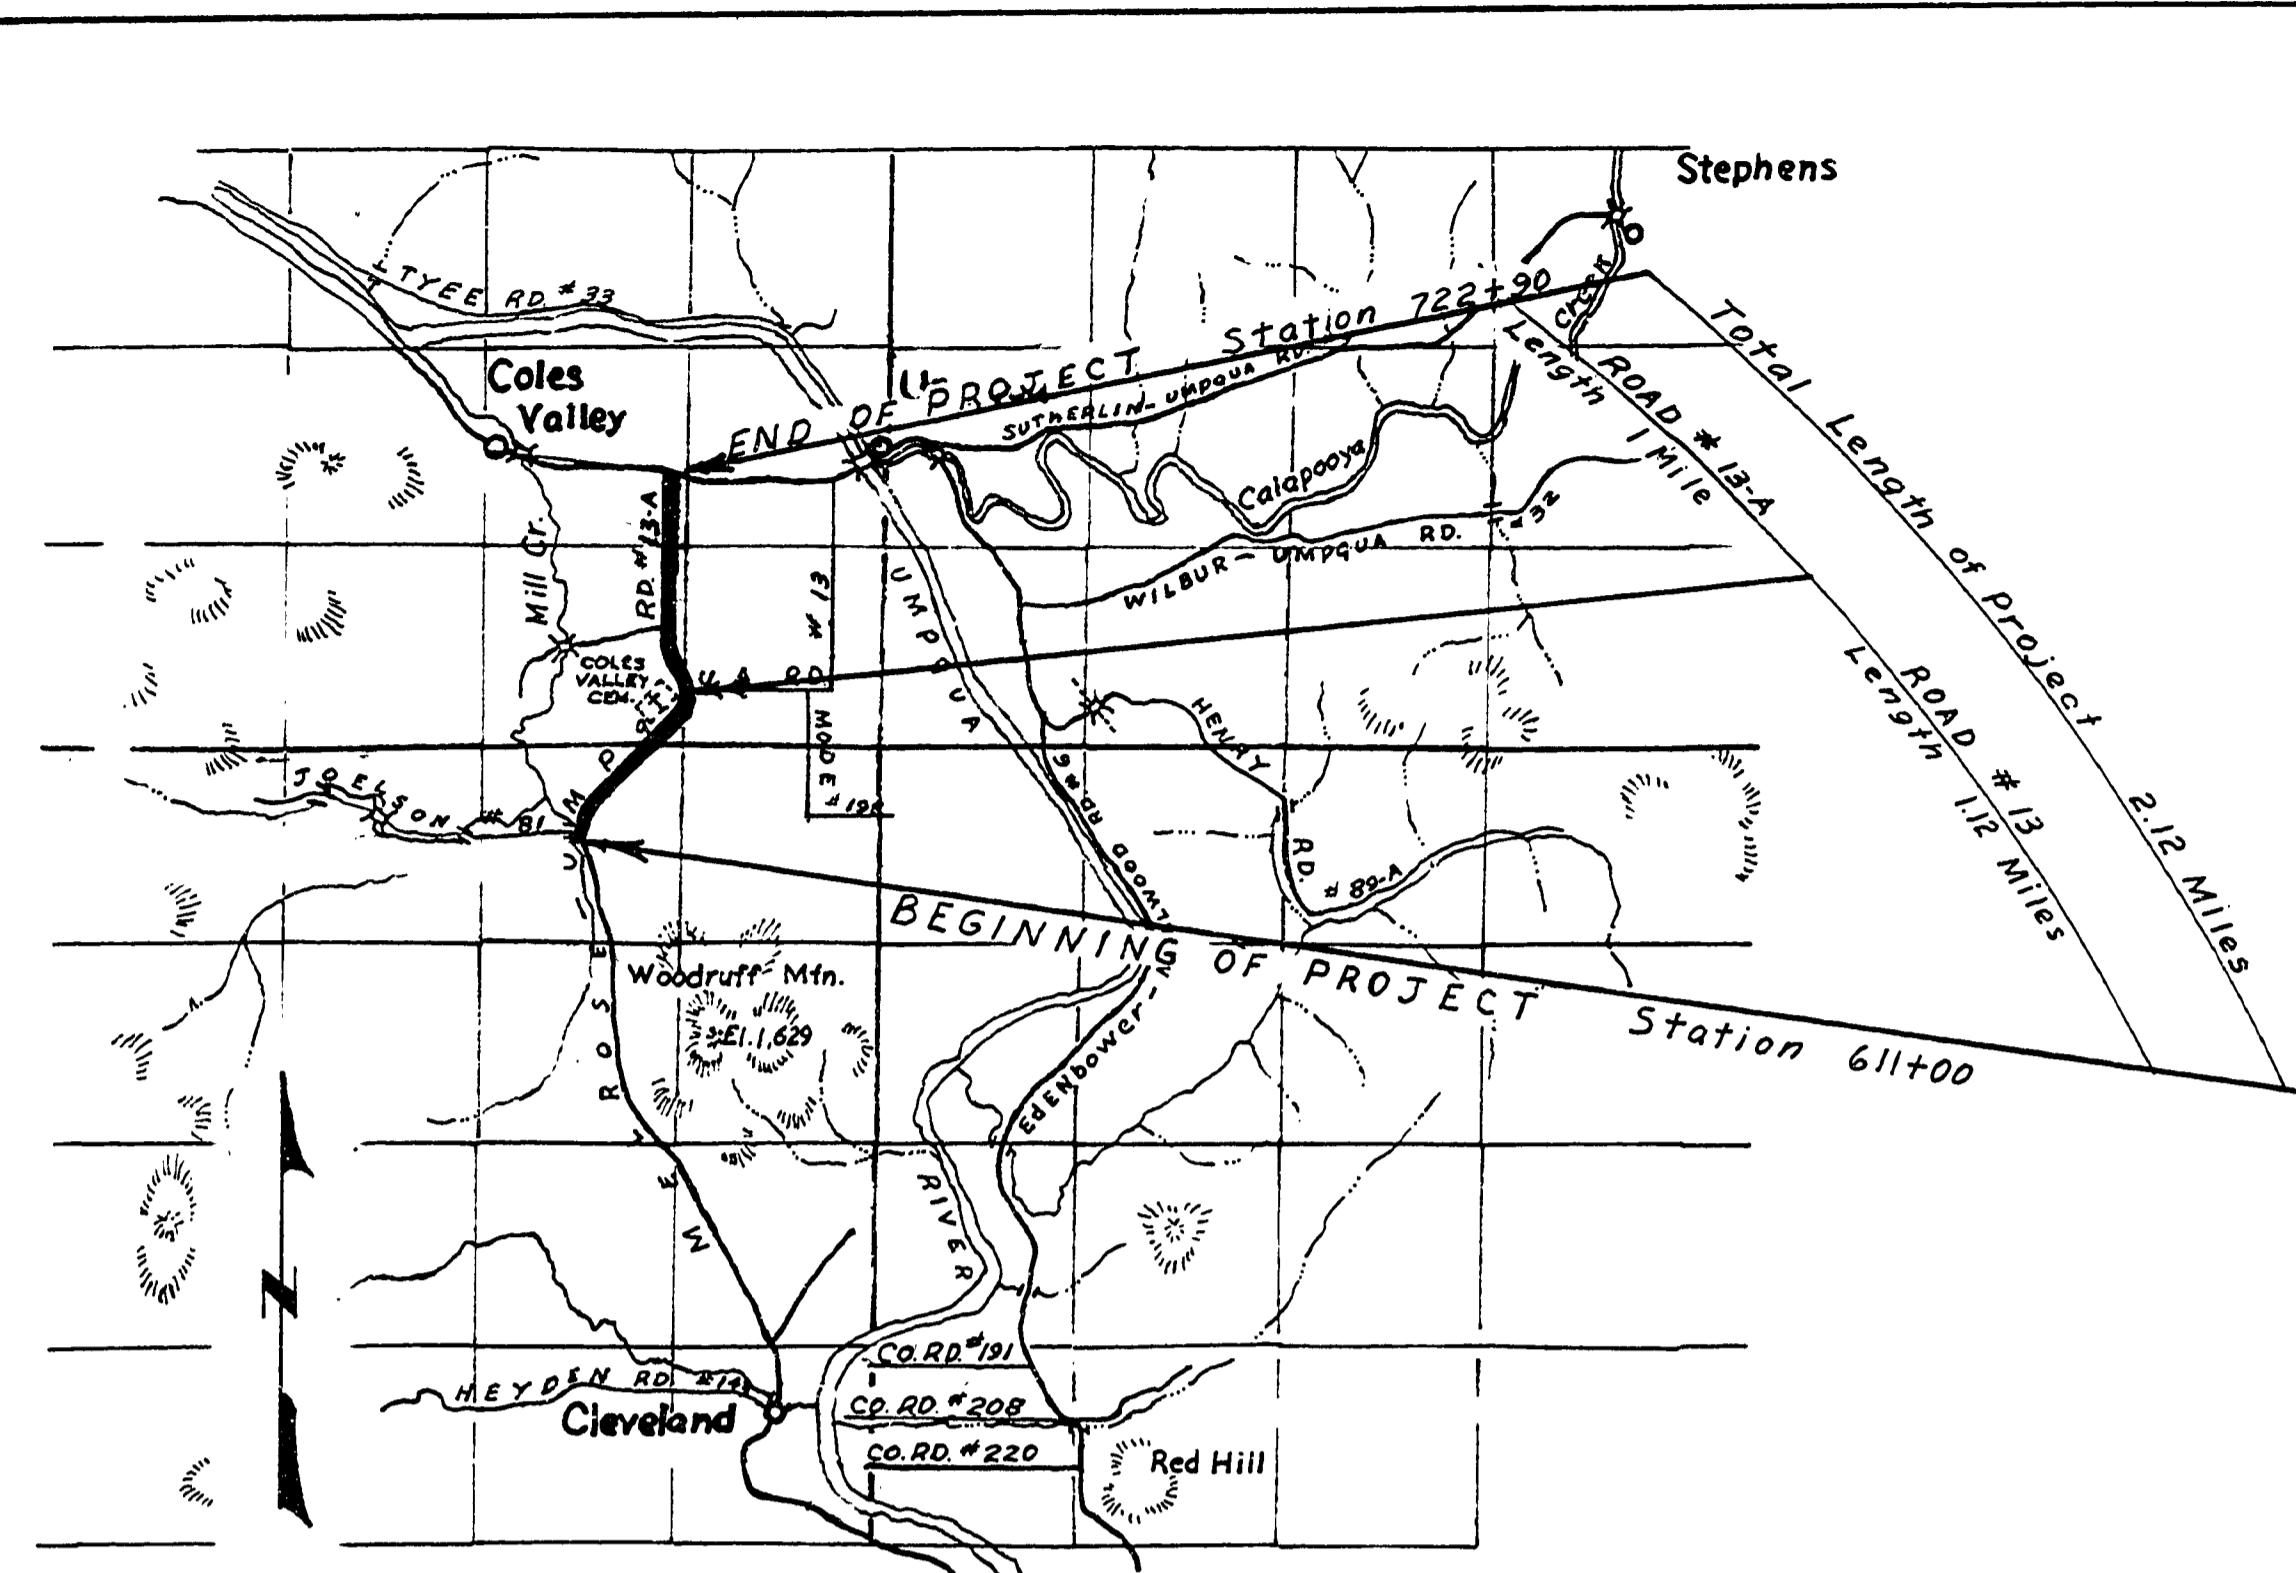
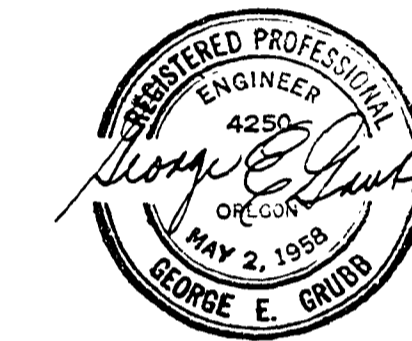



DOUGLAS COUNTY, OREGON
 Plans For Proposed Project
AS CONSTRUCTED
 ROSEBURG-MELROSE-UMPQUA
 and
 COLES VALLEY SECTION
 COUNTY ROAD NOS 13 & 13-A
 AUGUST 1961

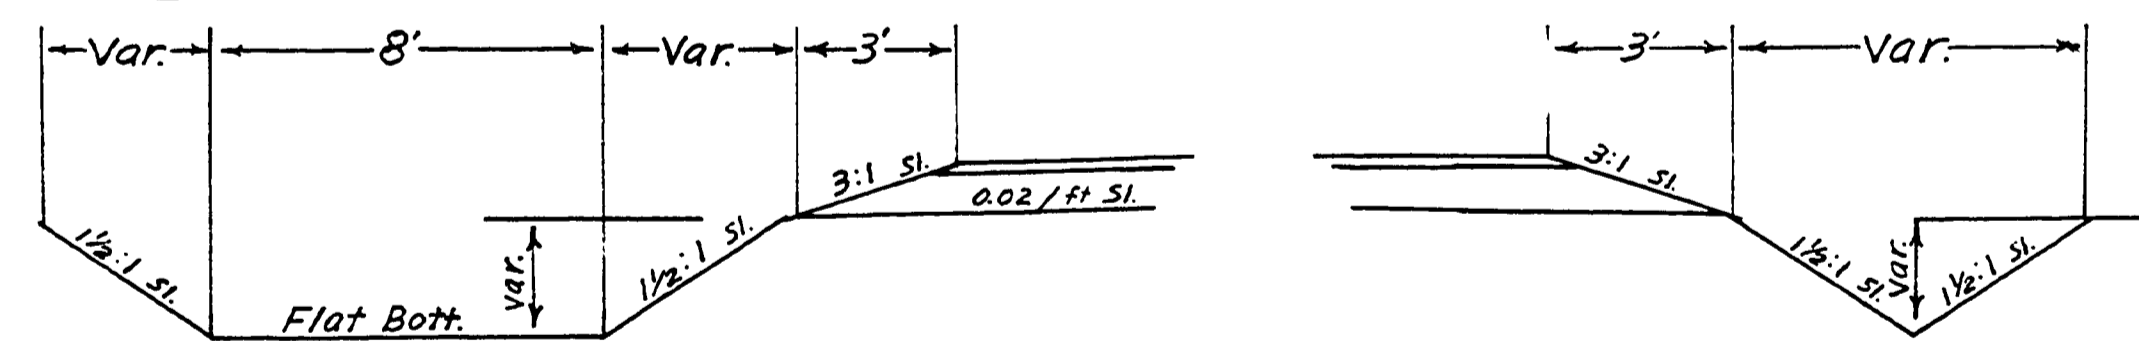

TYPICAL SECTIONS

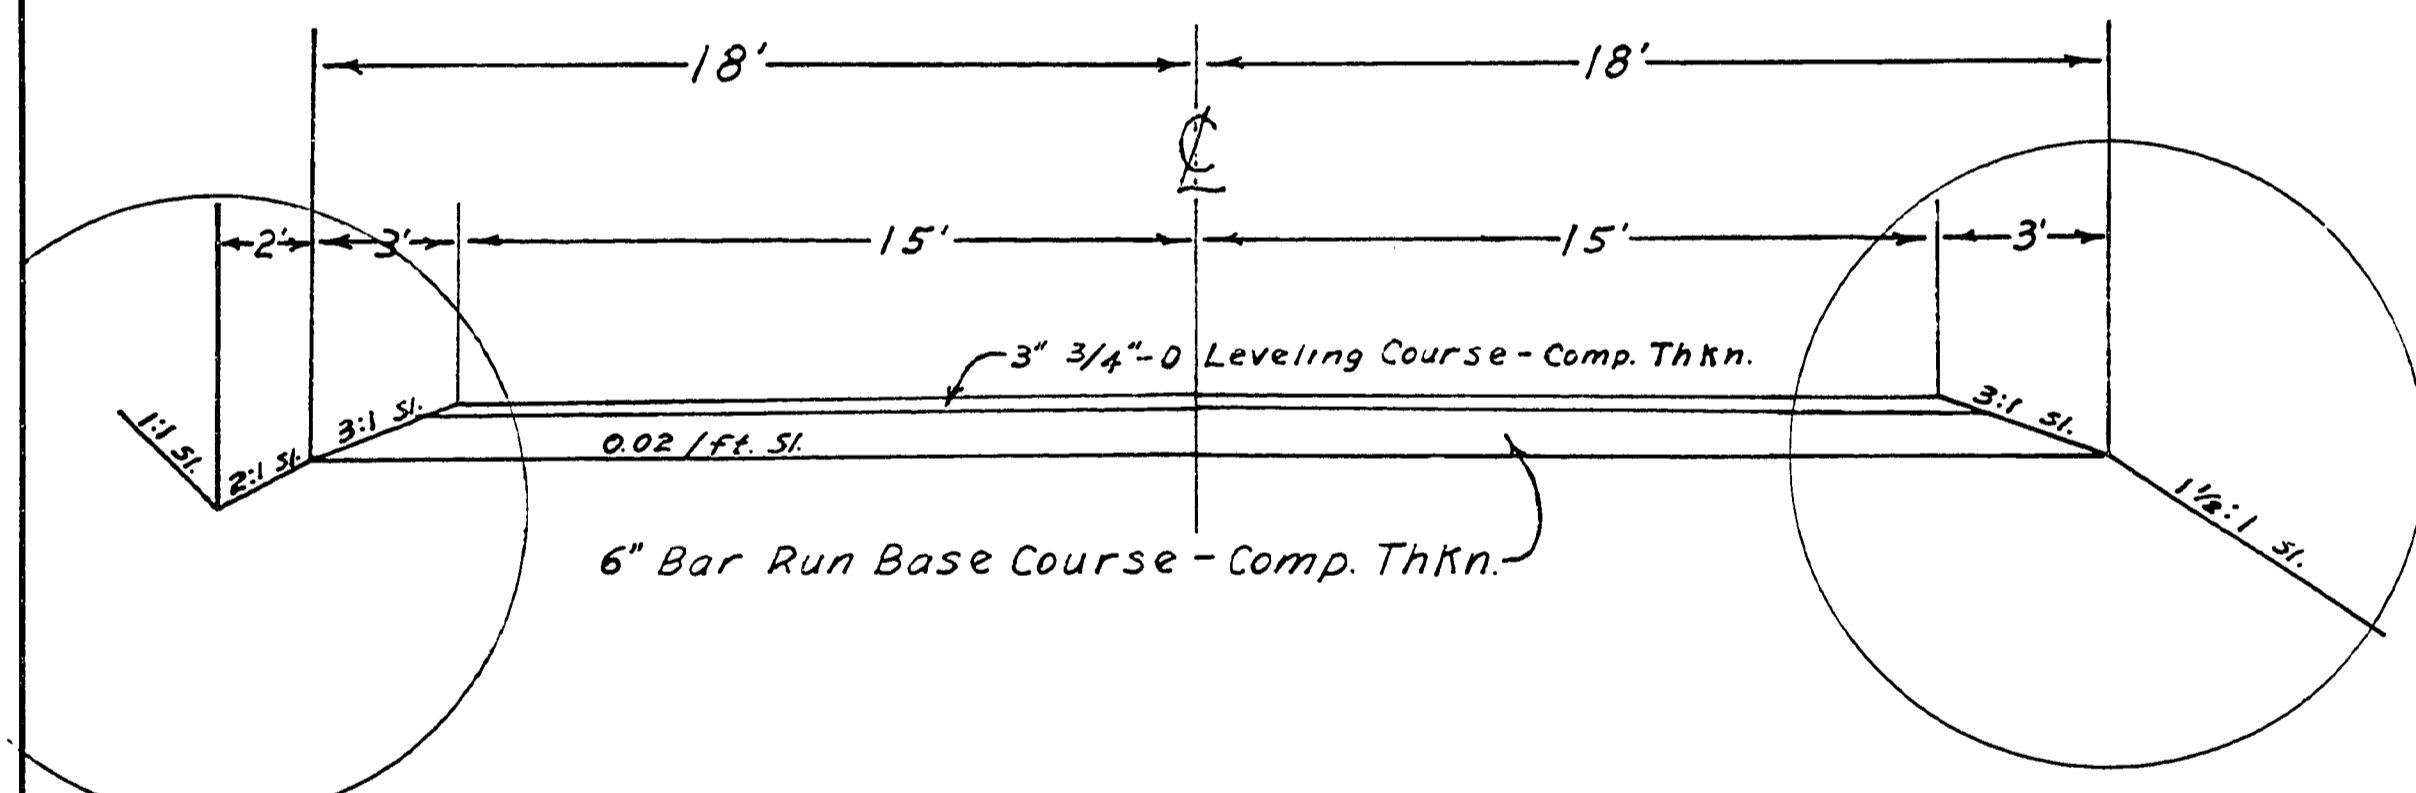

Flat Bottom ditch		Special V Bottom Ditch	
Sta.	to Sta.	Sta.	to Sta.
680+00	To 710+00	675+00	to 680+00
	(on Left only)	710+00	to 722+50
		675+00	to 710+00
			on Right

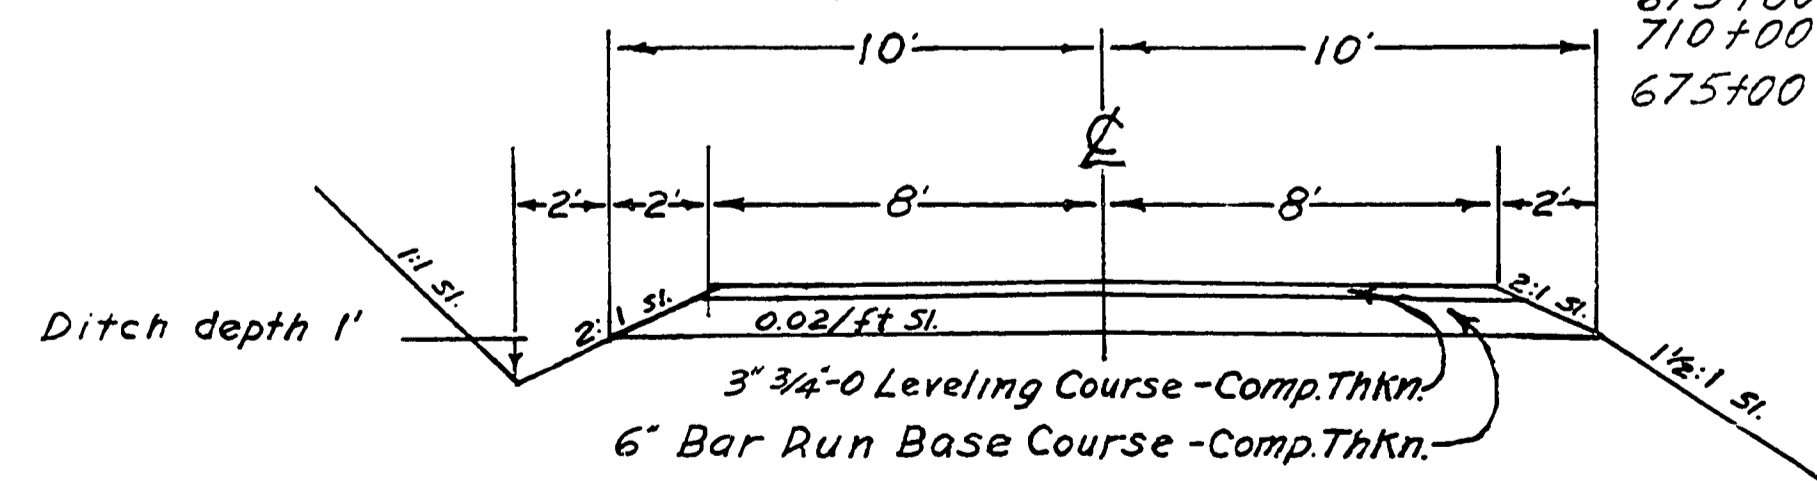

DRIVEWAY SECTION

FILED
 RECEIVED
 FEB 15 1962
 COUNTY SURVEYOR
 DOUGLAS COUNTY, ORE.

Rd. # 13 & 13-A Aug 1961 Sta. 1 of 5

1586168C

9